


BLOCK 4

CONCRETE CURB

UNION
STREET
(66' WIDE)

TELEPHONE
UTILITY
PEDESTAL

GAS
VALVE

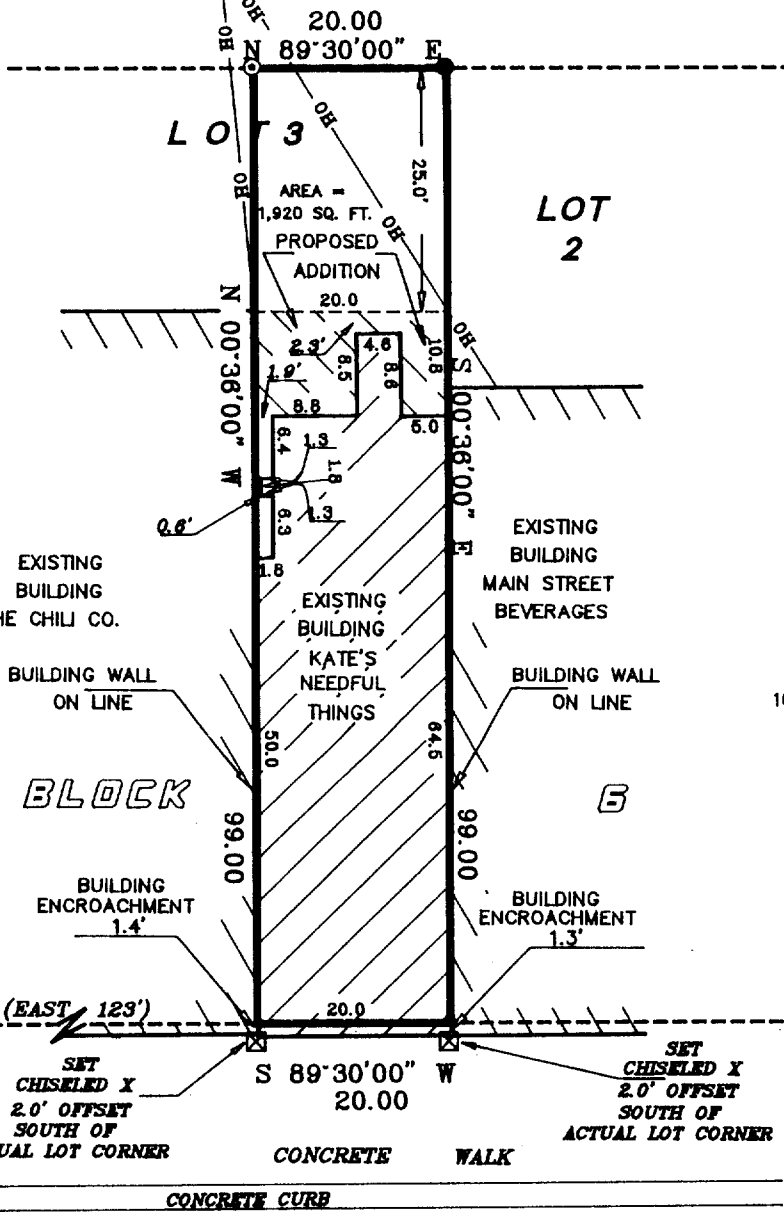

MAIN
STREET
(C.T.H. "ES")
(66' WIDE)

PLAT OF SURVEY


THE EAST 1/2 OF LOT 3, BLOCK 6 OF
THE ORIGINAL PLAT OF VILLAGE OF EAST TROY,
WALWORTH COUNTY WISCONSIN

THE EAST 1/2 OF LOT 3 IN BLOCK 6 IN THE VILLAGE OF EAST TROY,
WISCONSIN, SAID PREMISES ALSO BEING DESCRIBED AS FOLLOWS:
COMMENCING AT A STAKE STANDING 12 RODS NORTH AND 123 FEET
EAST OF THE SOUTHEAST CORNER OF SECTION 19, TOWN 4 NORTH,
RANGE 18 EAST, AND RUNNING THENCE NORTH 6 RODS; THENCE EAST
20 FEET; THENCE SOUTH 6 RODS; THENCE WEST 20 FEET TO THE
PLACE OF BEGINNING.

BEARINGS REFERENCED TO THE
SOUTH LINE OF UNION STREET
RECORDED AS: N 89°30' E

LEGEND

- ⊙ - FOUND IRON ROD
- - SET RAILROAD SPIKE
- ⊙ - POWER POLE
- OH — OVERHEAD WIRES
- ⊠ - CHISELED X
- () - RECORDED AS

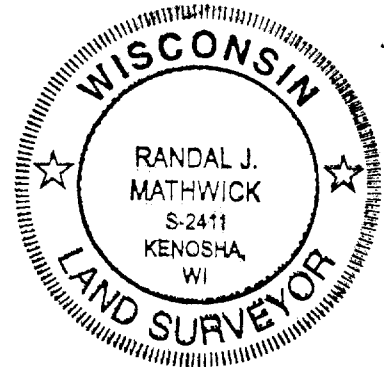

NOTE: COPIES OF THIS MAP TO WHICH THE FOLLOWING CERTIFICATE
WILL APPLY ARE PRINTS SHOWING SURVEYOR'S ORIGINAL SEAL
AND SIGNATURE IN BLACK INK. COPIES BY ANY OTHER MEANS
MAY HAVE ALTERATIONS WHICH DO NOT REPRESENT THE SURVEYOR'S
WORK PRODUCT.


I HEREBY CERTIFY THAT THE ABOVE DESCRIBED PROPERTY HAS BEEN
SURVEYED UNDER MY DIRECTION AND THAT THE ABOVE MAP IS A TRUE
REPRESENTATION THEREOF AND SHOWS THE SIZE AND LOCATION OF
THE PROPERTY AND ITS EXTERIOR BOUNDARIES. THIS SURVEY IS
MADE FOR THE USE OF THE PRESENT OWNERS OF THE PROPERTY, AND
ALSO THOSE WHO PURCHASE, MORTGAGE, OR GUARANTEE THE TITLE
THERE TO WITHIN ONE YEAR FROM THE DATE HEREOF.

DATED: JULY 30, 1998

Randal J. Mathwick
RANDAL J. MATHWICK

R.L.S. 2411

19-20
30-29
Rop-60
003-868

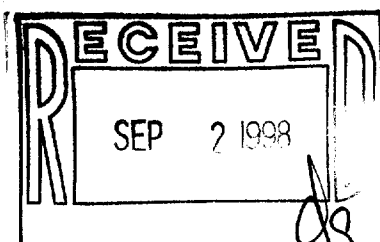

FARRIS, HANSEN & ASSOCIATES, INC.
Engineering, Architecture, Surveying
7 Ridgeway Court P.O. Box 437
Kenosha, Wisconsin 53140
Office (414) 733-8888 Fax (414) 733-8888

WORK ORDERED BY:
KATE BEHRENS
KATE'S NEEDFUL THINGS
W 2216 WILMER GROVE ROAD
EAST TROY, WISCONSIN 53120

LOT SURVEY
2206 MAIN STREET
EAST TROY, WISCONSIN

