

RESURVEY OF LOT 2

FARRIS, HANSEN & ASSOC. INC.

CERTIFIED SURVEY NO. 2639

7 RIDGWAY COURT - P. O. BOX 437 ELKHORN,
WISCONSIN 53121

RECORDED IN VOLUME 13 OF CERTIFIED SURVEY
MAPS ON PAGE 184 AS
DOCUMENT NO. 313751

PHONE (414) 723-2088

FAX (414) 723-5886

PROJECT NO. 2318.95

LOCATED IN THE NE 1/4 OF THE SE 1/4 AND IN THE NW 1/4 OF THE SE 1/4 OF
SECTION 20, TOWN 4 NORTH, RANGE 18 EAST, VILLAGE OF EAST TROY, WALWORTH
COUNTY, WISCONSIN - THIS MAP DIVIDES LOT 2 OF CSM 1396 INTO TWO PARCELS



N
PLAT NORTH
STATE PLANE GRID NORTH

DEC 07 MIN 10 SEC

100 50 0 100 200 300 400
MAP SCALE IN FEET ORIGINAL 1" = 100'

- O = SURVEY STAKE FOUND OR SET (SEE LETTER TYPE BELOW)
- A = FOUND IRON PIPE STAKE 1 INCH DIA
- B = FOUND IRON REBAR STAKE 3/4 INCH DIA
- C = SET IRON REBAR STAKE 3/4 DIA X 24 X 1.2 LB/FT
- D = FOUND CONCRETE COUNTY SECTION MONUMENT
- E = FOUND IRON PIPE STAKE 2 INCH DIA
- F = FOUND METAL PLATE SECTION MARKER IN PAVEMENT

1998 RESURVEY ORDERED BY:
BRUCE BAHRMASEL
C/O HAUDEC LAW OFFICES
PO BOX 187
EAST TROY, WI 53120

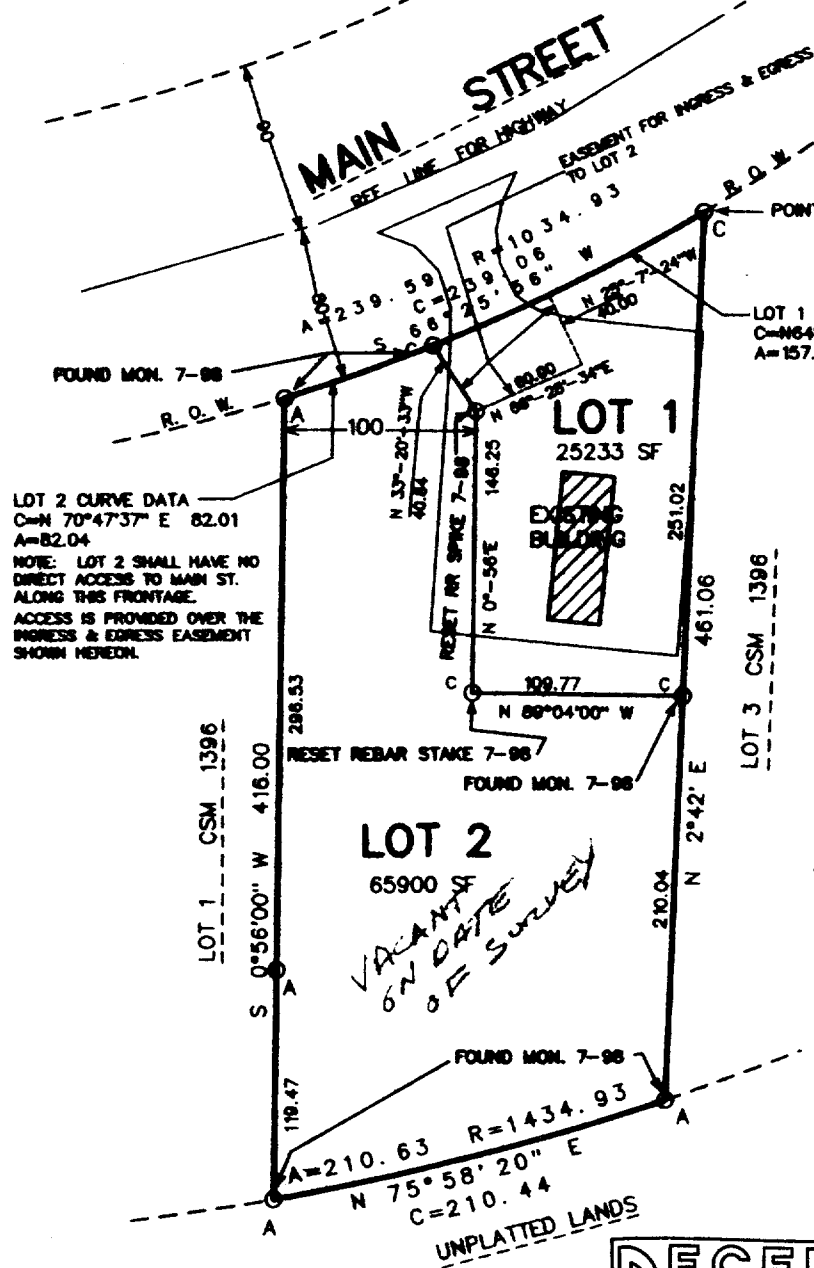
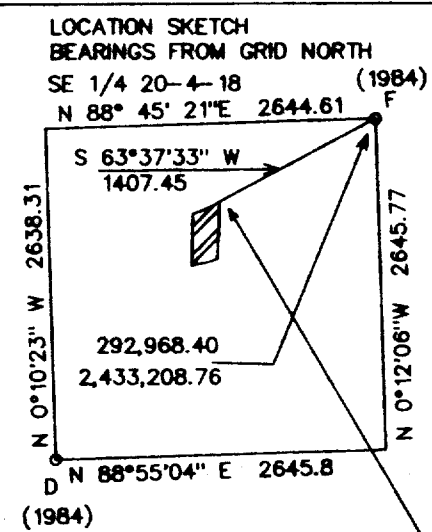


NOTE: COPIES OF THIS MAP TO WHICH THE FOLLOWING CERTIFICATE
WILL APPLY ARE BLUE LINE PRINTS SHOWING SURVEYOR'S ORIGINAL
SEAL AND SIGNATURE IN BLACK INK. COPIES BY ANY OTHER MEANS
MAY HAVE ALTERATIONS WHICH DO NOT REPRESENT THE SURVEYOR'S
WORK PRODUCT.

I HEREBY CERTIFY THAT THE ABOVE DESCRIBED PROPERTY HAS BEEN
SURVEYED UNDER MY DIRECTION AND THAT THE ABOVE MAP IS A TRUE
REPRESENTATION THEREOF AND SHOWS THE SIZE AND LOCATION OF
THE PROPERTY AND ITS EXTERIOR BOUNDARIES. THIS SURVEY IS
MADE FOR THE USE OF THE PRESENT OWNERS OF THE PROPERTY, AND
ALSO THOSE WHO PURCHASE, MORTGAGE, OR GUARANTEE THE TITLE
THEREIN WITHIN ONE YEAR FROM THE DATE HEREOF.

DATED: 7-28-98

PETER S. GORDON - RLS 2101

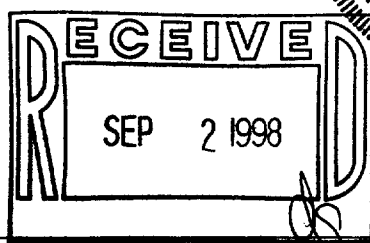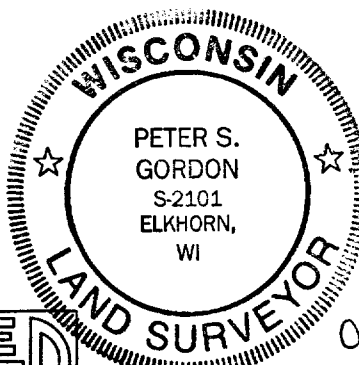

003-569

RA-2639-1
RA-2639-2

SHEET 1 OF 1 SHEETS

DATED: 5/24/95
REVISED: 6/24/95 REVISED: 9/07/95