
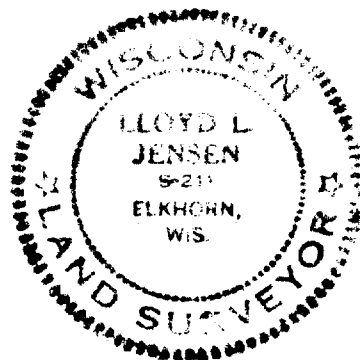


PLAT OF SURVEY

OF

PART OF LOTS 1, 2, AND 3 BLOCK 1
ORIGINAL PLAT, VILLAGE OF EAST TROY,
WALWORTH COUNTY, WISCONSIN.

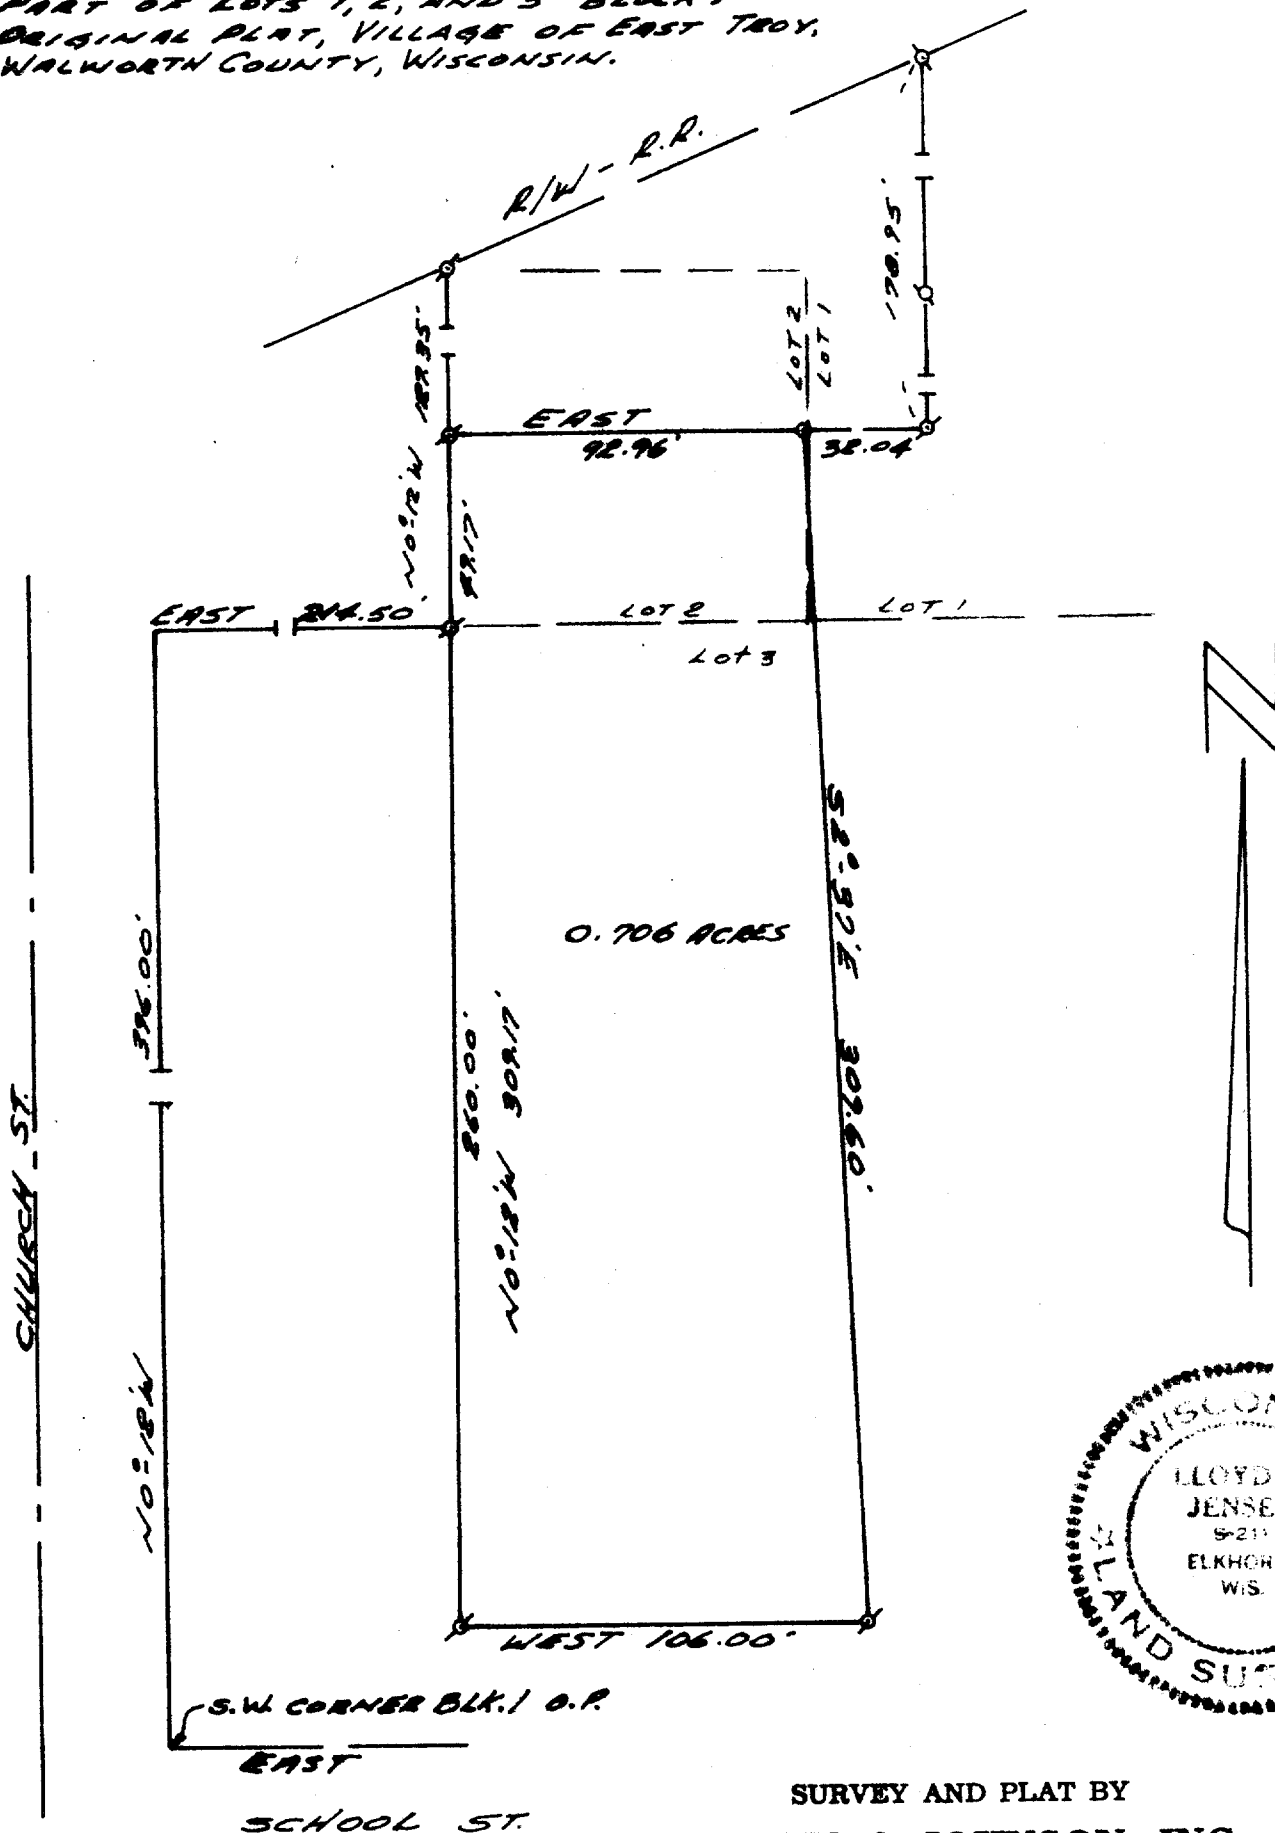

SURVEY AND PLAT BY
JENSEN & JOHNSON, INC.
CIVIL ENGINEERS AND SURVEYORS
Elkhorn, Wisconsin

LEGEND

- — Iron Pipe SET
- — Concrete Monument
- Scale 1" = 50'
- S — IRON PIPE FOUND

WE CERTIFY: That we have surveyed the above described property and that the plat shown hereon is an accurate survey and a true representation thereof and correctly shows the exterior boundary lines and all divisions of said property.

Date MAY 6, 1921

Lloyd L. Jensen
LLOYD L. JENSEN,

Wisconsin Registered Land Surveyor, No. S-211

3-573J