

SUBDIVIDING
LOT SURVEYS

KUOKKANEN & ASSOCIATES, INC.

BUILDING SURVEYS
LAND DIVISIONS

910 ELM GROVE RD.
ELM GROVE, WISCONSIN 53122
PHONE: 782-8690


98-386-7

PREPARED FOR: Dennis Linnell

LOCATION: Main Street (Village of East Troy)

DESCRIPTION OF PROPERTY

Lot 7, 8 and 9 in Block B in LENCK'S PARK ADDITION to the Village of East Troy, being portions of the NE 1/4 of Section 30, Town 4 North, Range 18 East and SE 1/4 of Section 19, Town 4 North, Range 18 East, Walworth County, Wisconsin.

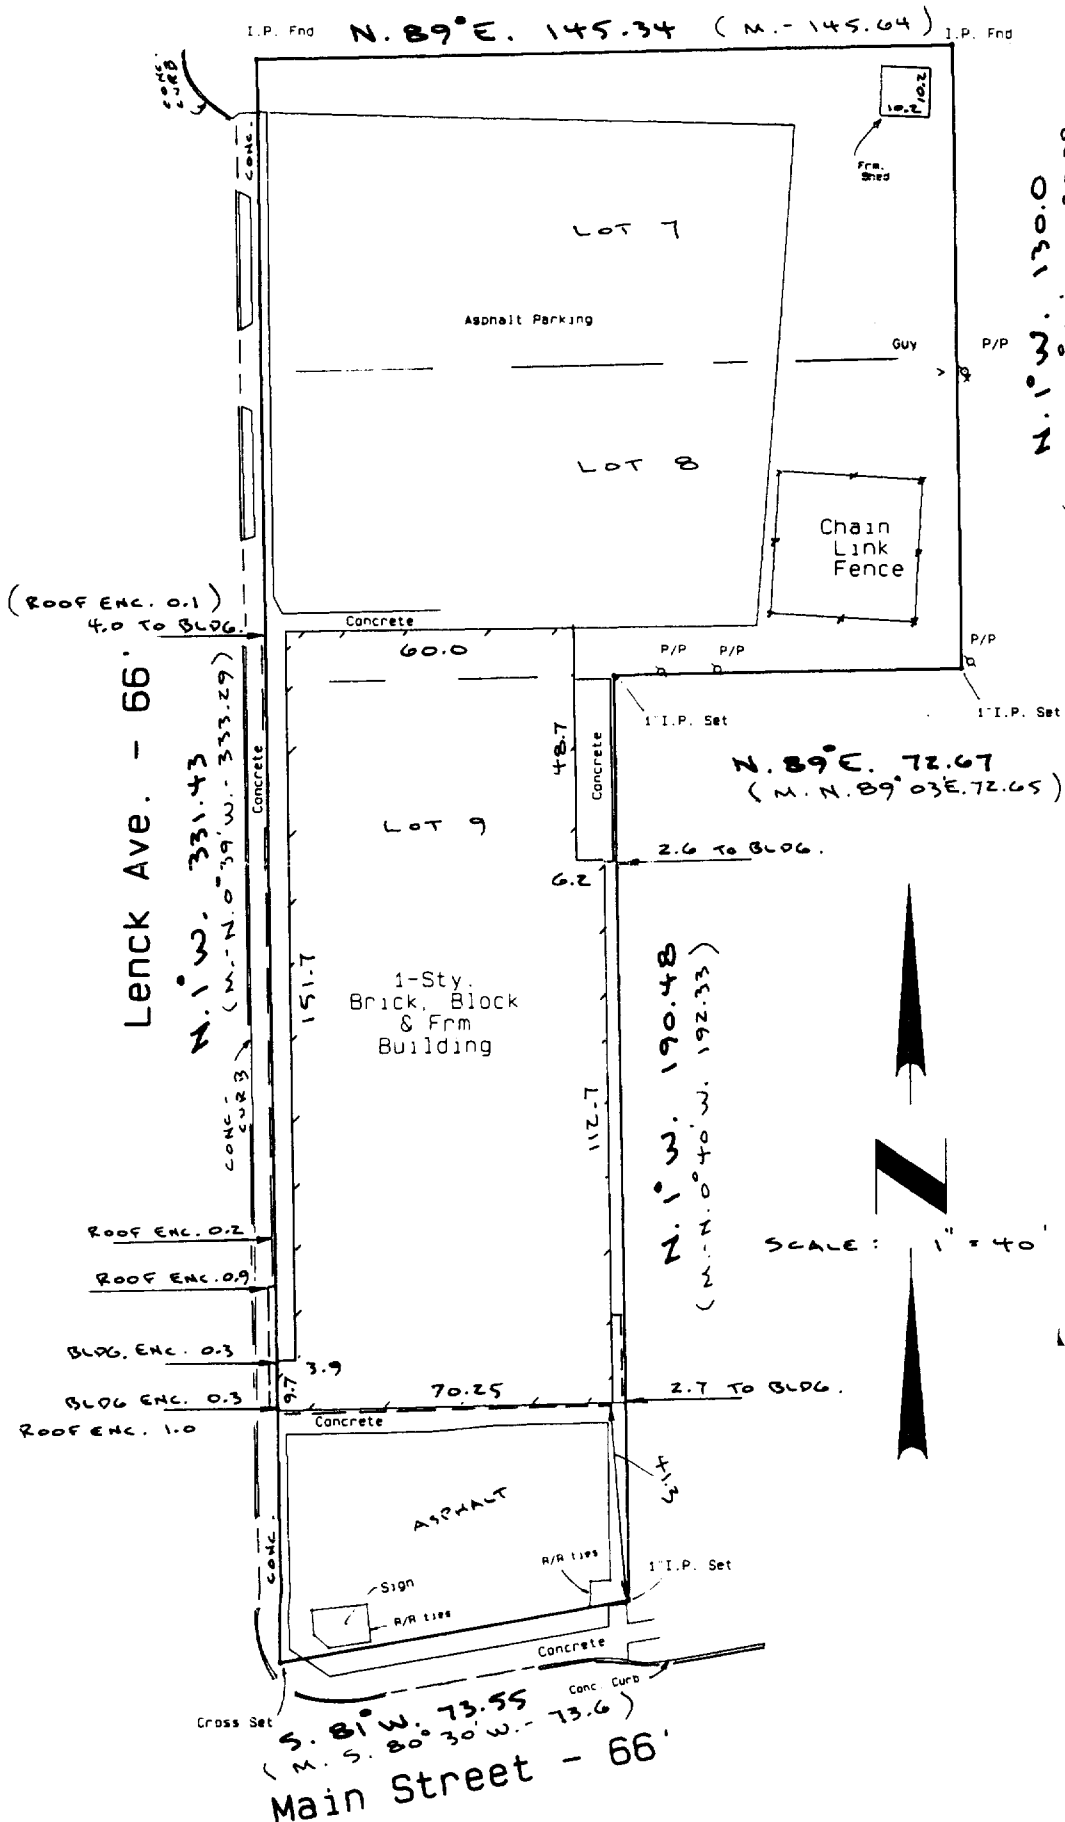

SURVEY CERTIFICATE

I HAVE SURVEYED THE ABOVE-DESCRIBED PROPERTY AND THE ABOVE MAP IS A TRUE REPRESENTATION THEREOF AND SHOWS THE SIZE AND LOCATION OF THE PROPERTY, ITS EXTERIOR BOUNDARIES, THE LOCATION AND DIMENSIONS OF ALL VISIBLE STRUCTURES THEREON, FENCES, APPARENT EASEMENTS AND ROADWAYS AND VISIBLE ENCROACHMENTS, IF ANY.

THIS SURVEY IS MADE FOR THE EXCLUSIVE USE OF THE PRESENT OWNERS OF THE PROPERTY, AND ALSO THOSE WHO PURCHASE, MORTGAGE, OR GUARANTEE THE TITLE THERETO WITHIN ONE (1) YEAR FROM DATE HEREOF.

Dated at
this 6TH day of July, 1998

[Signature]
Surveyor

R.P.-28
R.P.-29
R.P.-30

003-583