


NORTH

ST.

ST.

FREMONT

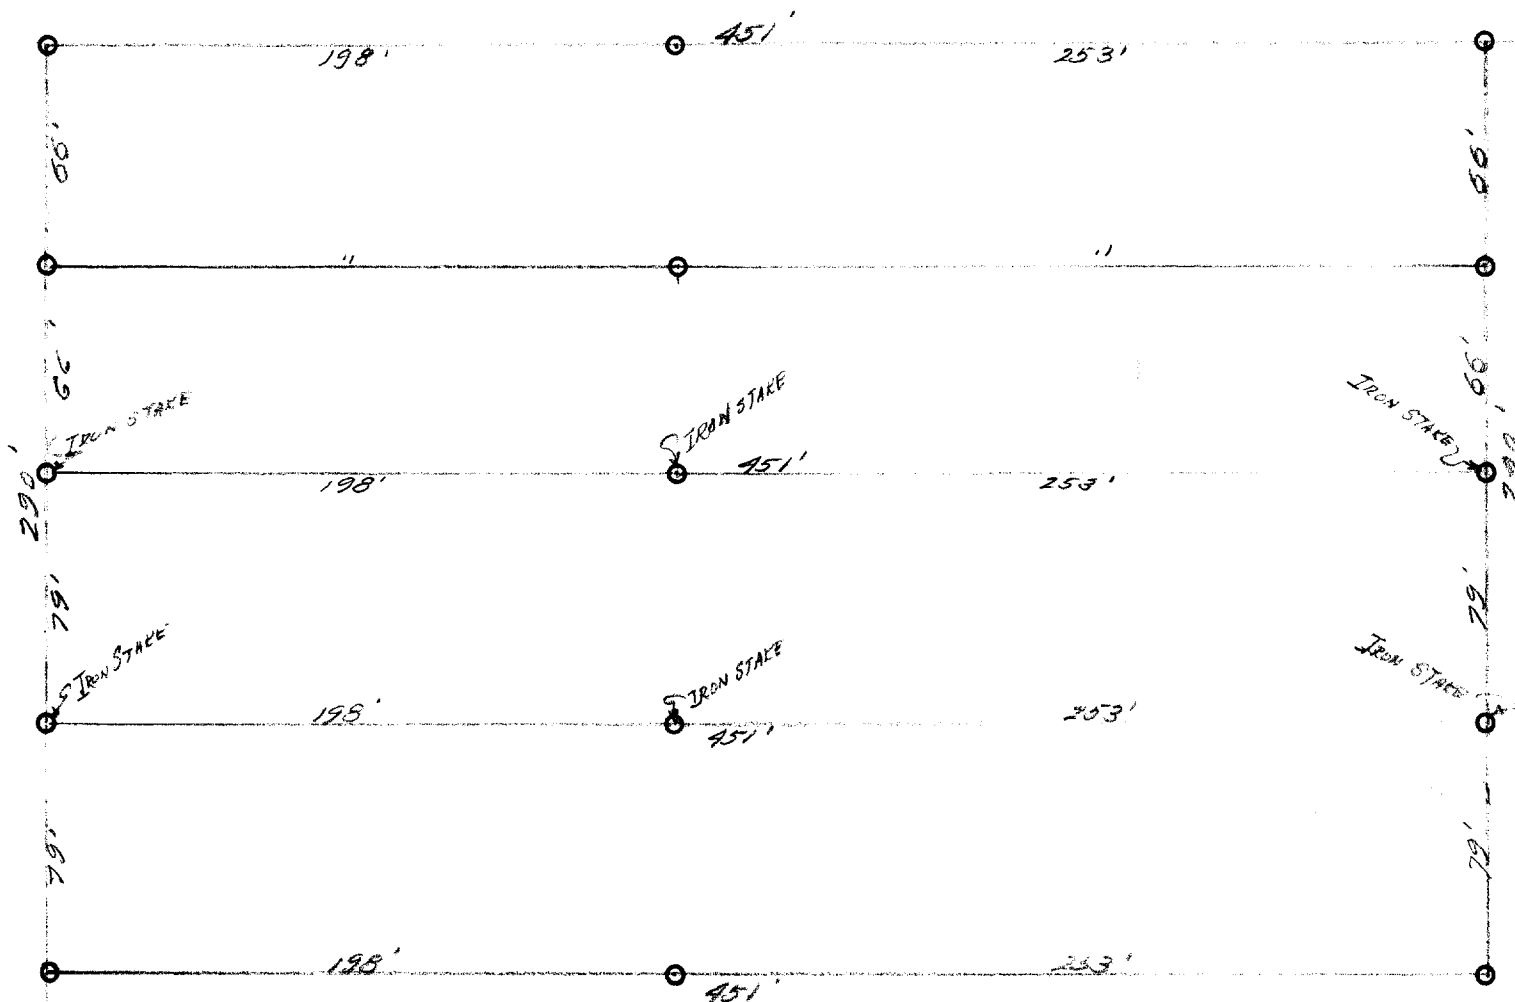

DESCRIPTION: Commencing at an iron stake in the east line of Fremont Street of the Village of East Troy, Walworth County, Wisconsin, 132 feet South of the south line of North Street, thence East 451 feet to an iron stake, thence South 79 feet to an iron stake, thence West 451 feet to an iron stake in the east line of Fremont Street, thence North in the east line of Fremont Street, 79 feet to the place of beginning.

CERTIFICATE: I, hereby certify that I have on this the 22nd day of July, 1949, surveyed the above described property according to the official record on file in the office of the Recorder of Deeds in and for Walworth County, Wisconsin, and find that the measurements and bearings of the boundary lines of said property as taken at the site on this day, substantially agree with those in said official record, and that no encroachments exist. SIGNED AND SEALED ON THIS THE 23RD DAY OF JULY 1949.



Joseph M. Biagi
Joseph M. Biagi, Professional Engineer.
Elkhorn Wisconsin.