


PLAT OF SURVEY

OF

BLOCK 1, CLARK'S ADDITION, VILLAGE OF EAST TROY, WALWORTH CO., WIS.

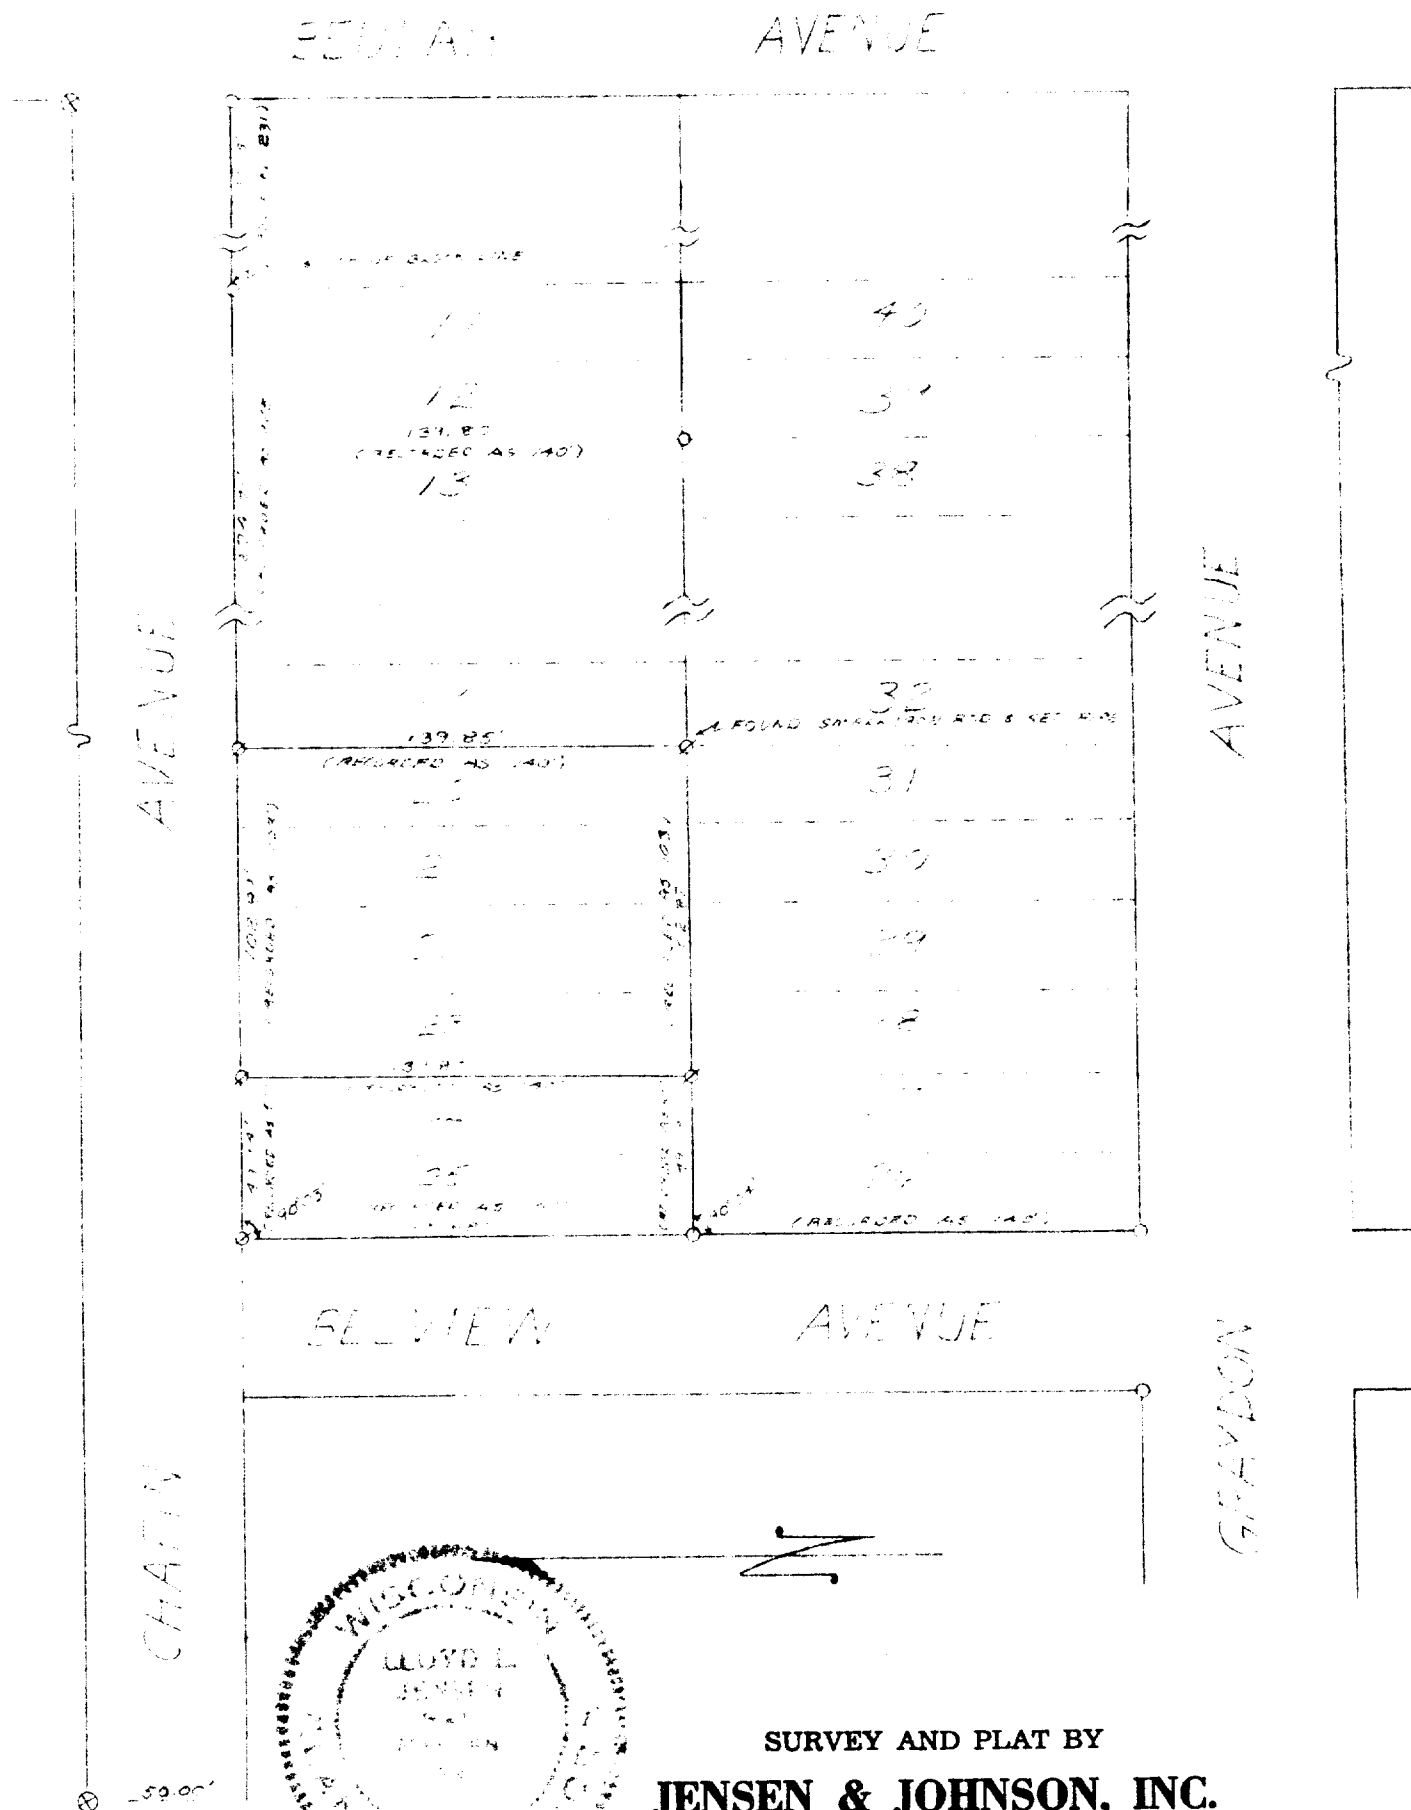

LEGEND

- — Iron Pipe —
- — Concrete Monument
- Scale 1" = 60'

✕ — FOUND TOP IRON BAR FOUND

WE CERTIFY: That we have surveyed the above described property and that the plat shown hereon is an accurate survey and a true representation thereof and correctly shows the exterior boundary lines and all divisions of said property.

Date MAY 1971

Lloyd L. Jensen
LLOYD L. JENSEN,

Wisconsin Registered Land Surveyor, No. S-211