


PLAT OF SURVEY

OF

PART OF BLOCK 4 OF CLARENDON ADDITION VILLAGE OF EAST TROY WIS.

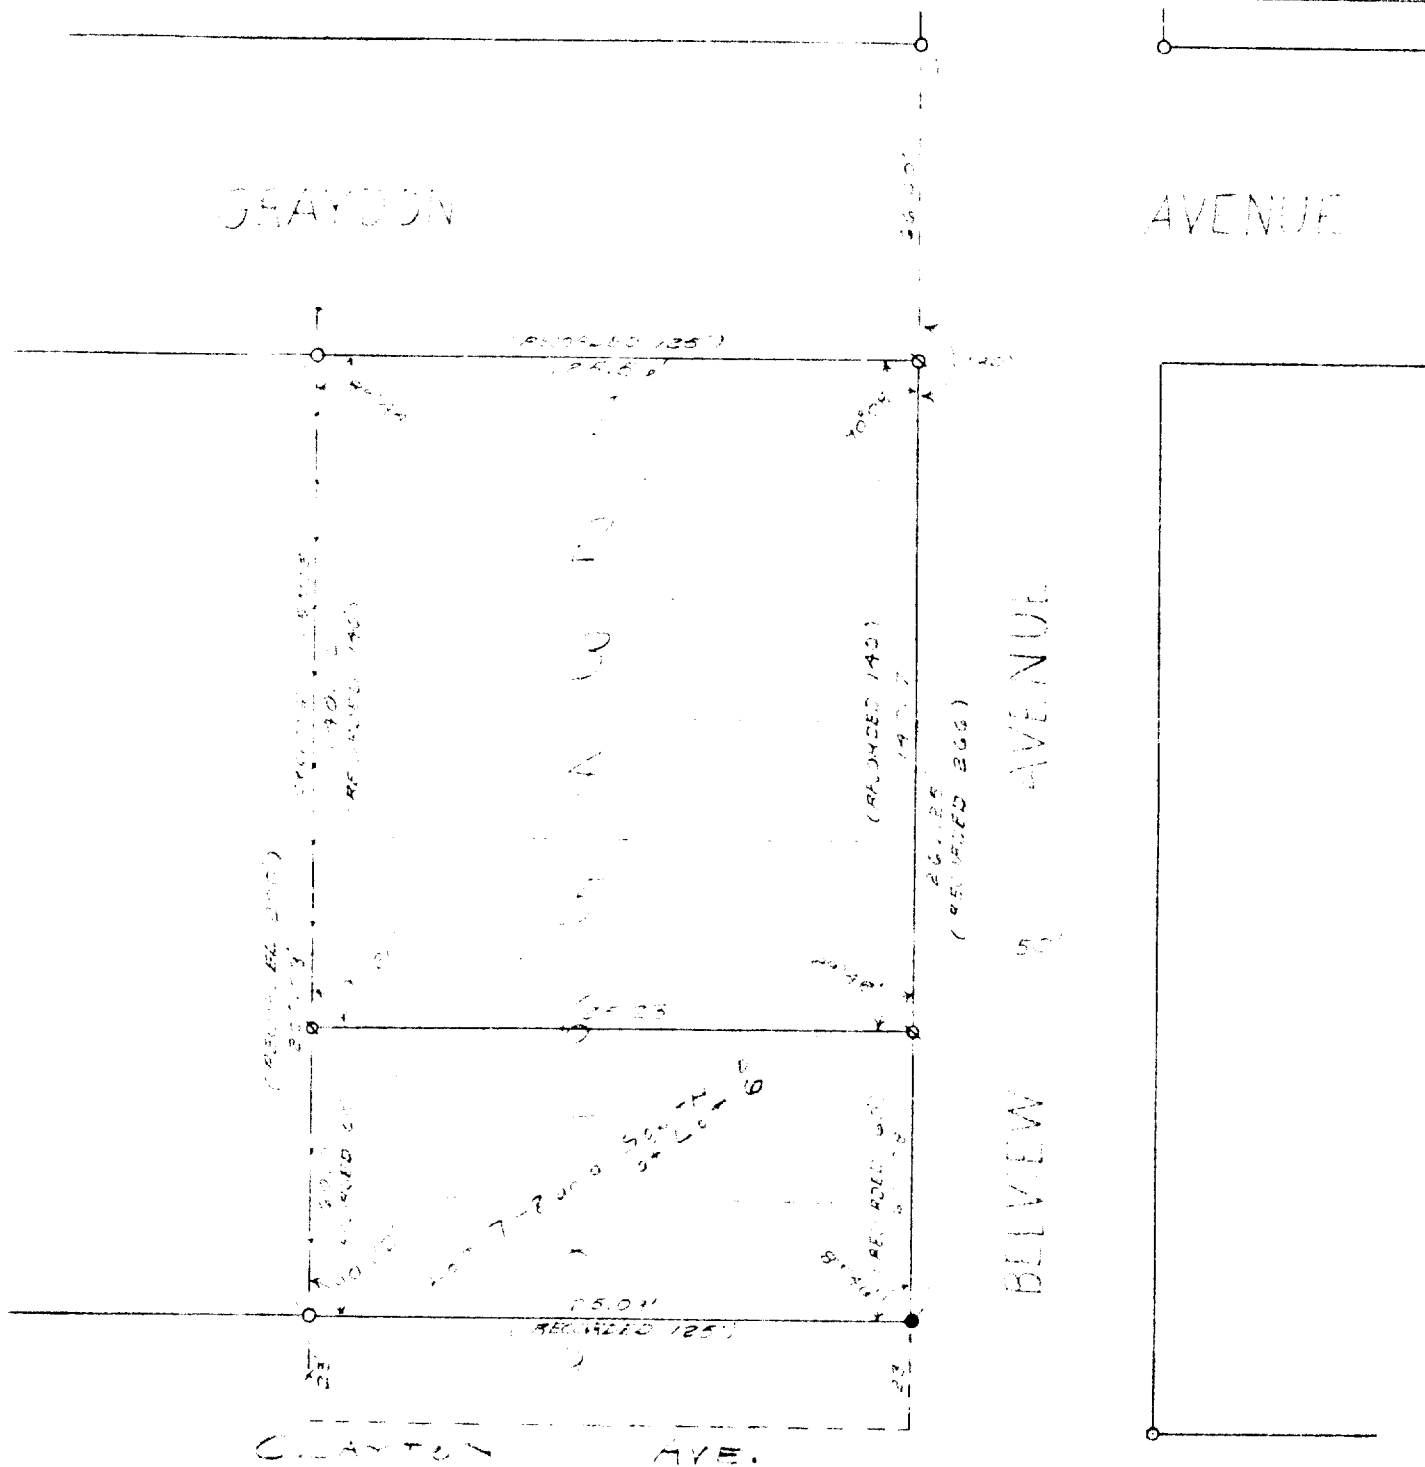

SURVEY AND PLAT BY
JENSEN & JOHNSON, INC.
CIVIL ENGINEERS AND SURVEYORS

Elkhorn, Wisconsin

LEGEND

- FOUND SET
○ — Iron Pipe — &
● — Concrete Monument FOUND
Scale 1" =

WE CERTIFY: That we have surveyed the above described property and that the plat shown hereon is an accurate survey and a true representation thereof and correctly shows the exterior boundary lines and all divisions of said property.

Date May 1971

Lloyd L. Jensen
LLOYD L. JENSEN,

Wisconsin Registered Land Surveyor, No. S-211