



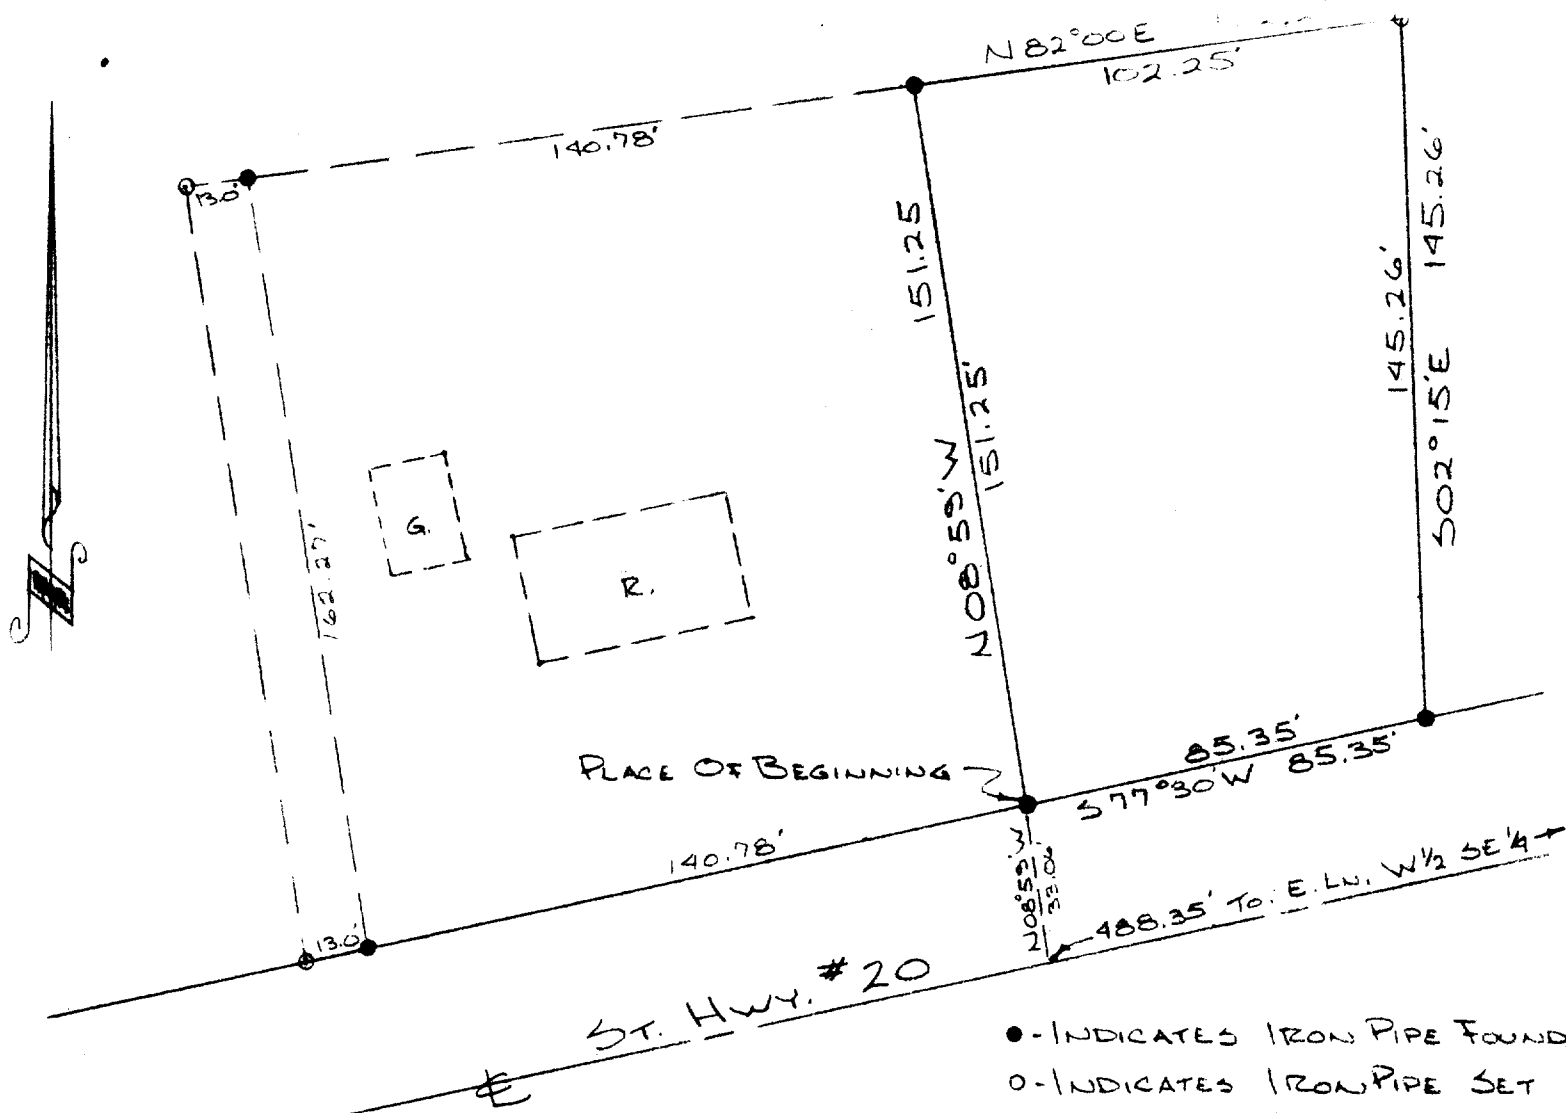

DESCRIPTION: Commencing at the point of intersection of the center line of ST. HWY. #20 and the East line of the W 1/2 of the SE 1/4 of Section 19, T. 4 N., R 18 E., Walworth County, Wisconsin; thence SW'ly along the center line of ST. HWY. #20, 488.35 feet, thence N. 08° 59' W. 33.06 feet to the place of beginning of the lands hereinafter described, to-wit: thence continue N. 08° 59' W. 151.25 feet, thence N. 82° 00' E. 102.25 feet, thence S. 02° 15' E. 145.26 feet, to the N'ly. ROW line of said Hwy., thence S 77° 30' W. 85.35 feet along said N'ly row line to the place of beginning.

CERTIFICATE: I James F. Biagi, surveyor, do hereby certify that I have surveyed the property hereon described.

August 2, 1971.

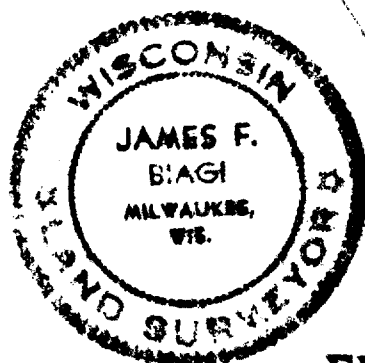

James F. Biagi, RLS 272

ENGINEERS ASSOCIATED, INC.
 203 W. WALWORTH ST.
 ELKHORN, WISCONSIN

3-5B