


## PLAT OF SURVEY

LOT 29, STERLING OAKS, being a Subdivision of part of the Southeast 1/4 of the Northwest 1/4 and part of the Northwest 1/4 and Southwest 1/4 of the Northeast 1/4 of Section 20, Township 4 North, Range 18 East, in the Village of East Troy, Walworth County, Wisconsin.

Surveyed for: Bielinski Bros. Builders/Monte and Debra Merath

AUG 1 8 19...  
dg

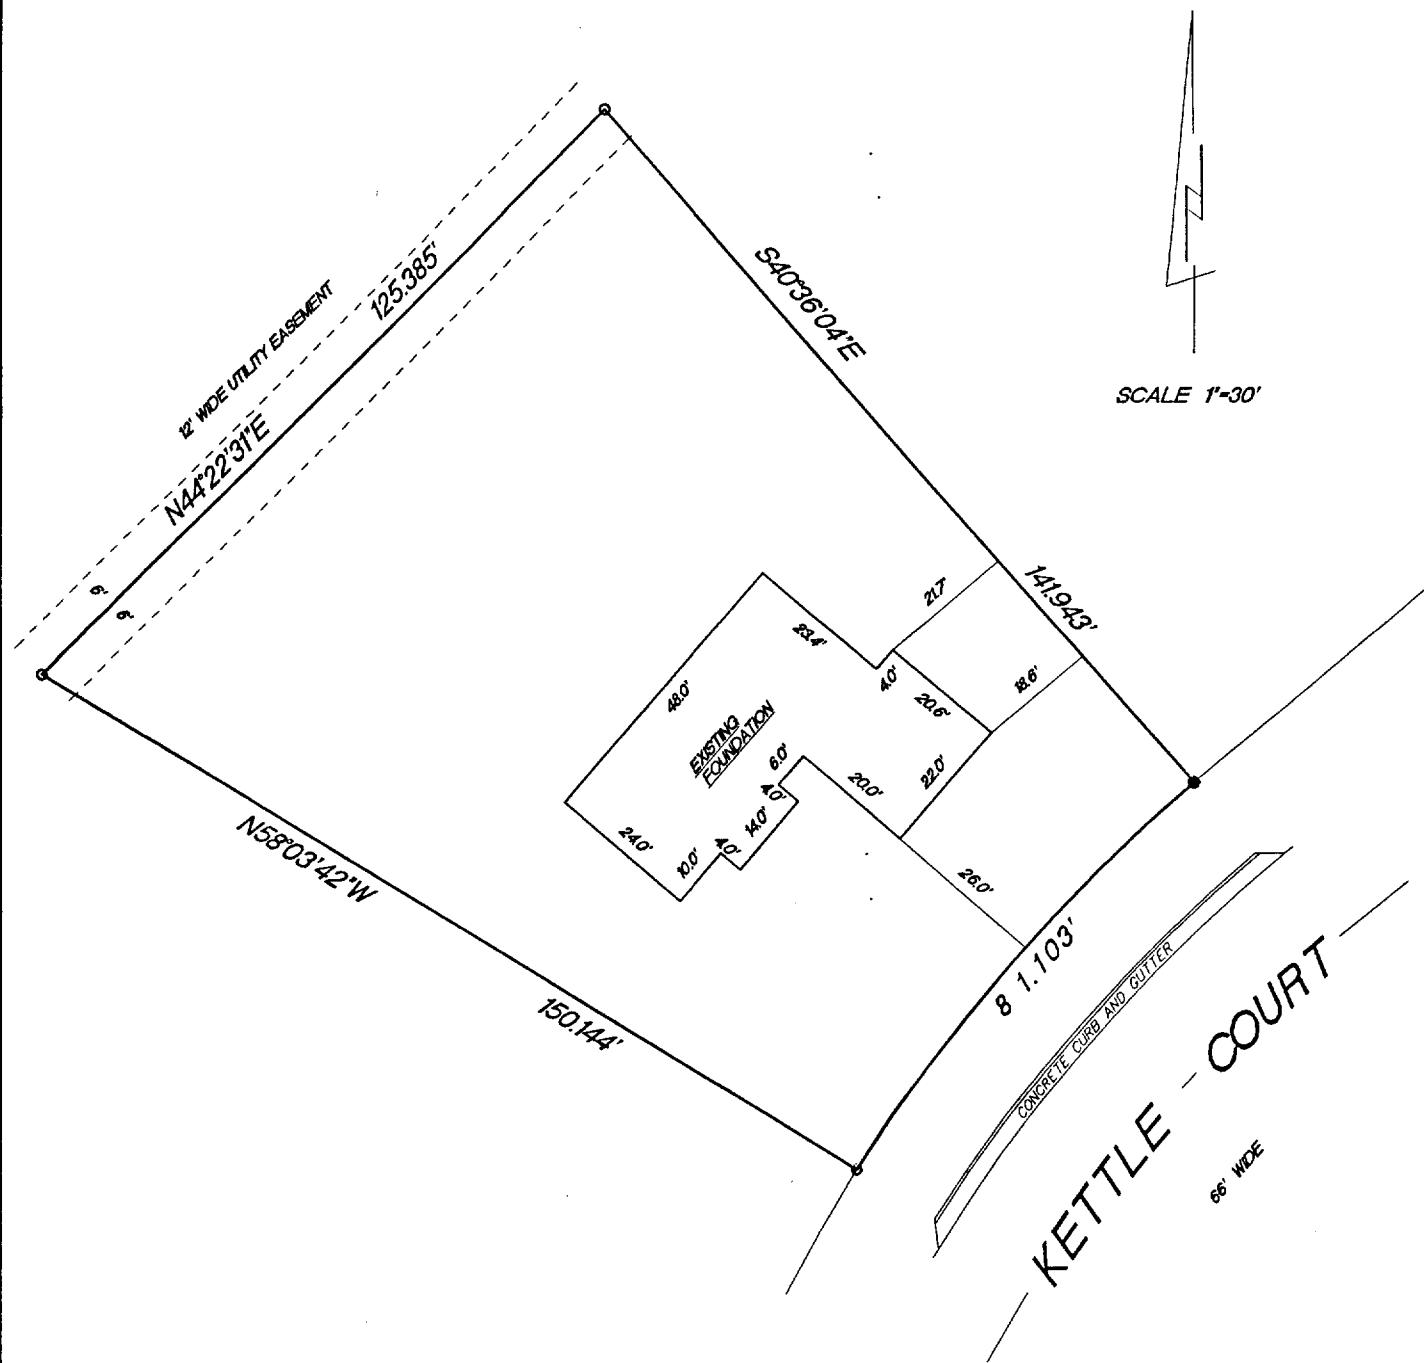

- FOUND 2" IRON PIPE
- FOUND 1" IRON PIPE

RADIUS	LENGTH	CHORD	BEARING	DELTA
266.195	81.103'	80.790'	S40°40'07" W	172738"

"I hereby certify that I have surveyed the above described property and that the above map is a true representation thereof and shows the size and location of the property, its exterior boundaries, the location of all visible structures and dimension of all principal buildings thereon, boundary fences, apparent easements, roadways and encroachments if any."

"This survey is made for the use of the present owners of the property, and also those who purchase, mortgage or guarantee the title thereto within one year from date hereof."



W356 S9050 Godfrey Lane  
P.O. Box 357  
Eagle WI. 53119

~~(414) 594-3484~~  
fax (414) 594-5904

**THIS IS NOT AN ORIGINAL SURVEY UNLESS THE SEAL IS RED.**

REV. 8/9/99  
5/27/99

FIELD WORK BY

TEP

---

DRAWN BY

99151