


AVE

MAIN

ST.

66.2'

BEULAH

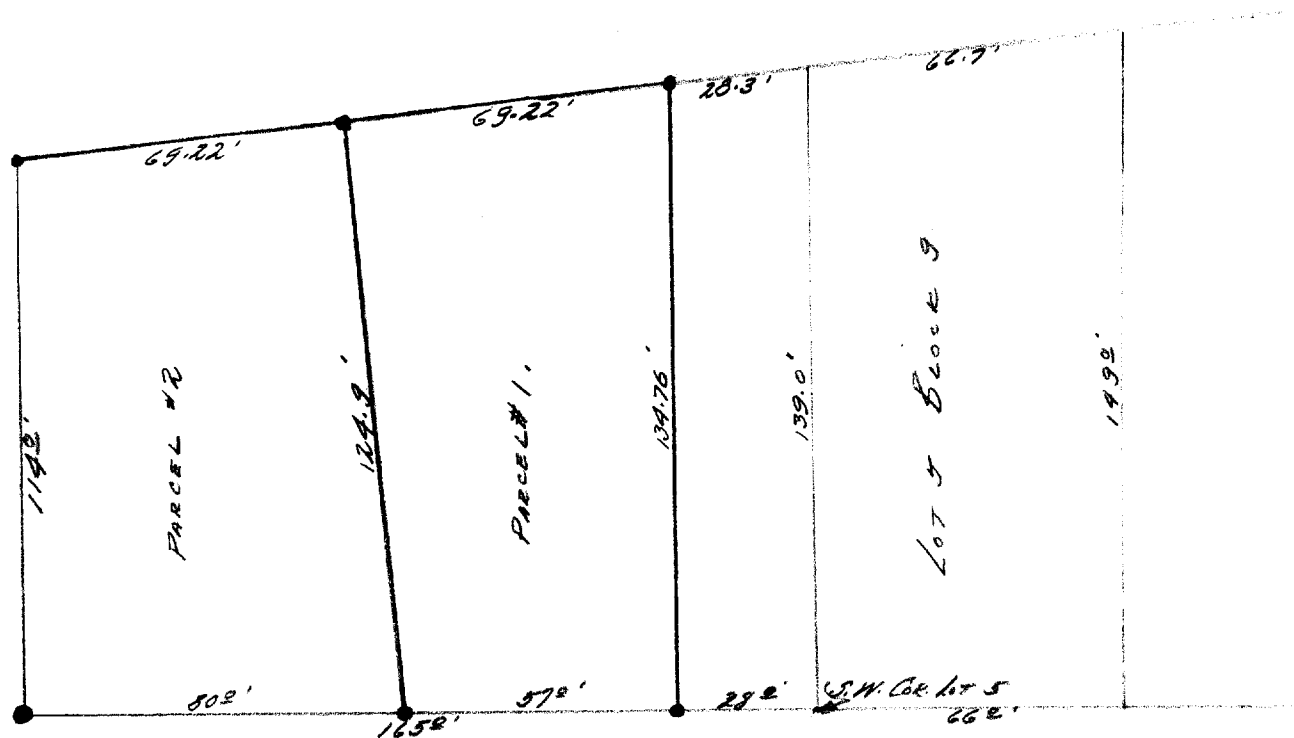

AUSTIN ST.

66.2'

DESCRIPTION:

PARCEL # 1.

Commencing at an iron stake in the north line of Austin Street of the Village of East Troy, Walworth County, Wisconsin, that is 28.0 feet west of the southwest corner of Lot 5, Block 9, of the Original Plat of the Village of East Troy, Walworth County, Wisconsin; thence North 134.76 feet to an iron stake in the southerly line of Main Street of said village, thence southwesterly along the southerly line of said Main Street, 69.22 feet to an iron stake, thence southeasterly 124.9 feet to an iron stake in the north line of said Austin Street that is 57.0 feet west of the place of beginning, thence East along the north line of said Austin Street 57.0 feet to the place of beginning.

PARCEL #2

Commencing at an iron stake in the north line of Austin Street of the Village of East Troy, Walworth County, Wisconsin, that is 85.0 feet west of the southwest corner of Lot 5, Block 9, of the Original Plat of the Village of East Troy, Walworth County, Wisconsin; thence West along the north line of said Austin Street 80.2 feet to an iron stake, thence North 114.0 feet to an iron stake in the southerly line of Main Street of said village, thence northeasterly along the southerly line of said Main Street 69.22 feet to an iron stake, thence southeasterly 124.9 feet to the place of beginning.

CERTIFICATE:

I, hereby certify that I have on this the 13th day of March 1950, surveyed the above described property according to the official records on file in the office of the Recorder of Deeds in and for Walworth County, Wisconsin, and find that the measurements and bearings of the boundary lines of said property as taken at the site on this day, substantially agree with those in said official record and that no encroachments exist.

SIGNED AND SEALED ON THIS THE 17TH DAY OF MARCH 1950

Joseph M. Rigi.
Joseph M. Rigi.
Professional Engineer.
Elkhorn Wisconsin.