


PLAT OF SURVEY

OF

A PARCEL OF LAND IN THE SOUTHEAST $\frac{1}{4}$ OF
SECTION 19, T4N R1E, VILLAGE OF EAST TROY,
WALWORTH COUNTY, WISCONSIN.

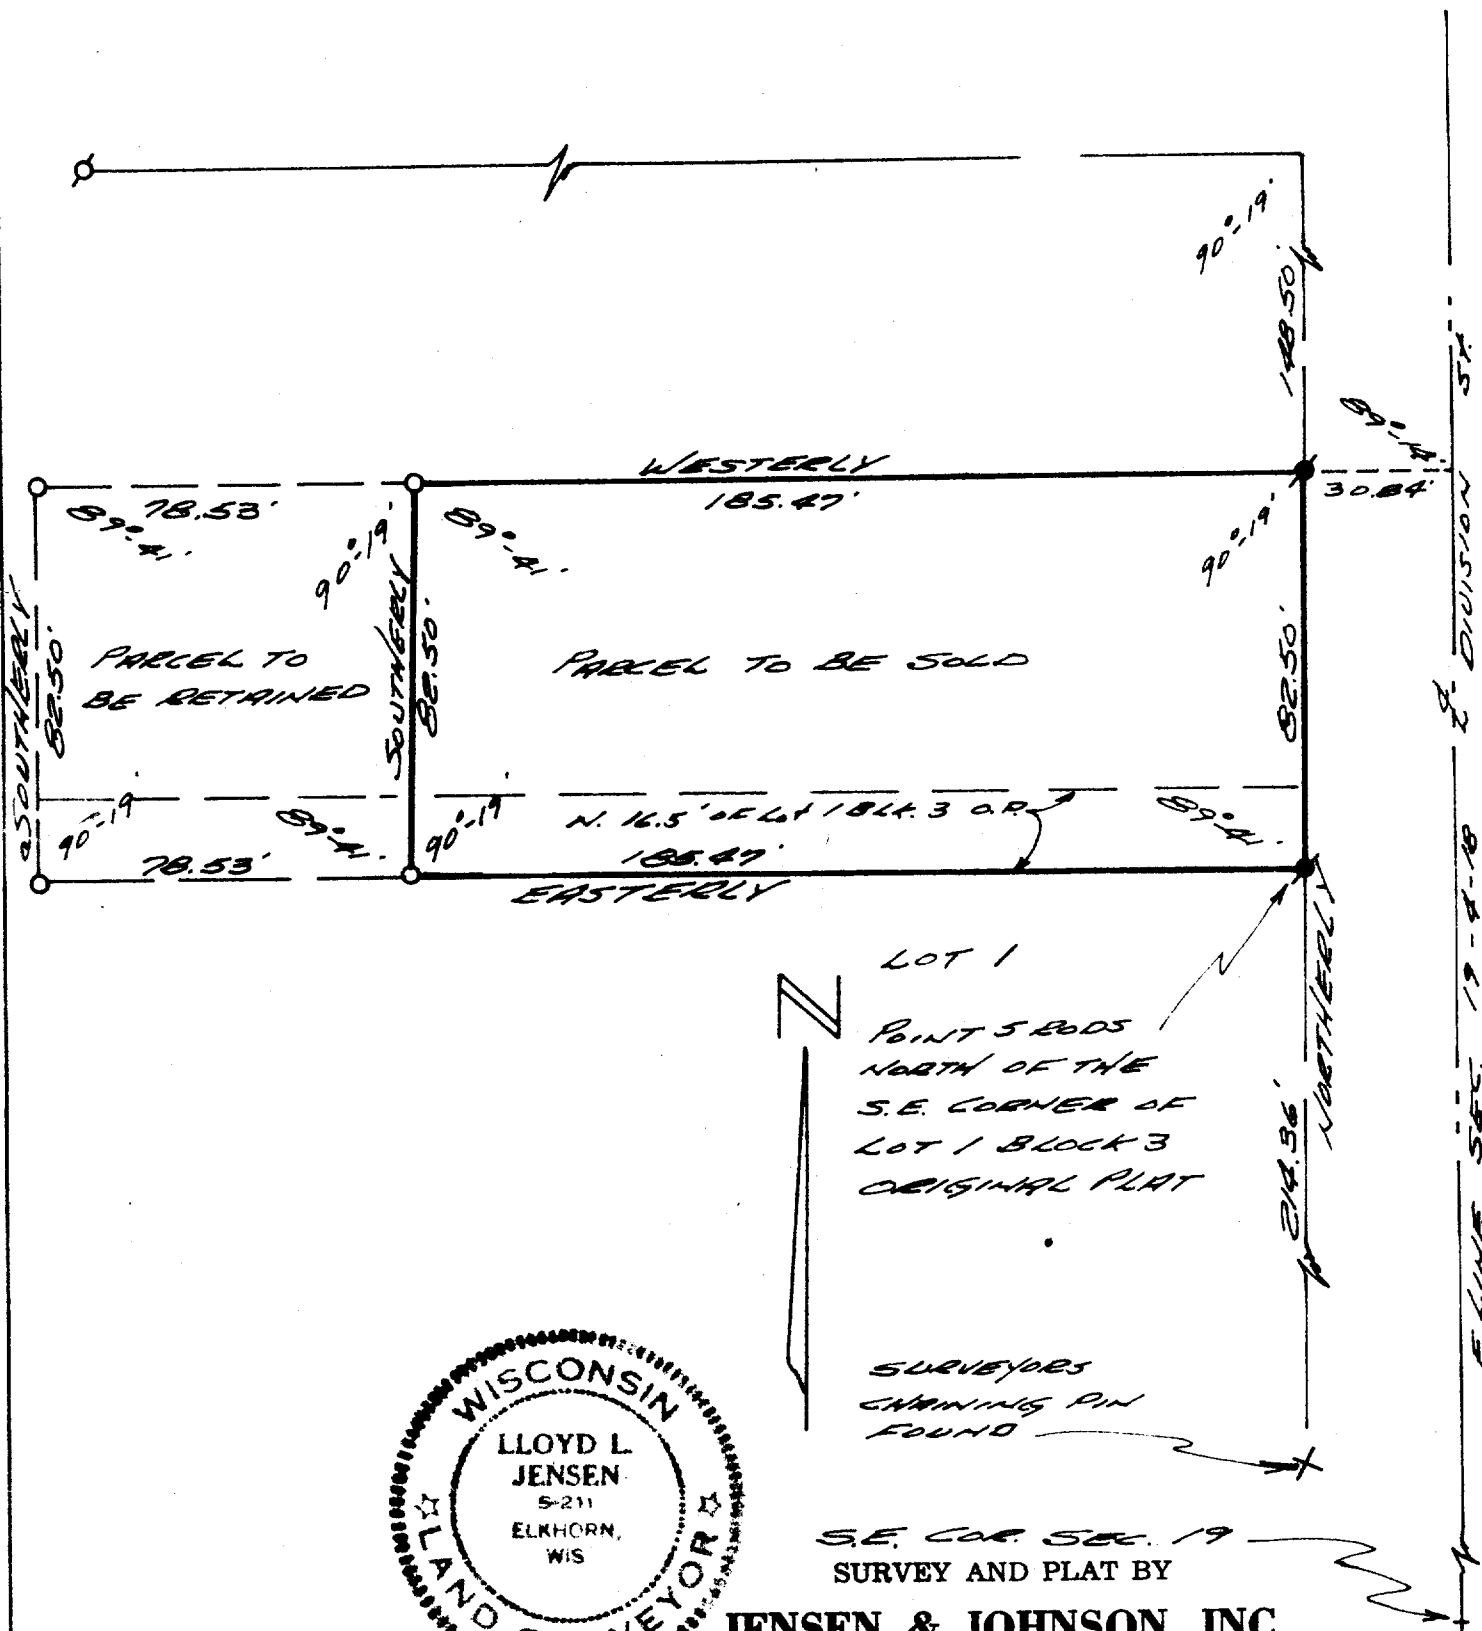

LEGEND

- — Iron Pipe SET
- — Concrete Monument

Scale 1" = 40'

- — IRON ROD FOUND
- — IRON PIPE FOUND

WE CERTIFY: That we have surveyed the above described property and that the plat shown hereon is an accurate survey and a true representation thereof and correctly shows the exterior boundary lines and all divisions of said property.

Date SEPT 1971

Lloyd L. Jensen
LLOYD L. JENSEN,

Wisconsin Registered Land Surveyor, No. S-211