


PLAT OF SURVEY

DATE: REV. 10/19/99

FOR: DESIGN BUILD, INC.

DESCRIPTION: LOT 1 OF C.S.M. #3142 BEING A REDIVISION OF LOT 2 OF C.S.M. #3141 BEING A PART OF THE SE¹/₄ OF THE SW¹/₄ AND THE SW¹/₄ OF THE SE¹/₄ OF SECTION 29, TOWN 4 NORTH, RANGE 18 EAST, VILLAGE OF EAST TROY, WALWORTH COUNTY, WISCONSIN.

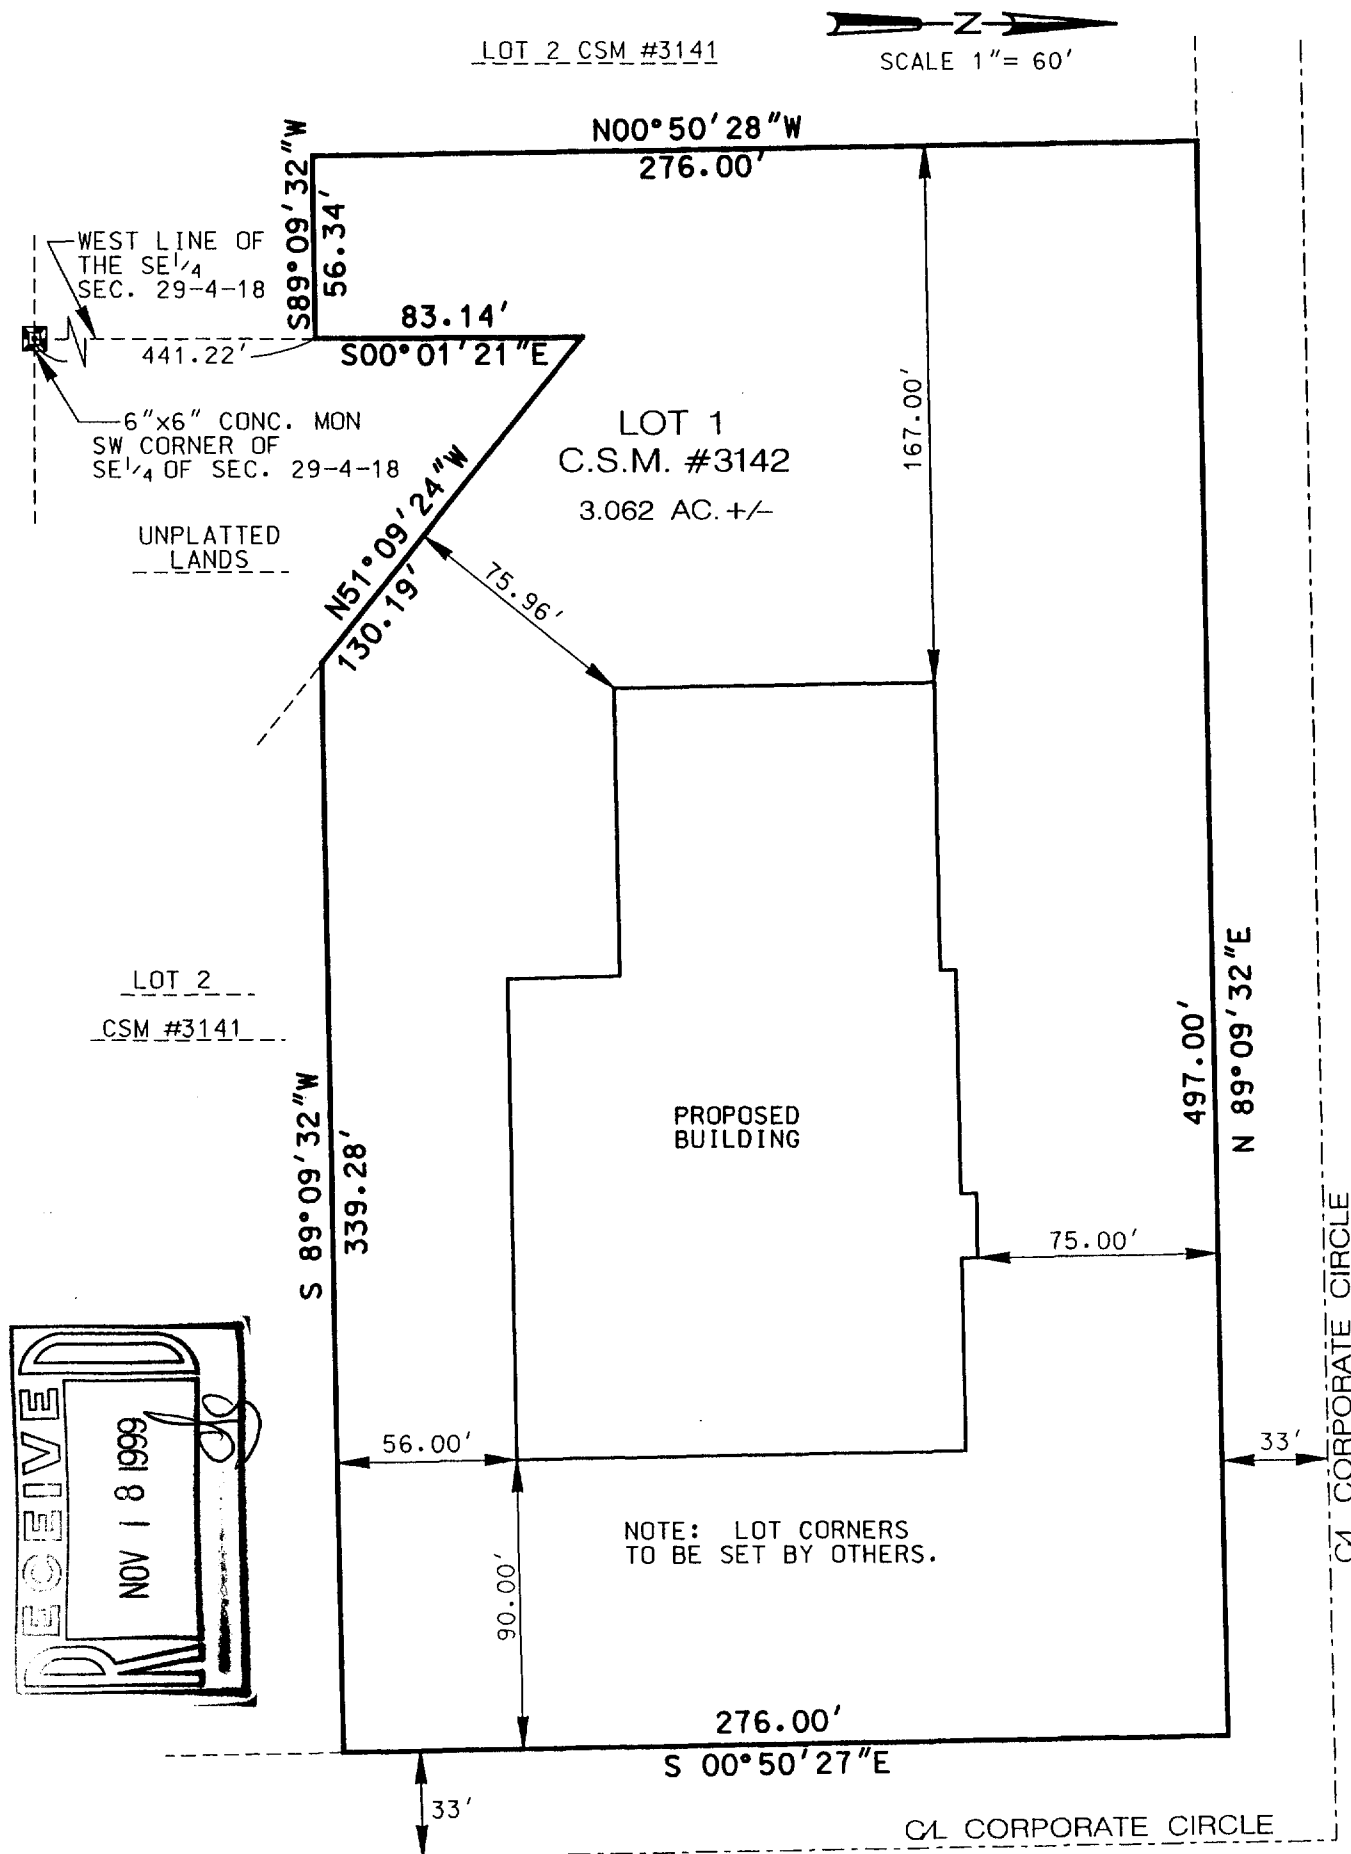

THE ABOVE MAP IS A TRUE REPRESENTATION THEREOF AND SHOWS THE SIZE AND LOCATION OF ALL THE PROPERTY, EXTERIOR BOUNDARIES, THE LOCATION OF ALL VISIBLE BOUNDARY FENCES, APPARENT EASEMENTS, ROADWAYS AND VISIBLE ENCROACHMENTS, IF ANY.

THIS SURVEY IS MADE FOR THE USE OF THE PRESENT OWNERS OF THE PROPERTY, AND ALSO THOSE WHO PURCHASE, MORTGAGE OR GUARANTEE TITLE THERETO WITHIN ONE (1) YEAR FROM DATE HERETO.

BRADFORD L. SPENCER, R.L.S. 2069
RSV#99220

THIS IS ORIGINAL
PRINT ONLY IF
SEAL IS IMPRINTED
IN RED



RA-3142-1



002.644

PLAT OF SURVEY

RECERT. 11/10/99

FOR: DESIGN BUILD, INC.

DESCRIPTION: LOT 1 OF C.S.M. #3142 BEING A REDIVISION OF LOT 2 OF C.S.M. #3141 BEING A PART OF THE SE¹/₄ OF THE SW¹/₄ AND THE SW¹/₄ OF THE SE¹/₄ OF SECTION 29, TOWN 4 NORTH, RANGE 18 EAST, VILLAGE OF EAST TROY, WALWORTH COUNTY, WISCONSIN.

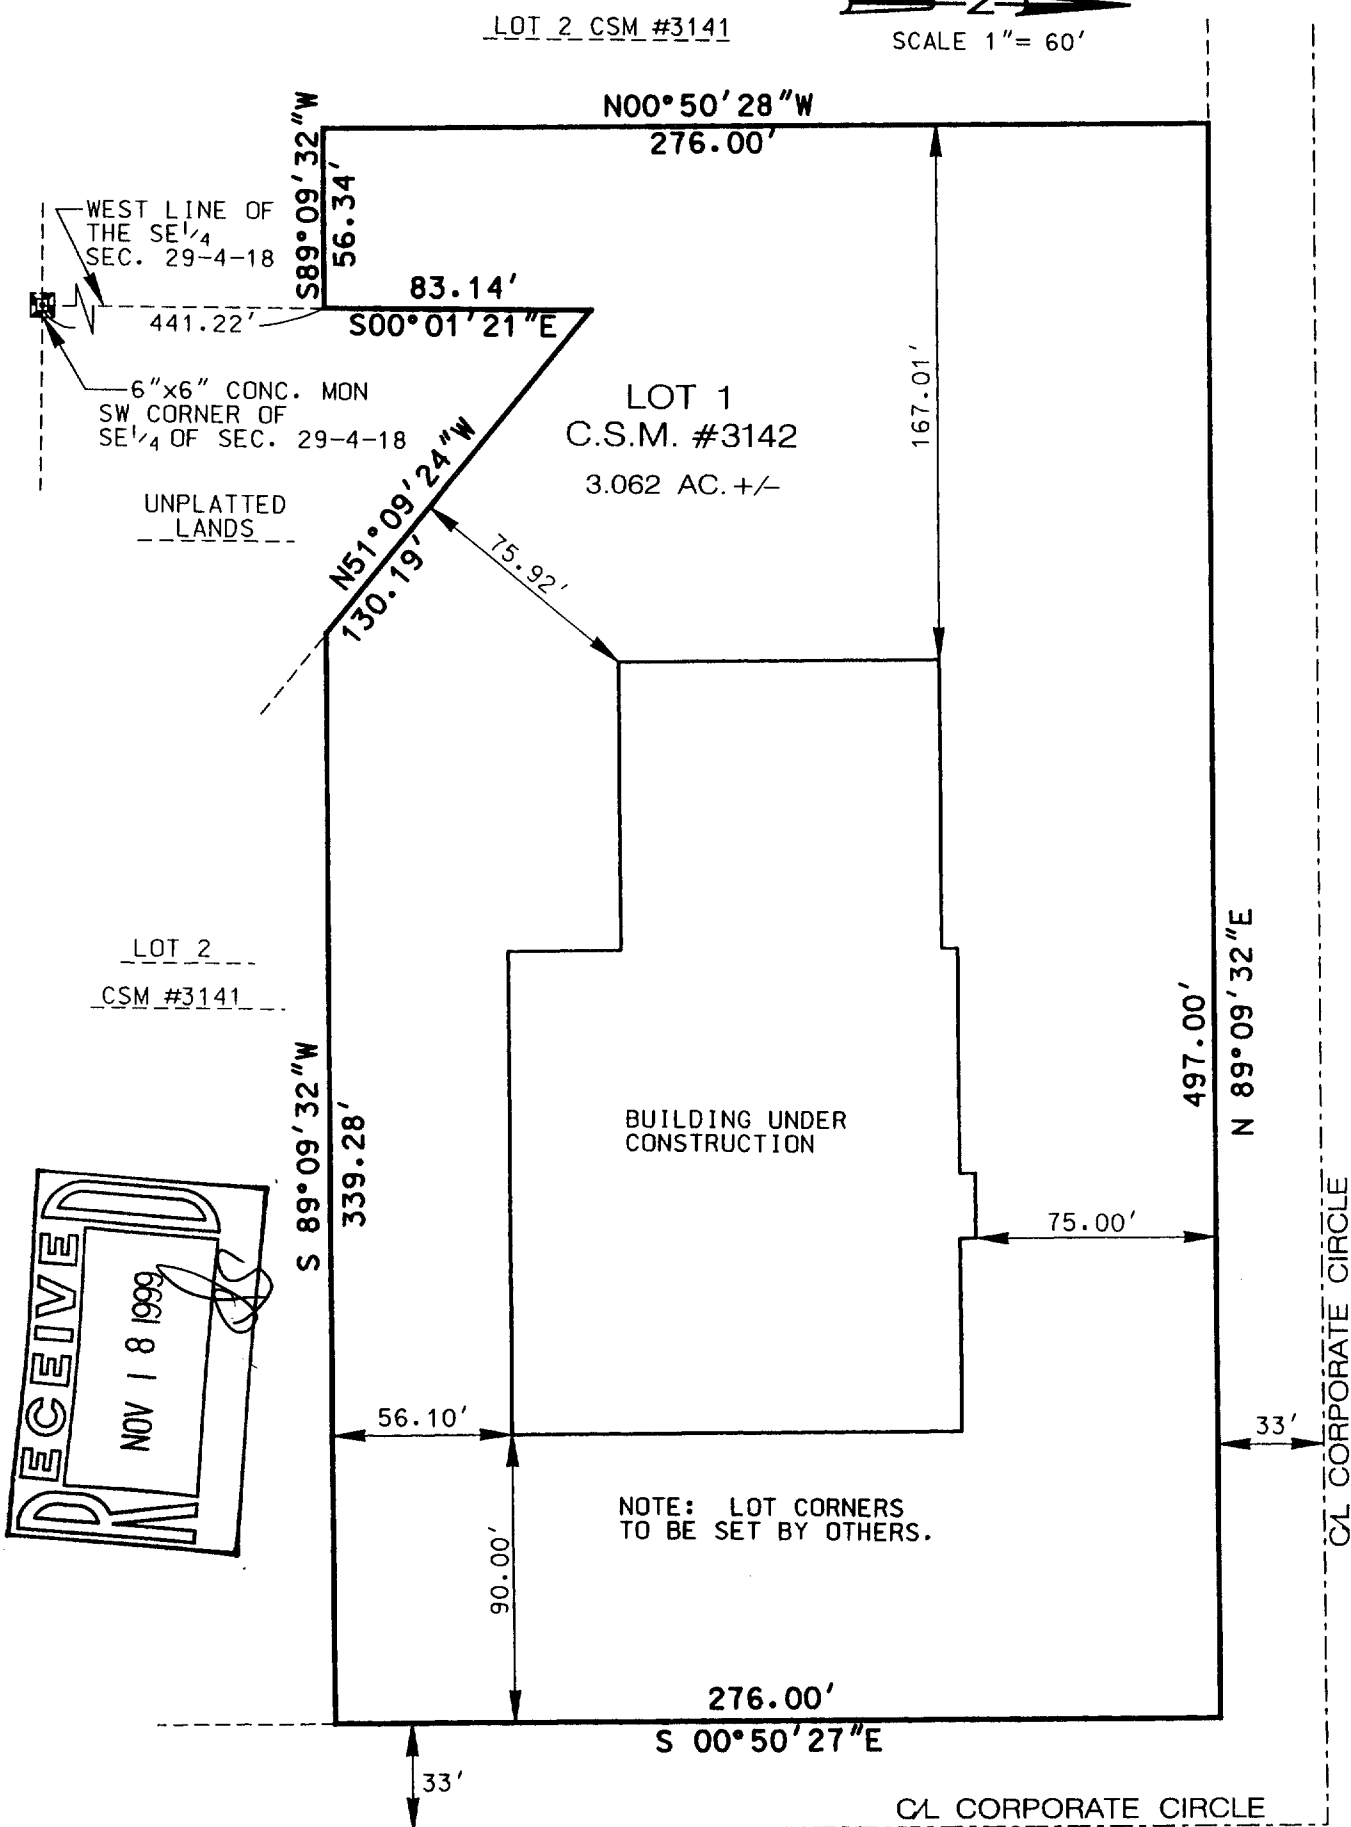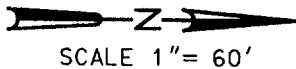


THE ABOVE MAP IS A TRUE REPRESENTATION THEREOF AND SHOWS THE SIZE AND LOCATION OF ALL THE PROPERTY, EXTERIOR BOUNDARIES, THE LOCATION OF ALL VISIBLE BOUNDARY FENCES, APPARENT EASEMENTS, ROADWAYS AND VISIBLE ENCROACHMENTS, IF ANY.

THIS SURVEY IS MADE FOR THE USE OF THE PRESENT OWNERS OF THE PROPERTY, AND ALSO THOSE WHO PURCHASE, MORTGAGE OR GUARANTEE TITLE THERETO WITHIN ONE (1) YEAR FROM DATE HERETO.

BRADFORD L. SPENCER, R.L.S. 2069
RSV#99220

THIS IS ORIGINAL
PRINT ONLY IF
SEAL IS IMPRINTED
IN RED

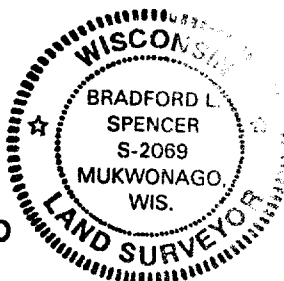

RA-3142-1

003-644