



LOT 163, STERLING OAKS ADDITION NO. 1, being a part of the Northwest 1/4 and Southwest 1/4 of the Northeast 1/4 and a part of the Northeast 1/4 and Southeast 1/4 of the Northwest 1/4, all in Section 20, Town 4 North, Range 18 East, Village of East Troy, Walworth County, Wisconsin.

Surveyed for: Bielinski Bros. Builders Inc./Frederick Samuel

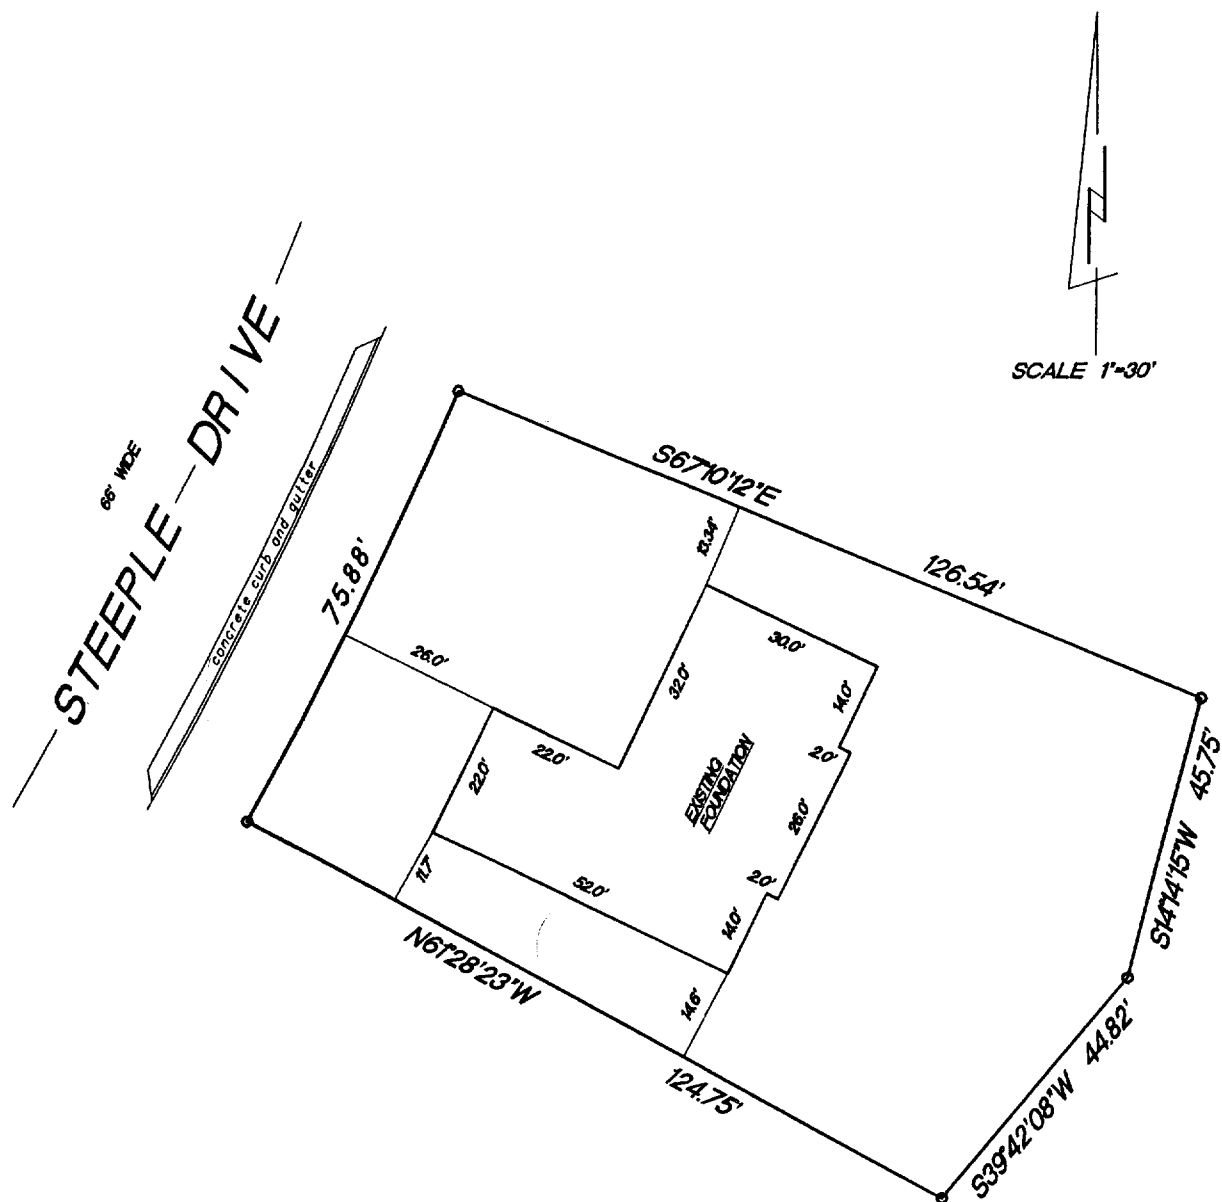

0 FOUND 1" IRON PIPE

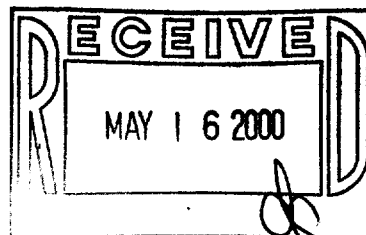

RADIUS	LENGTH	CHORD	BEARING	DELTA
763.10'	75.88'	75.85'	N25°40'42.5"E	05°41'49"

"This survey is made for the use of the present owners of the property, and also those who purchase, mortgage or guarantee the title thereto within one year from date hereof."

Terrance E. Pisarek R.L.S.

THIS IS NOT AN ORIGINAL SURVEY UNLESS THE SEAL IS RED.

REV. 4/11/00
3/3/00

DATE _____

TEP/DW

FIELD WORK BY

TEP

DRAWN BY

00049

JOB NUMBER

RST01-93

003-686