


PLAT OF SURVEY OF

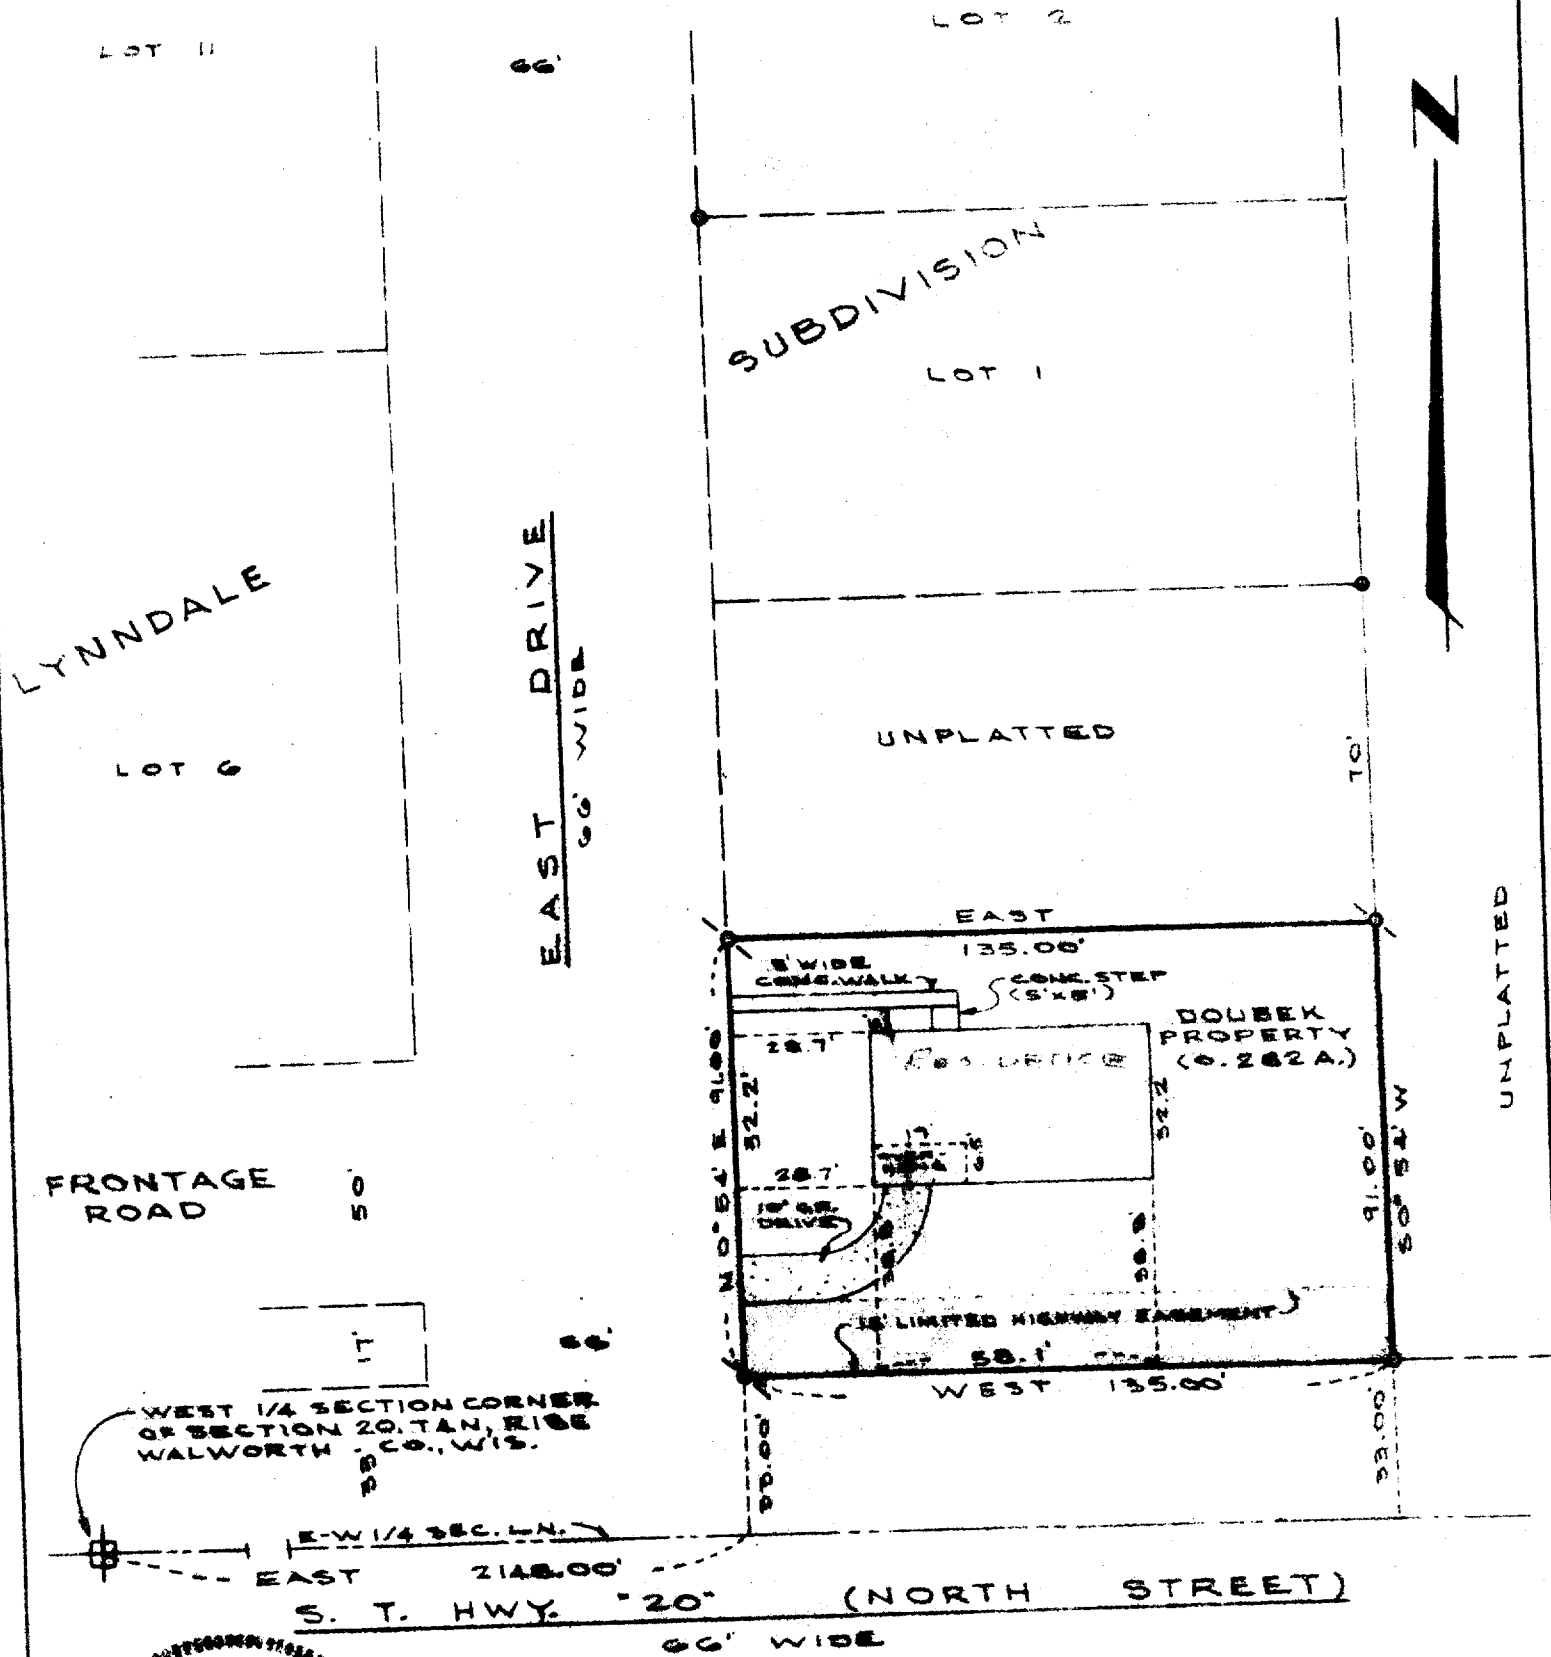

WEST 1/4 SECTION CORNER
OF SECTION 20, T4N, R18E
WALWORTH CO., WIS.

LEGEND
 — 10" Iron Pipe Found
 — 1" Iron Pipe Set
 — Concrete Monument
 Scale 1" = 40'

SURVEY AND PLAT BY
JENSEN & JOHNSON, INC.
 CIVIL ENGINEERS AND SURVEYORS
 Elkhorn, Wisconsin

WE CERTIFY: That we have surveyed the above described property and that the plat shown hereon is an accurate survey and a true representation thereof and correctly shows the exterior boundary lines and all divisions of said property, and buildings thereon.

Date JUNE 1971

Lloyd L. Jensen
 LLOYD L. JENSEN,
 Wisconsin Registered Land Surveyor, No. S-211

3-68J

UP-120 — (South 91')