


LOT 79, STERLING OAKS ADDITION NO. 1, being a part of the Northwest 1/4 and Southwest 1/4 of the Northeast 1/4 and a part of the Northeast 1/4 and Southeast 1/4 of the Northwest 1/4, all in Section 20, Town 4 North, Range 18 East, Village of East Troy, Walworth County, Wisconsin.

- FOUND 2" IRON PIPE
- FOUND 1" IRON PIPE

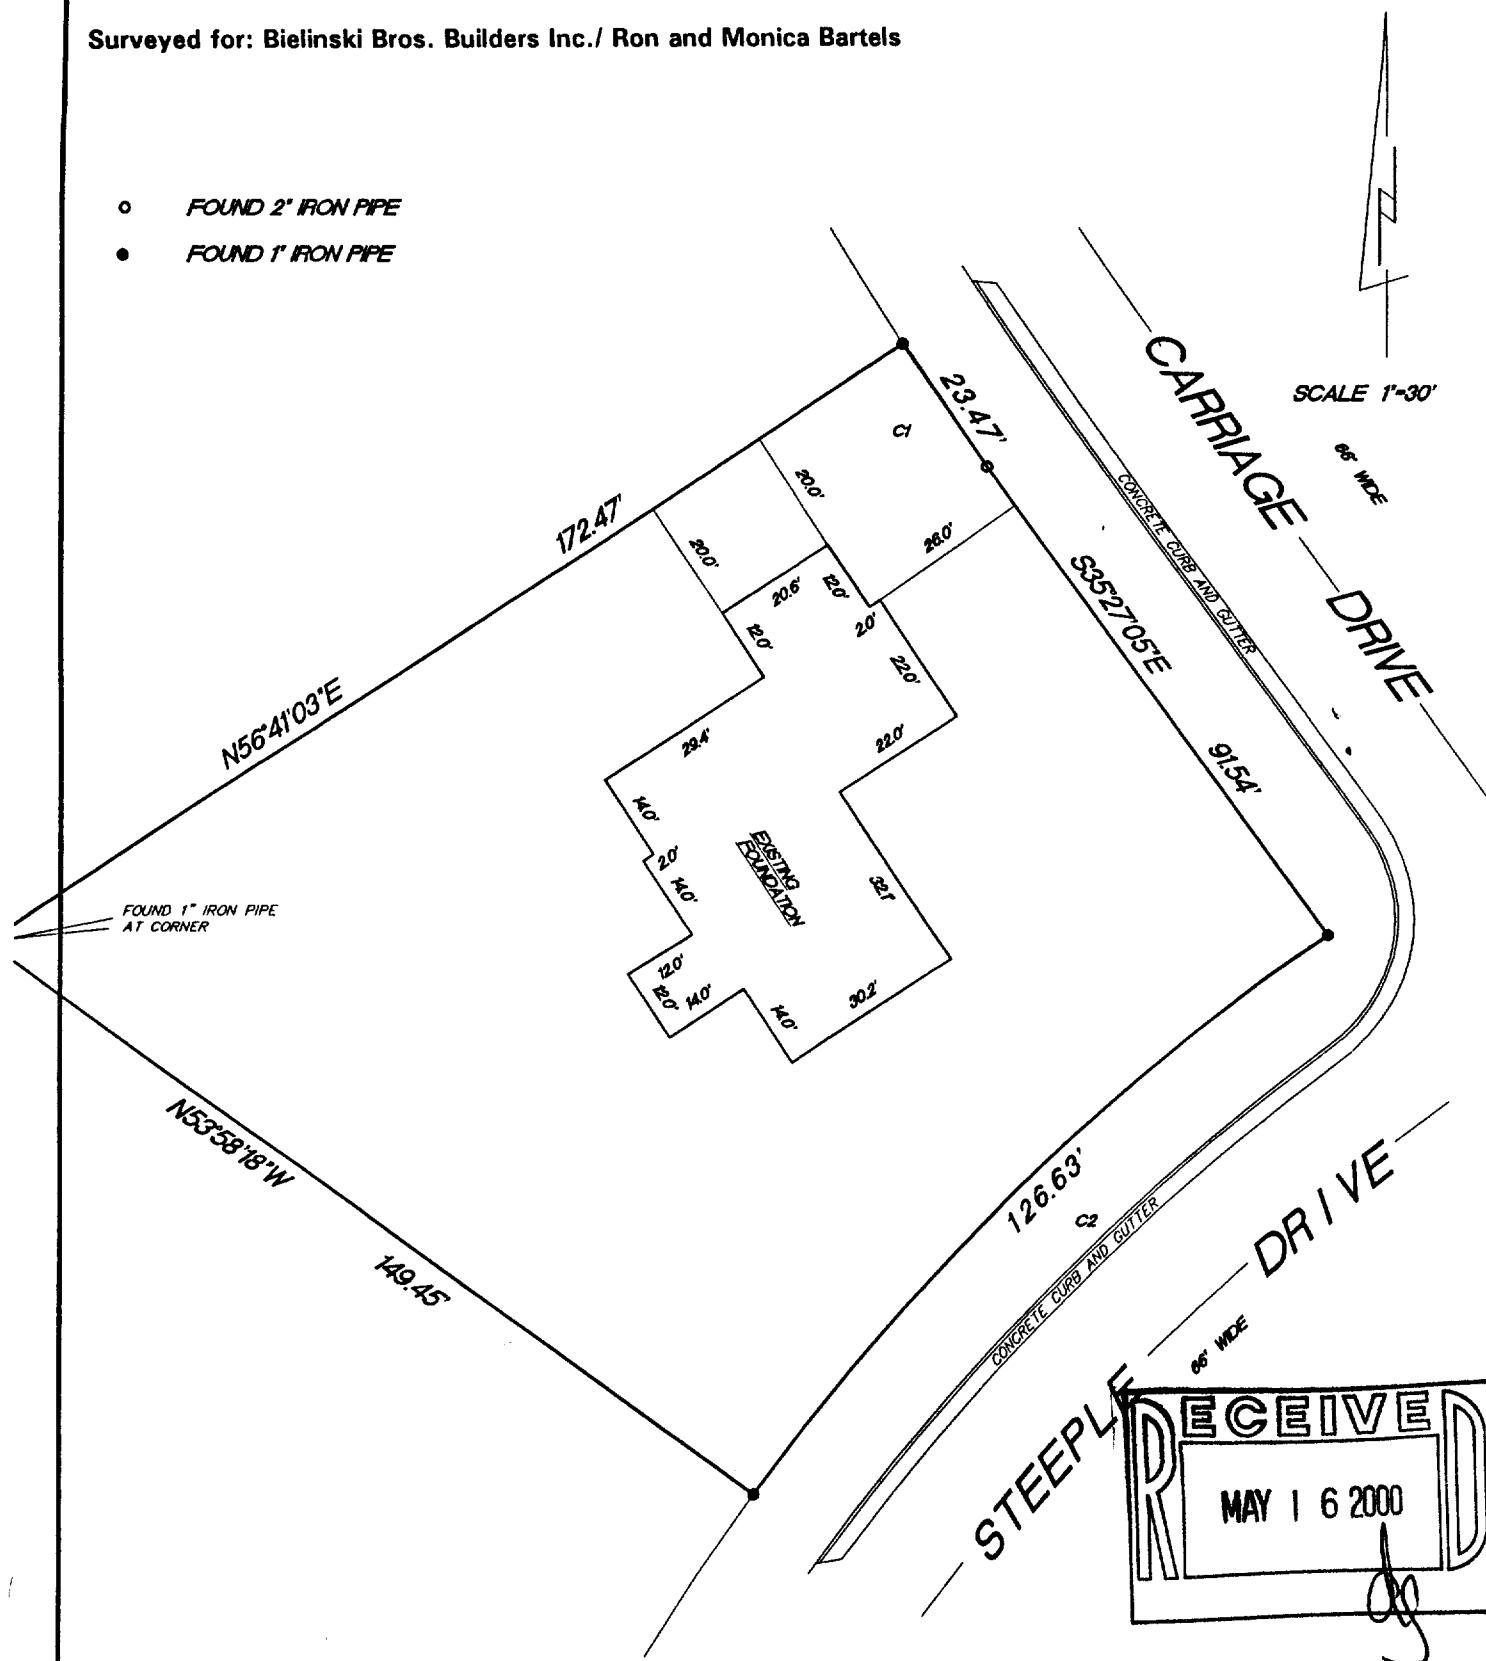


CURVE	RADIUS	LENGTH	CHORD	BEARING	DELTA
C1	629.22'	23.47'	23.47'	N34°22'59"W	02°08'14"
C2	301.76'	126.63'	126.06'	S45°17'21"W	8°31'08"

"This survey is made for the use of the present owners of the property, and also those who purchase, mortgage or guarantee the title thereto within one year from date hereof."

REV. 5/5/00
REV. 3/10/00
1/11/00

99280
JOB NUMBER

THIS IS NOT AN ORIGINAL SURVEY UNLESS THE SEAL IS RED.

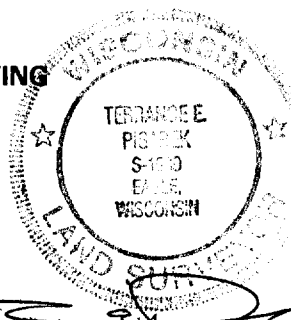

RST07-9

~~003-690~~