



162-62

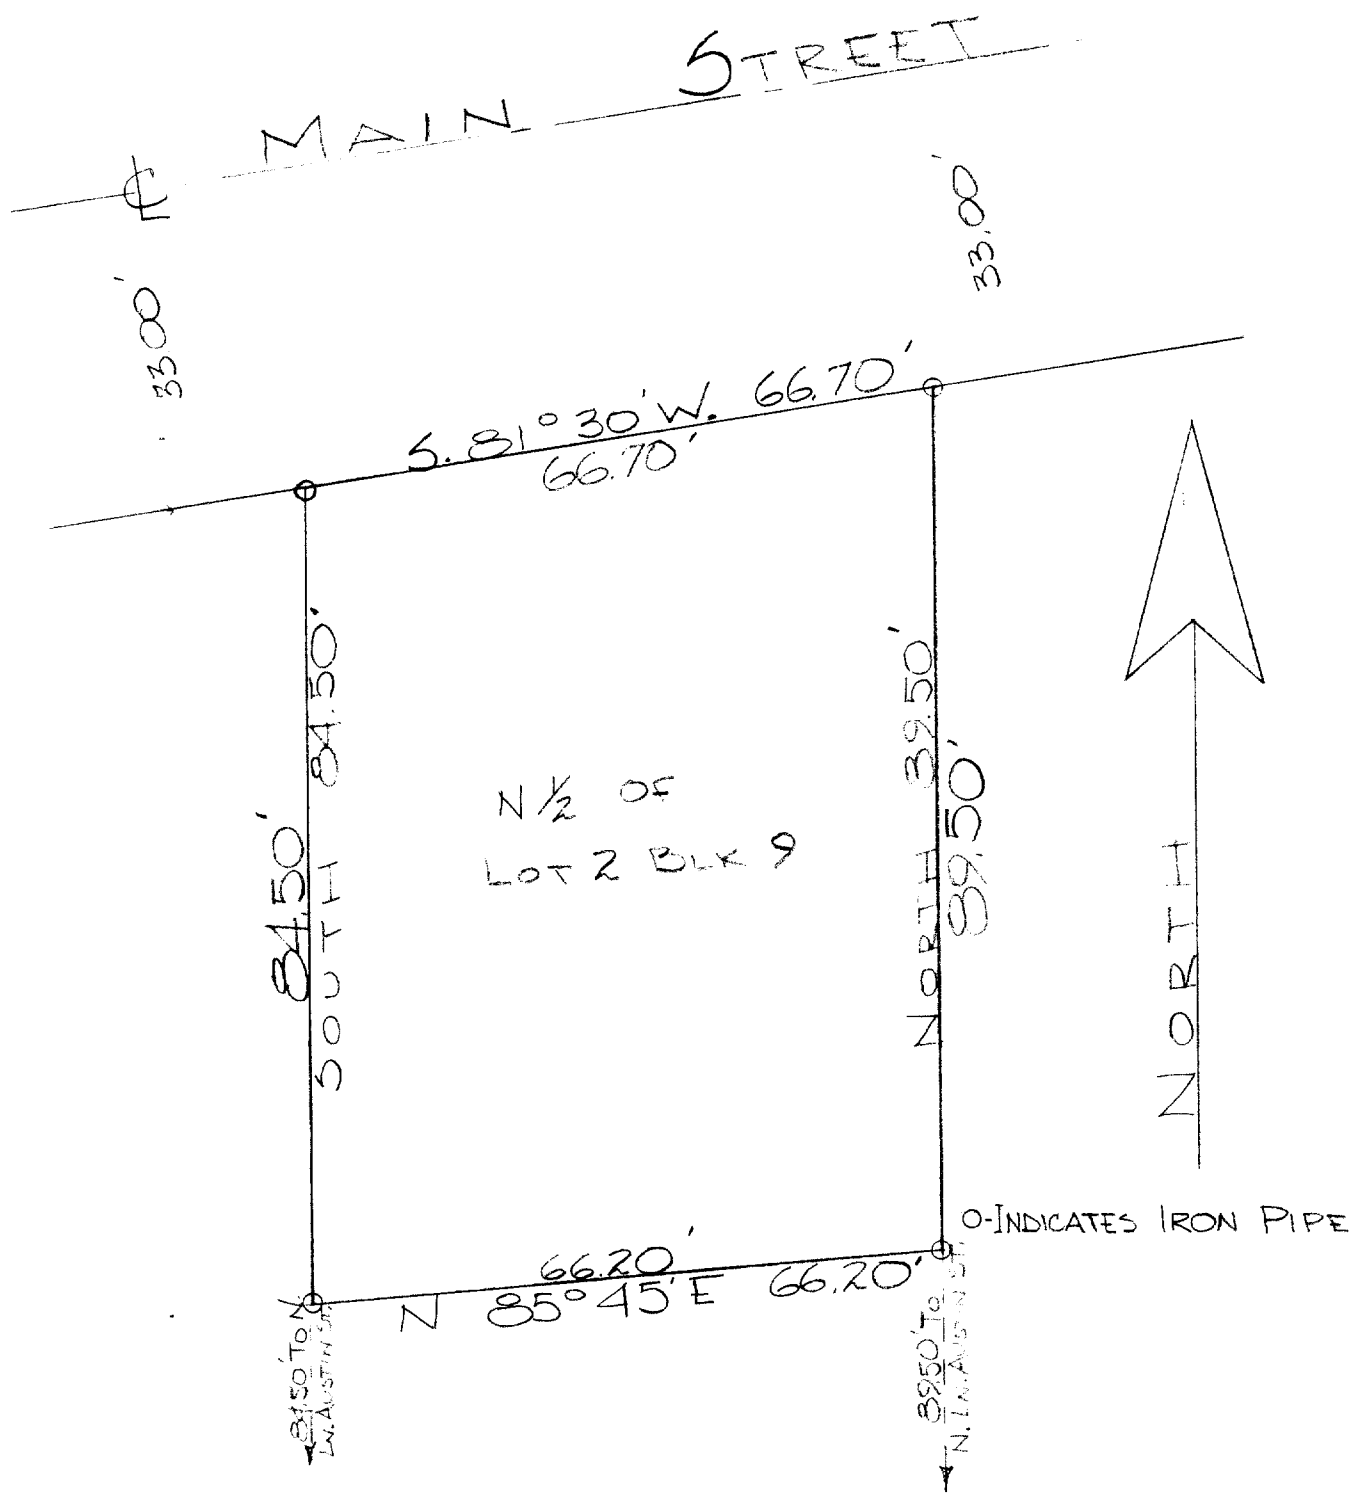

DESCRIPTION: The North $\frac{1}{2}$ of Lot 2 Block 9 in the Original Plat of the Village of East Troy, Walworth County, Wisconsin.

CERTIFICATE: I, James F. Biagi, surveyor, do hereby certify that I have surveyed the property hereon described on this 24th day of April, 1962.

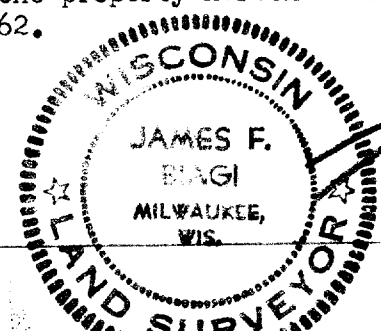

James F. Biagi
James F. Biagi, RLS 272

3-69B