


PLAT OF SURVEY

OF

LOT 50 LINNDALE SUBDIVISION
LOCATED IN THE SE 1/4 NW 1/4 AND THE SW 1/4 OF
SECTION 20, T4N R18E, VILLAGE OF EAST TROY,
WALWORTH COUNTY, WISCONSIN

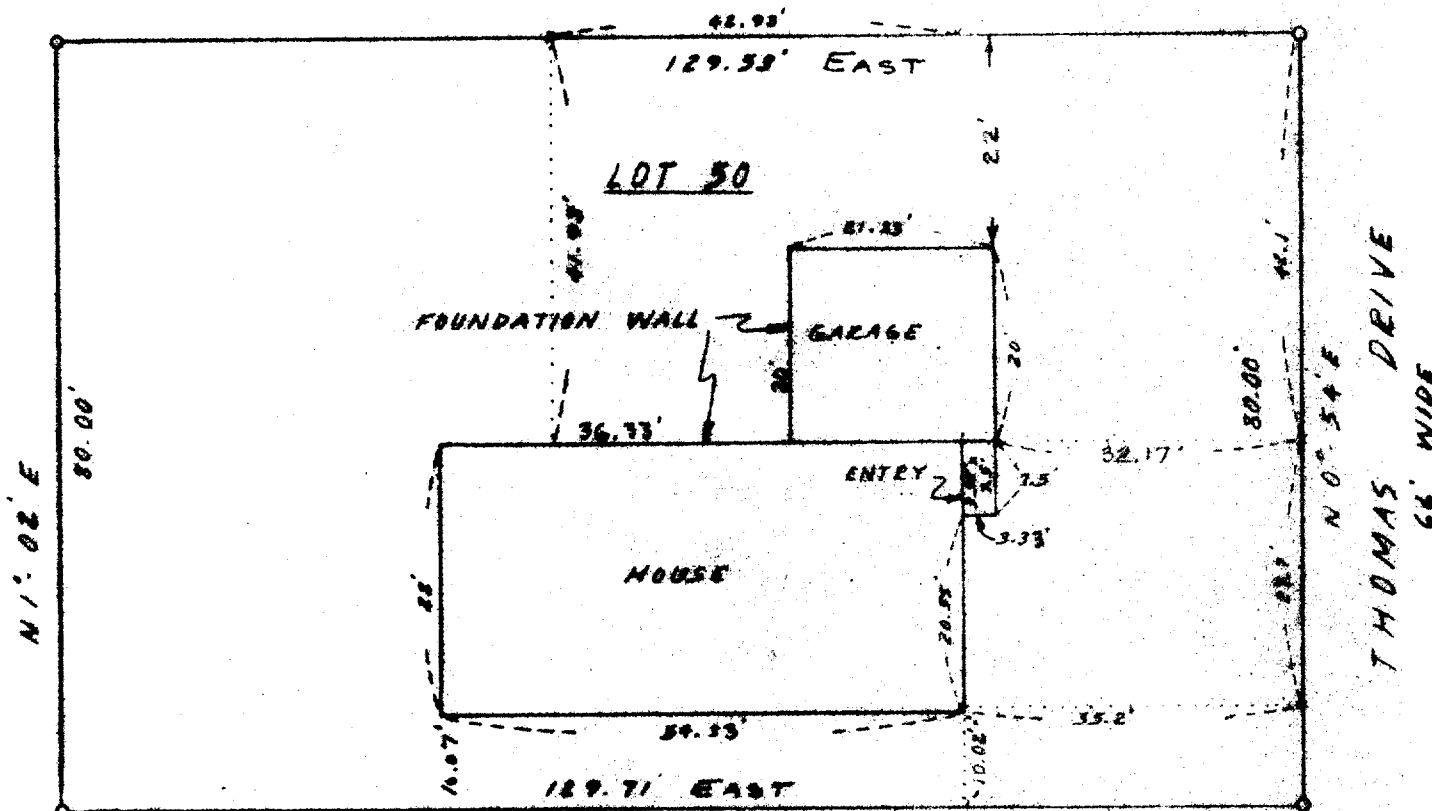

LOT 49



LEGEND


- — Iron Pipe FOUND
 - — Concrete Monument
- Scale 1" = 20'

WE CERTIFY: That we have surveyed the above described property and that the plat shown hereon is an accurate survey and a true representation thereof and correctly shows the exterior boundary lines and all divisions of said property, AND BUILDINGS UNDER CONSTRUCTION THERE ON.

Date 5-16-72
FOR ABSTIDES

Lloyd L. Jensen
LOYD L. JENSEN,

Wisconsin Registered Land Surveyor, No. S-211

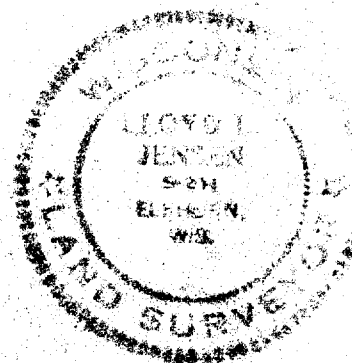

SURVEY AND PLAT BY
JENSEN & JOHNSON, INC.
CIVIL ENGINEERS AND SURVEYORS
Elkhorn, Wisconsin

3-69J