
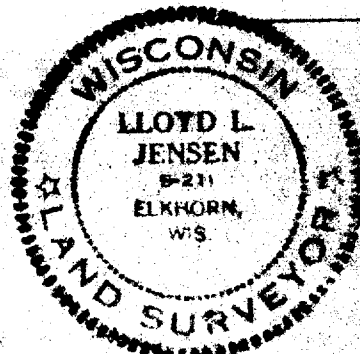


PLAT OF SURVEY

OF

PART OF BLOCK 1, CLARKE'S ADDITION, VILLAGE OF EAST TROY, WALWORTH CO., WIS.

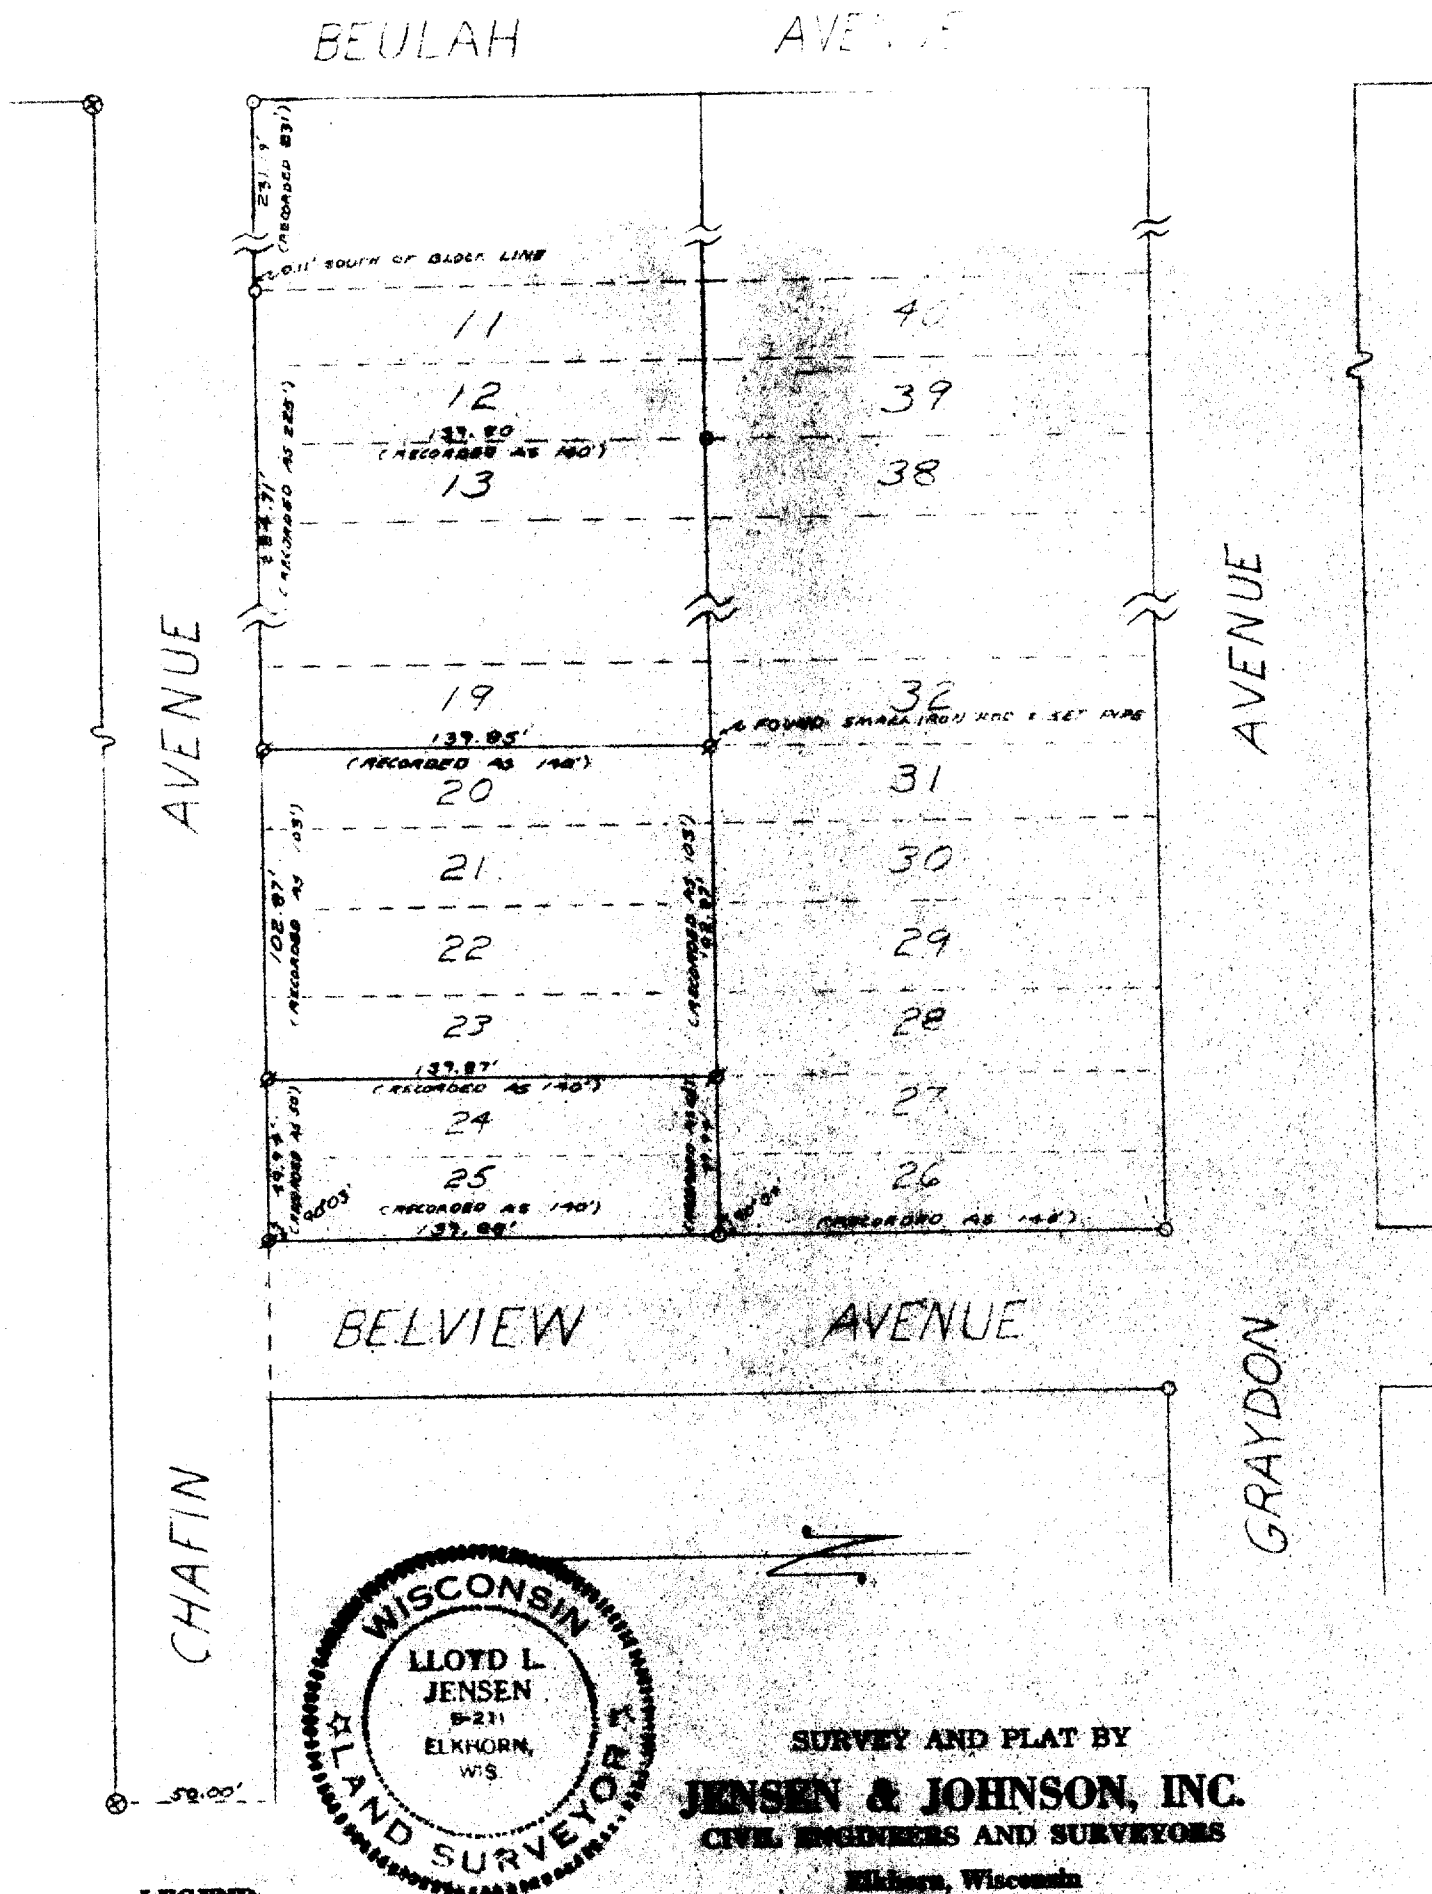

SURVEY AND PLAT BY
JENSEN & JOHNSON, INC.
CIVIL ENGINEERS AND SURVEYORS
Elkhorn, Wisconsin

- LEGEND**
- — Iron Pipe — SET
 - — Concrete Monument
 - Scale 1" = 60'

WE CERTIFY: That we have surveyed the above described property and that the plat shown hereon is an accurate survey and a true representation thereof and correctly shows the exterior boundary lines and all divisions of said property.

Date MAY 1971

Lloyd L. Jensen
LLOYD L. JENSEN,

Wisconsin Registered Land Surveyor, No. S-211

3-71J

CA-7
CA-8