


PLAT OF SURVEY

OF

RAILROAD RIGHT OF WAY THROUGH LOT 2,
OF BLOCK 2, OF THE ORIGINAL PLAT OF THE
VILLAGE OF EAST TROY, WALWORTH COUNTY,
WISCONSIN

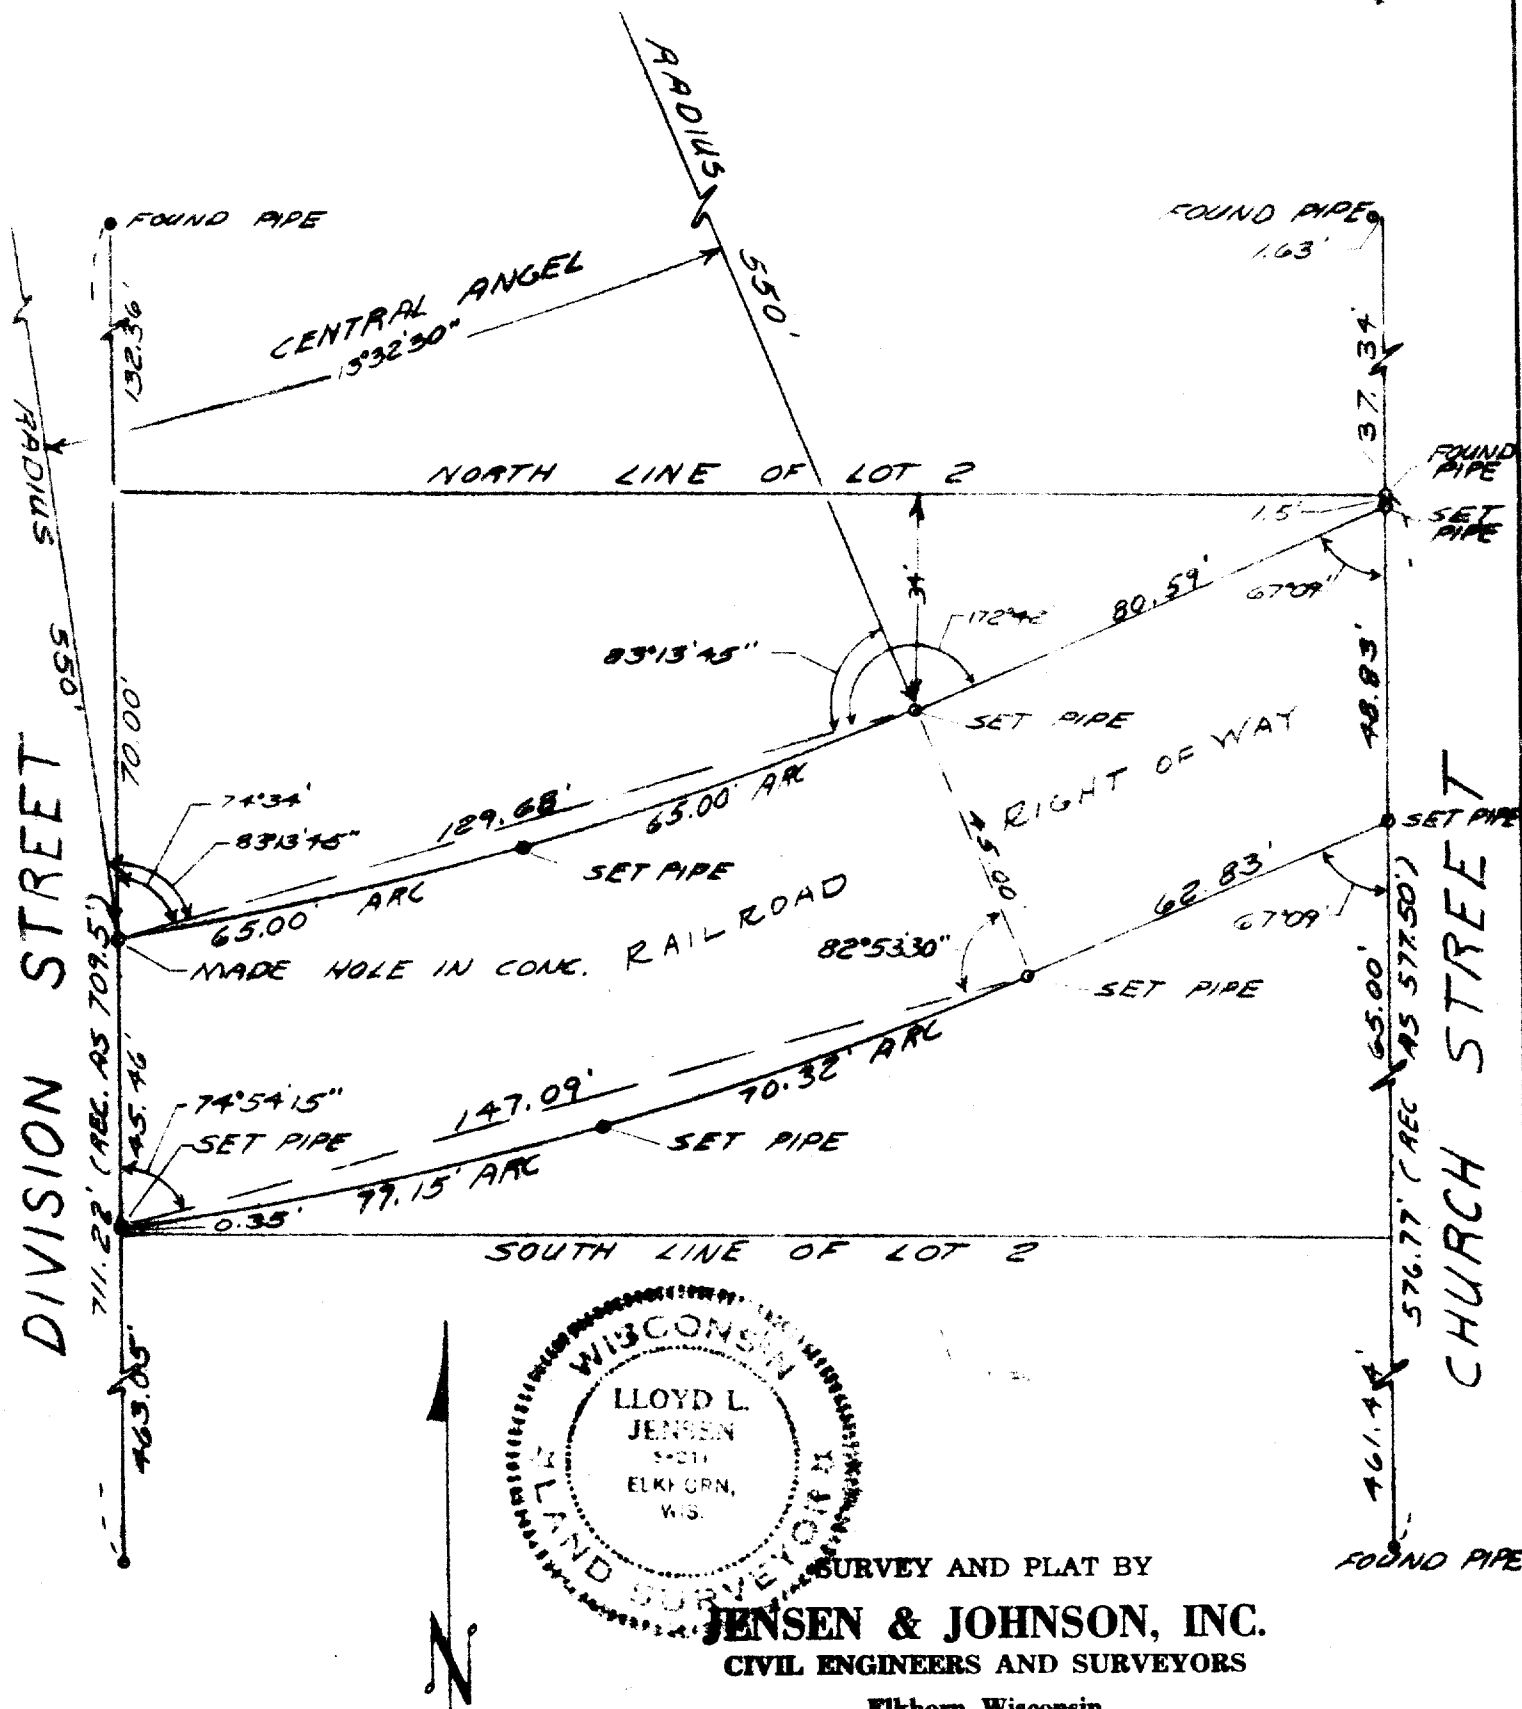

3-74J