


#80/72

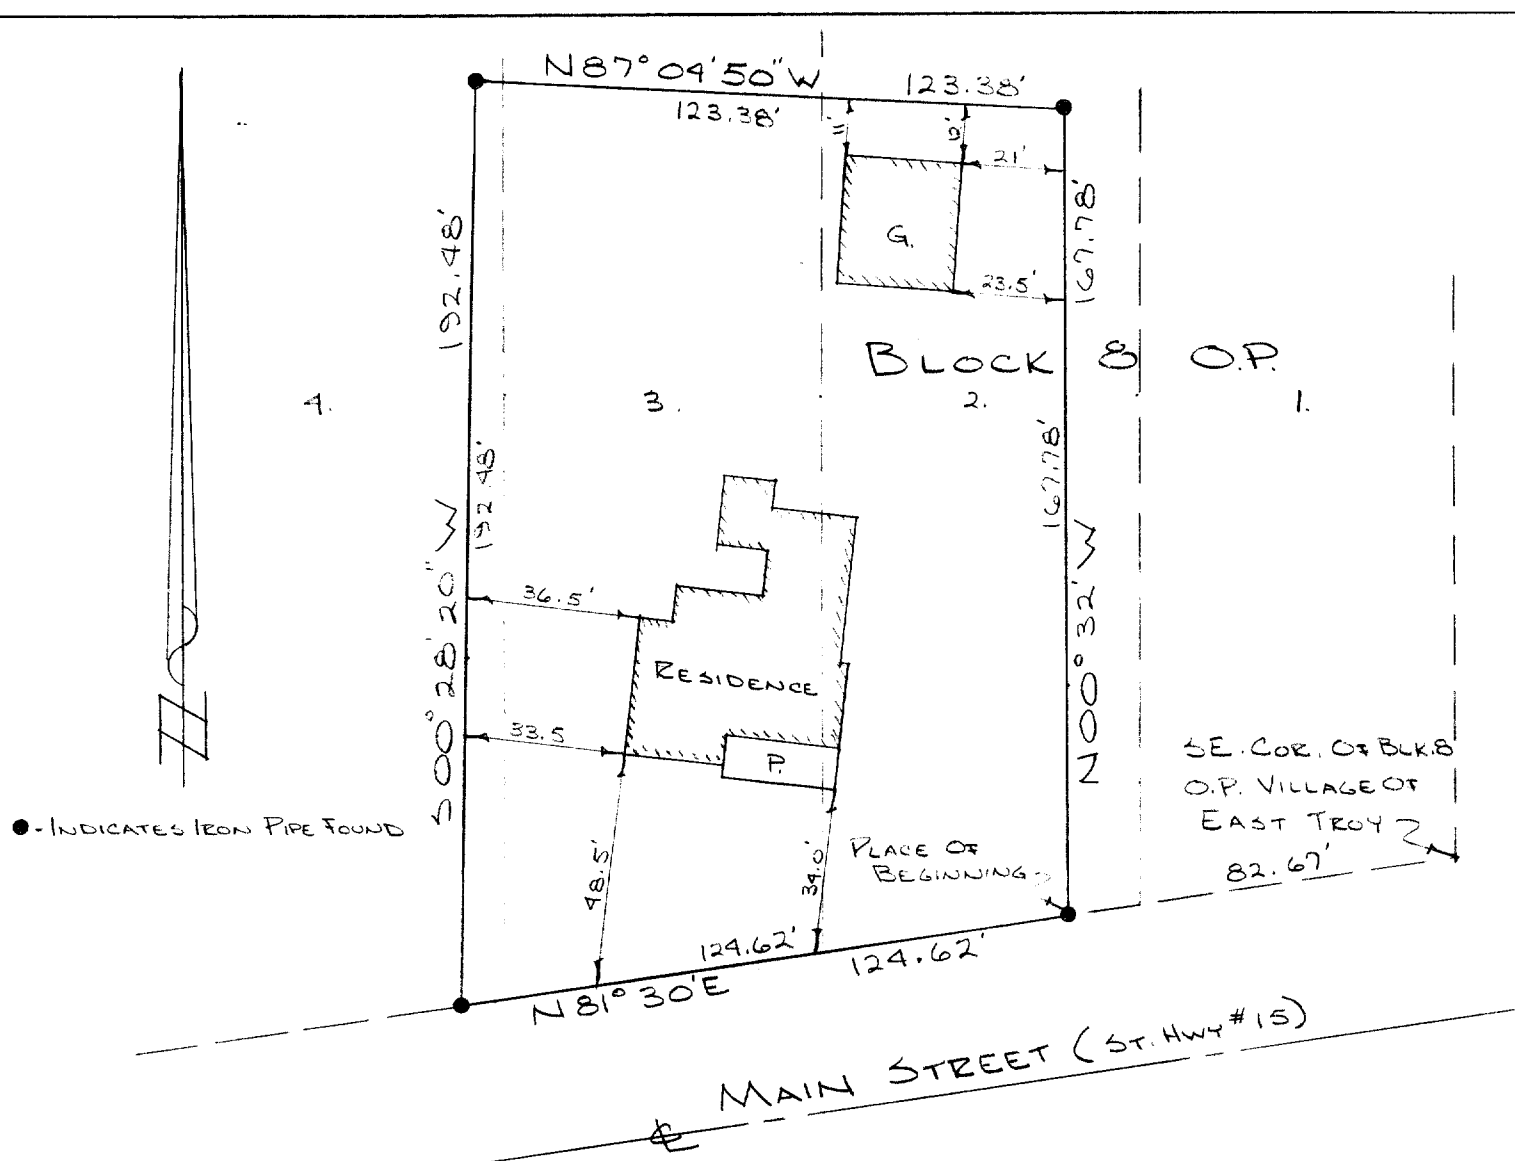

DESCRIPTION:


Portions of Lots 2, 3, & 4, Block 8, Original Plat of the Village of East Troy, Walworth County, Wisconsin, Described as follows to-wit: Commencing at the SE. Corner of said Block 8 thence Southwesterly 82.67 feet along the North line of Main Street to the place of beginning; thence N 00° 32' W 167.78 feet; thence N 87° 04' 50" W 123.38 feet; thence S 00° 28' 20" W 192.48 feet to the North line of said Main Street; thence N 81° 30' E 124.62 feet along said North line to the place of beginning.

CERTIFICATE:

I, James F. Biagi, Surveyor, do hereby certify that I have surveyed the lands hereon described.

August 1, 1972

James F. Biagi
James F. Biagi RLS #272

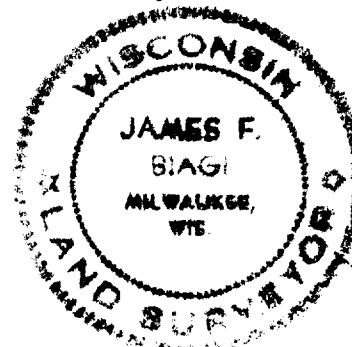

3-75B