


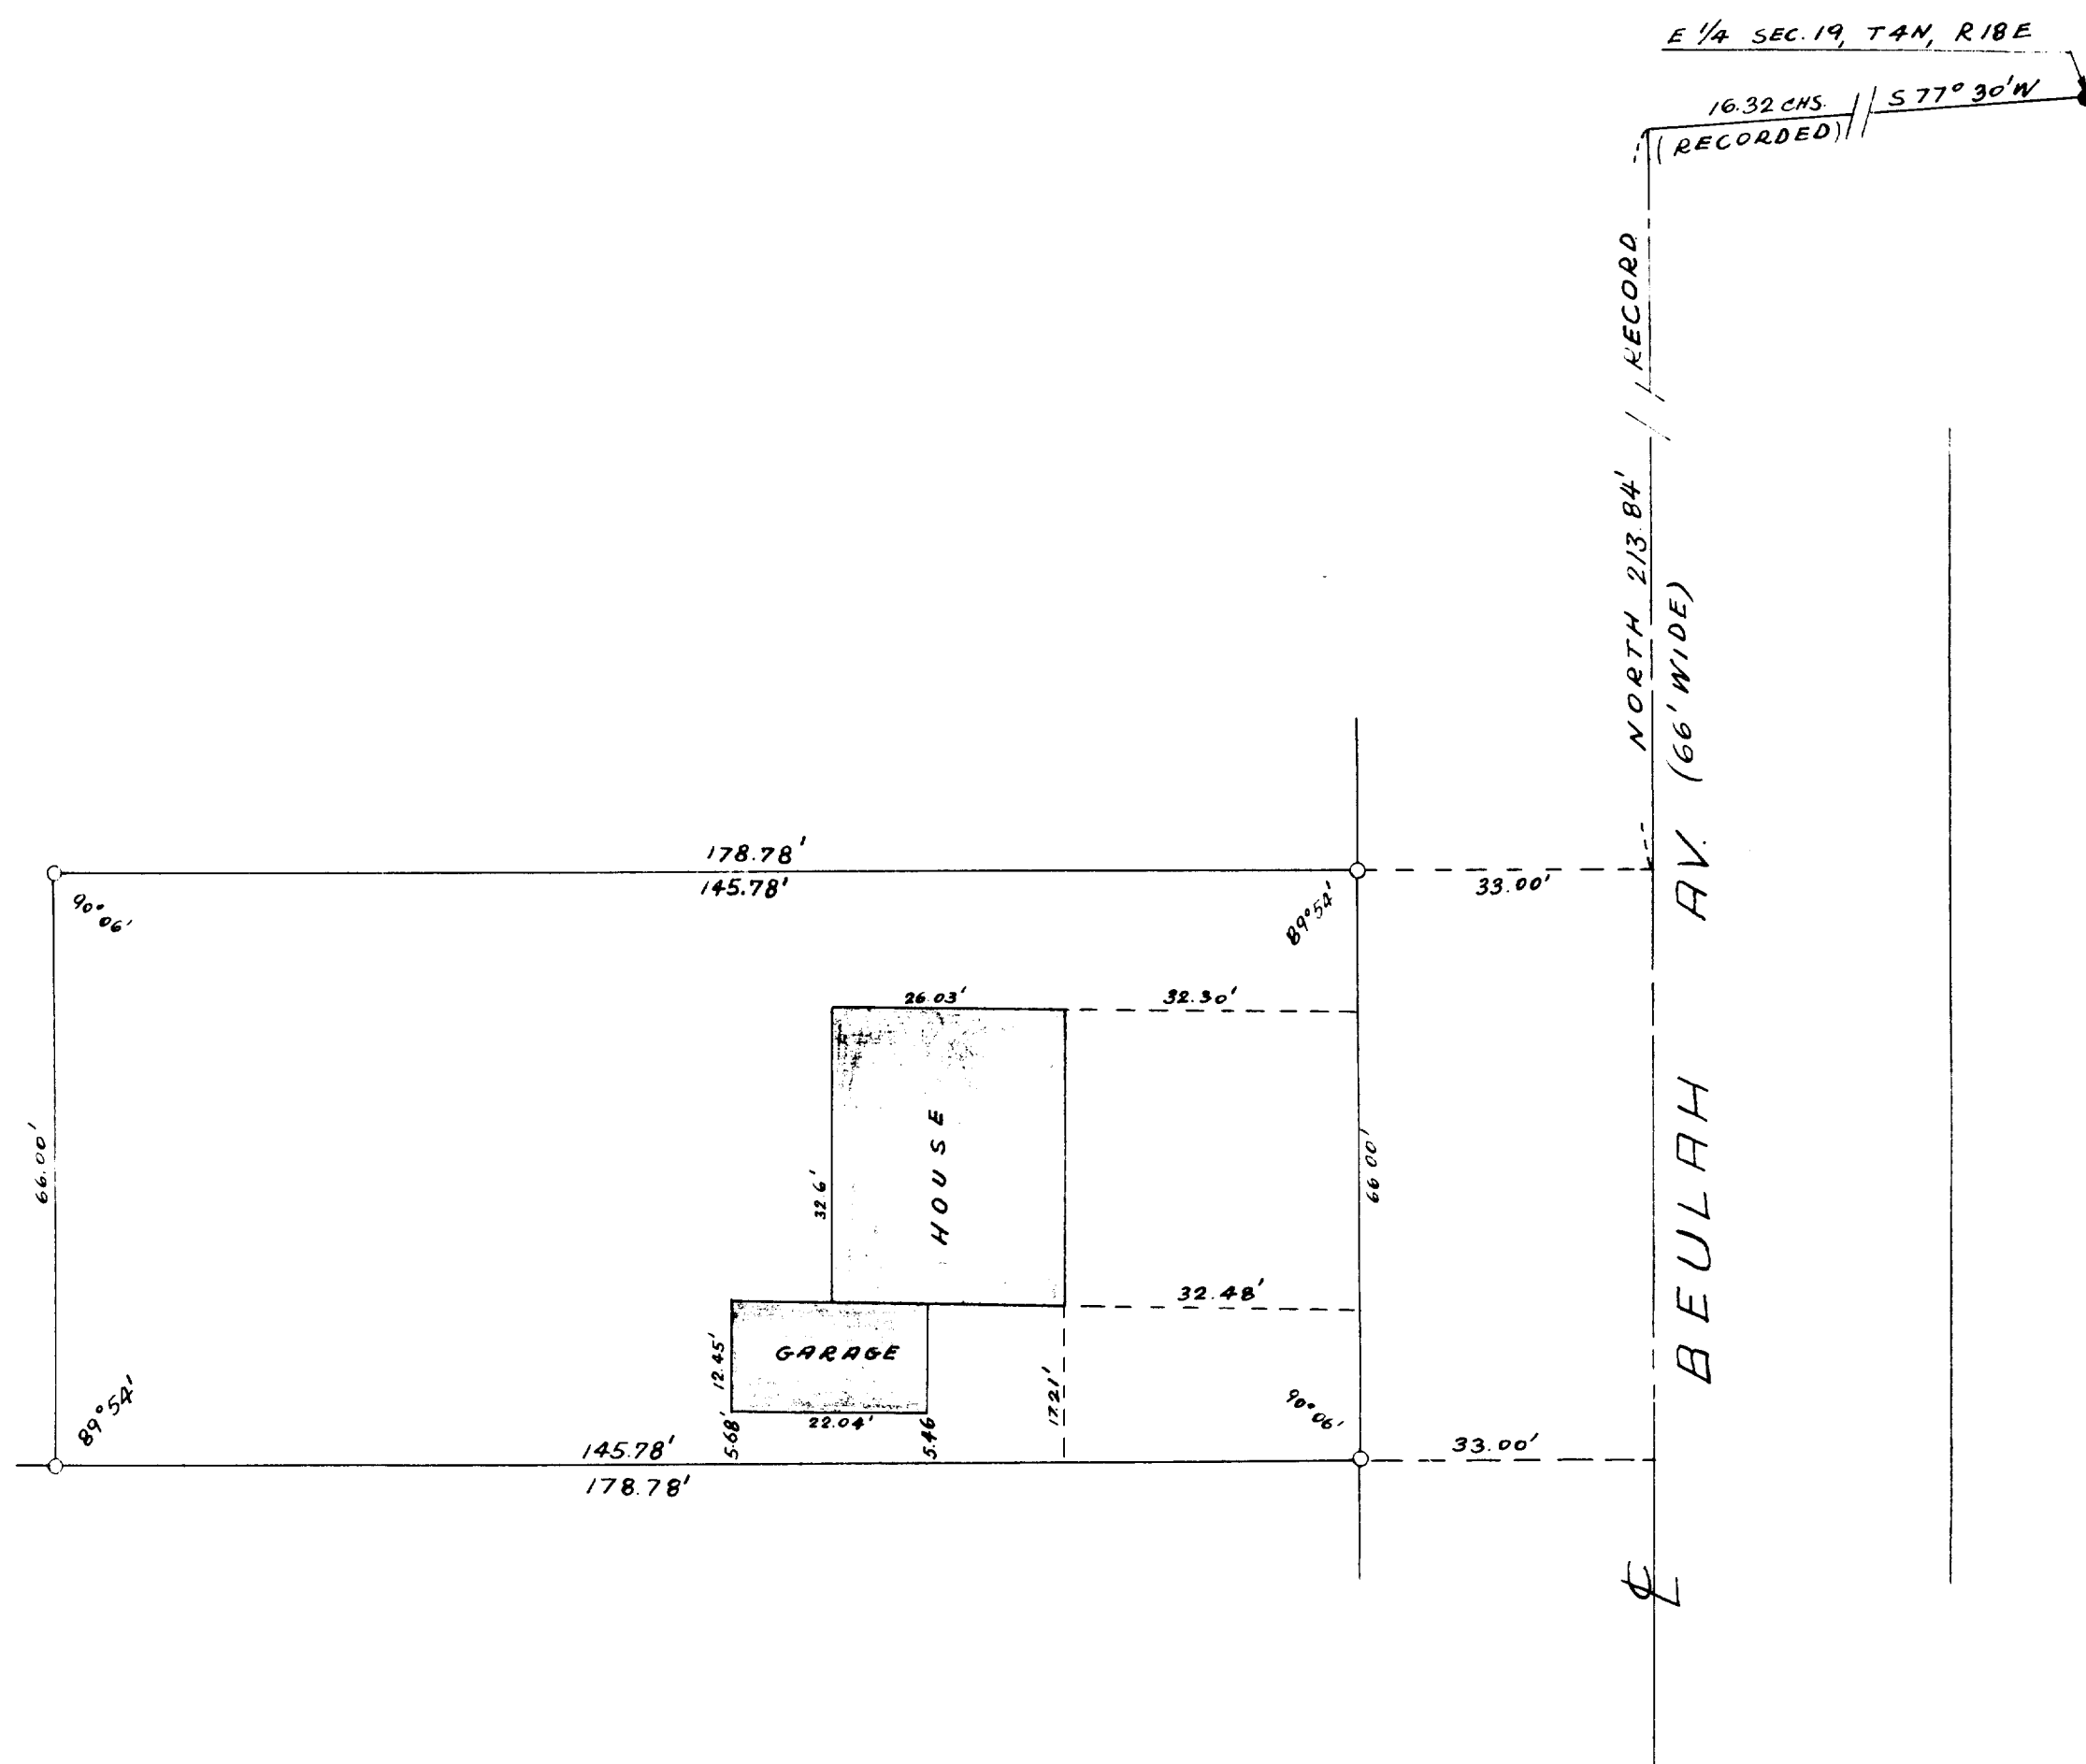

PLAT OF SURVEY OF

A PARCEL OF LAND LOCATED IN THE
SE 1/4 OF SEC. 19, T4N, R18E, VILLAGE OF
EAST TROY, WALWORTH COUNTY, WISCONSIN

Joseph F. Jensen
SURVEYOR

SCALE 1" = 20'

DATE APRIL 1973

3-76J

UP 51A

UP-49