


SURVEYING

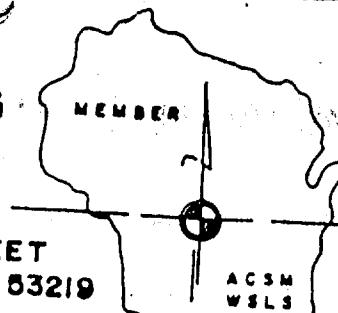

ASSOCIATES, INC.

2819 SOUTH 43rd STREET  
MILWAUKEE, WISCONSIN 53219

FREDERICK W. SHIBILSKI RLS  
(414) 321-5851


PLAT OF SURVEY  
-of-

following described real estate in the Village of East Troy, Walworth County, Wisconsin, wit: Commencing 3.61 chains West of the North and South  $1/8$  section line in the Southeast of Section 19, Town 4 North, Range 18 East, in the Village of East Troy, at the Northwest corner of Julius Bemis land, thence South along said Bemis, West line 6.58 chains to the center of highway, thence South  $81^{\circ}$  West along the center of highway, 1.56 chains, thence North  $43^{\circ}$  chains to the North line of land conveyed by P.O. Griste and wife to said L.M. Keats, thence East 1.53  $1/2$  chains along said Keat's North line to the place of beginning, excepting reserving, however, the North 217 feet thereof.

vey for: Wauwatosa Mortgage Corporation

vey location: 3022 W. Main Street


Buyer: Joseph and Kathleen Hawley

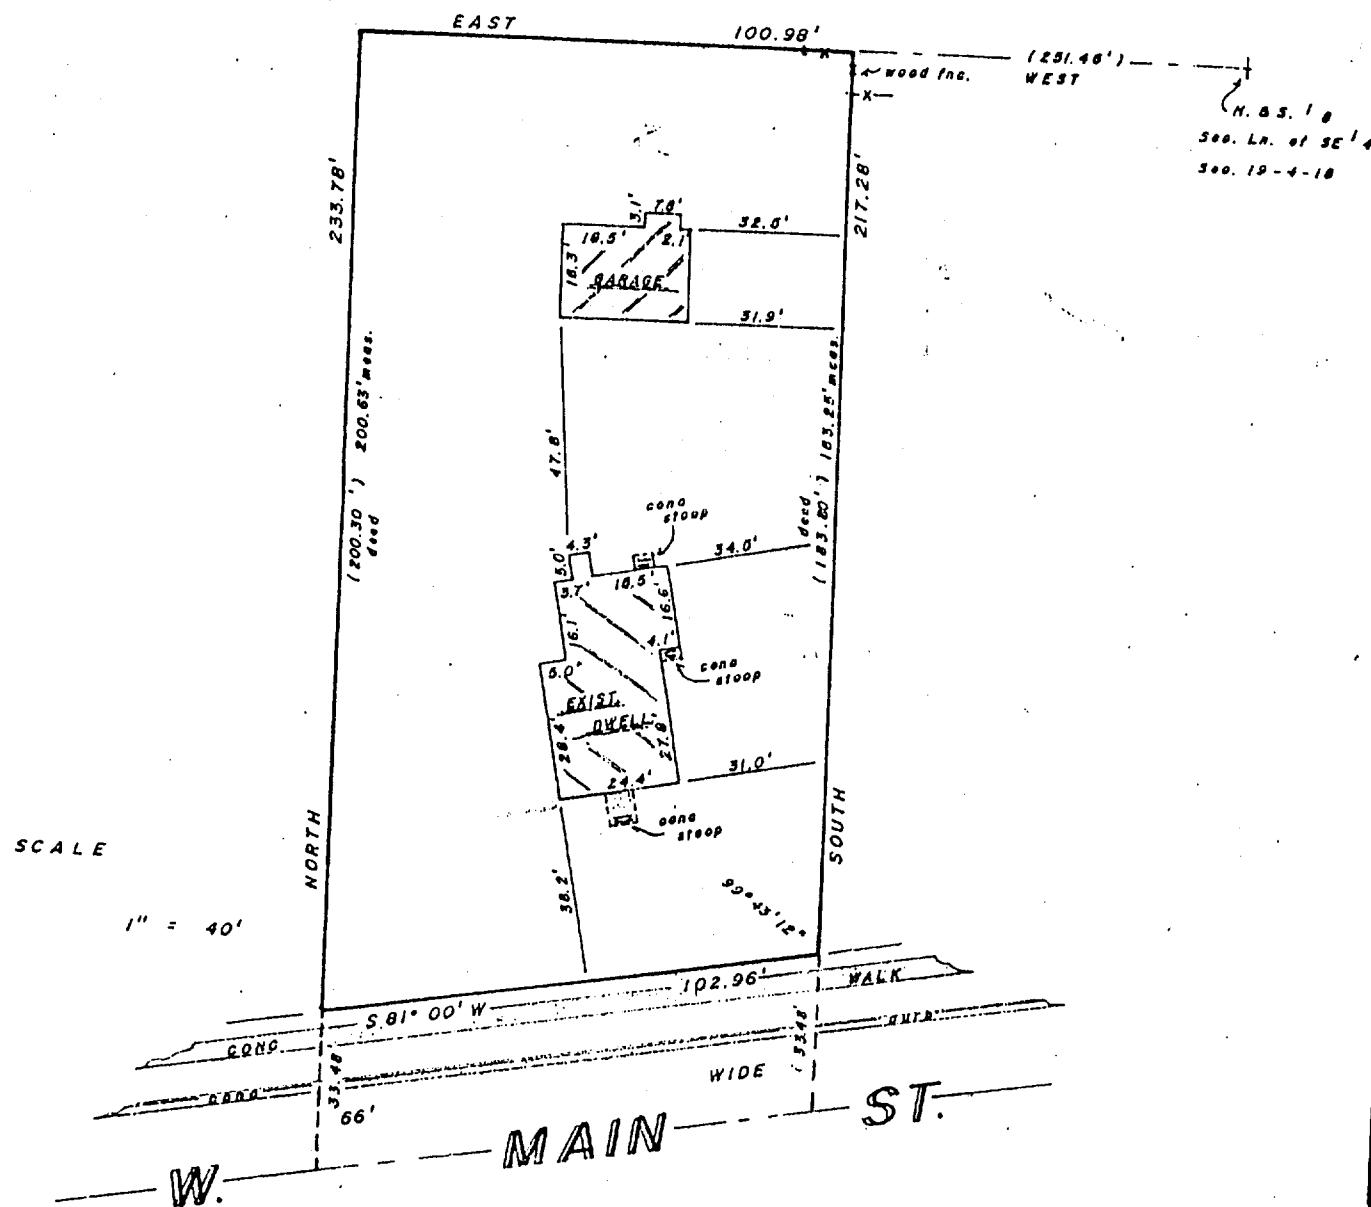

I hereby certify that I have surveyed the above described property and that the above map is a true representation and shows the size and location of the property, its boundaries, the location of all visible structures, dimensions of all principal buildings thereon, boundary apparent easements, roadways and visible encroachments, if any.

Survey is made for the use of the present owners of property, and also those who purchase, mortgage, or sue the title thereto within one year from date.

MONUMENTATION HAS BEEN WAIVED IN ACCORDANCE WITH A-E 3.01(b) OF THE WISCONSIN ADMINISTRATIVE CODE.

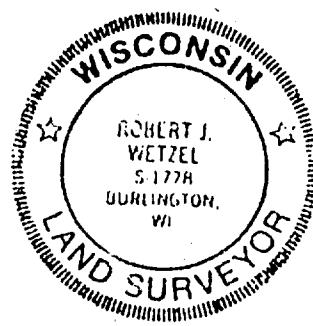

003-777

RXUP-113

Frederick W. Shibilski  
WISCONSIN REGISTERED LAND SURVEYOR

APR. 25, 1984

DATE

FIELD WORK BY JWS, SJS

DRAWN BY DJS

4300

JOB NUMBER