


PLAT OF SURVEY

OF

Part of Lot 3 of P.O. Gristle's Addition to the Village of East Troy, Walworth County, Wisconsin

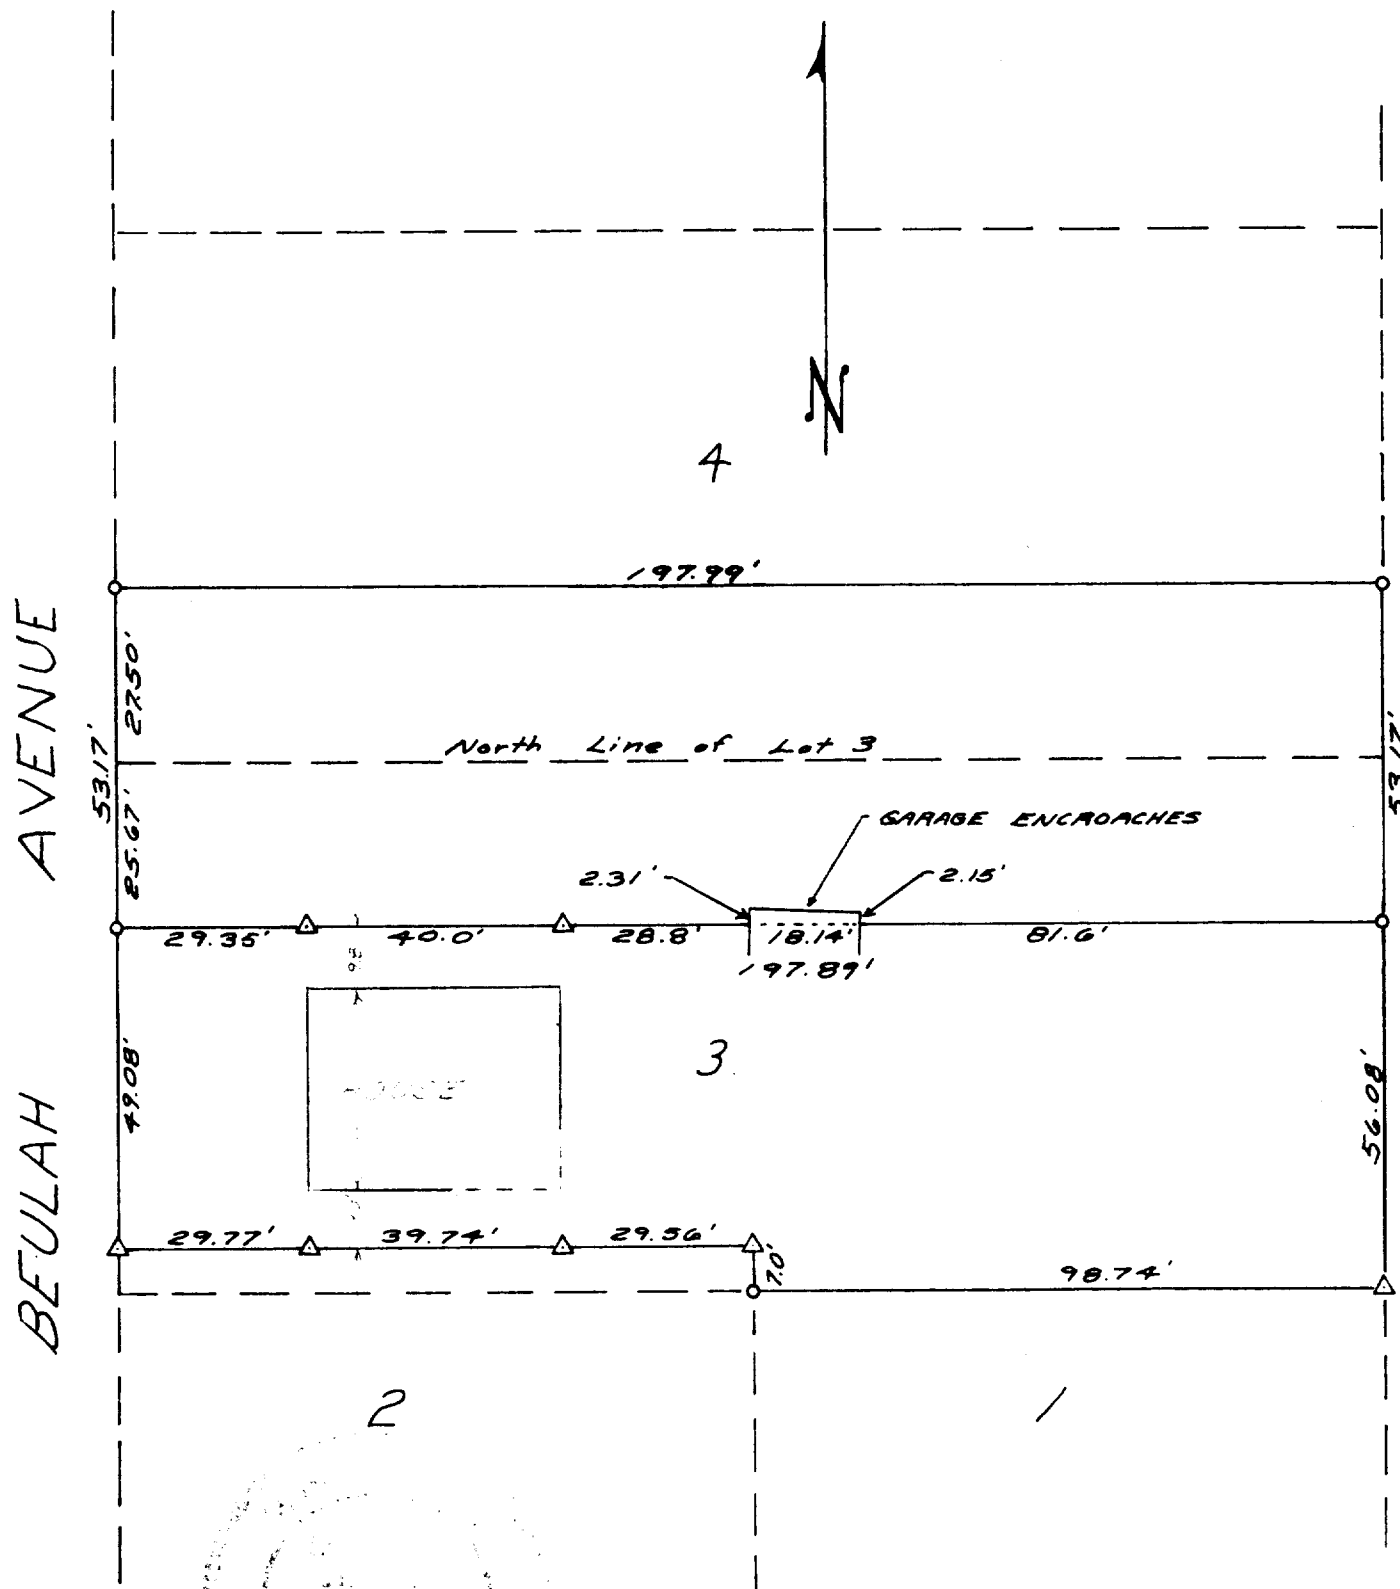

SURVEY AND PLAT BY

JENSEN & JOHNSON, INC.

CIVIL ENGINEERS AND SURVEYORS

Elkhorn, Wisconsin

LEGEND

- — Iron Pipe Found
- — Concrete Monument
- Scale 1" = 30'
- △ — Iron Rod Set

WE CERTIFY: That we have surveyed the above described property and that the plat shown hereon is an accurate survey and a true representation thereof and correctly shows the exterior boundary lines and all divisions of said property.

Date 2 APRIL 1973

Lloyd L. Jensen
LLOYD L. JENSEN,

Wisconsin Registered Land Surveyor, No. S-211