
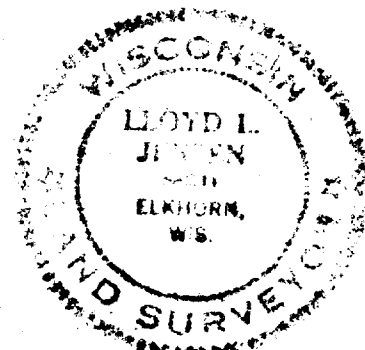


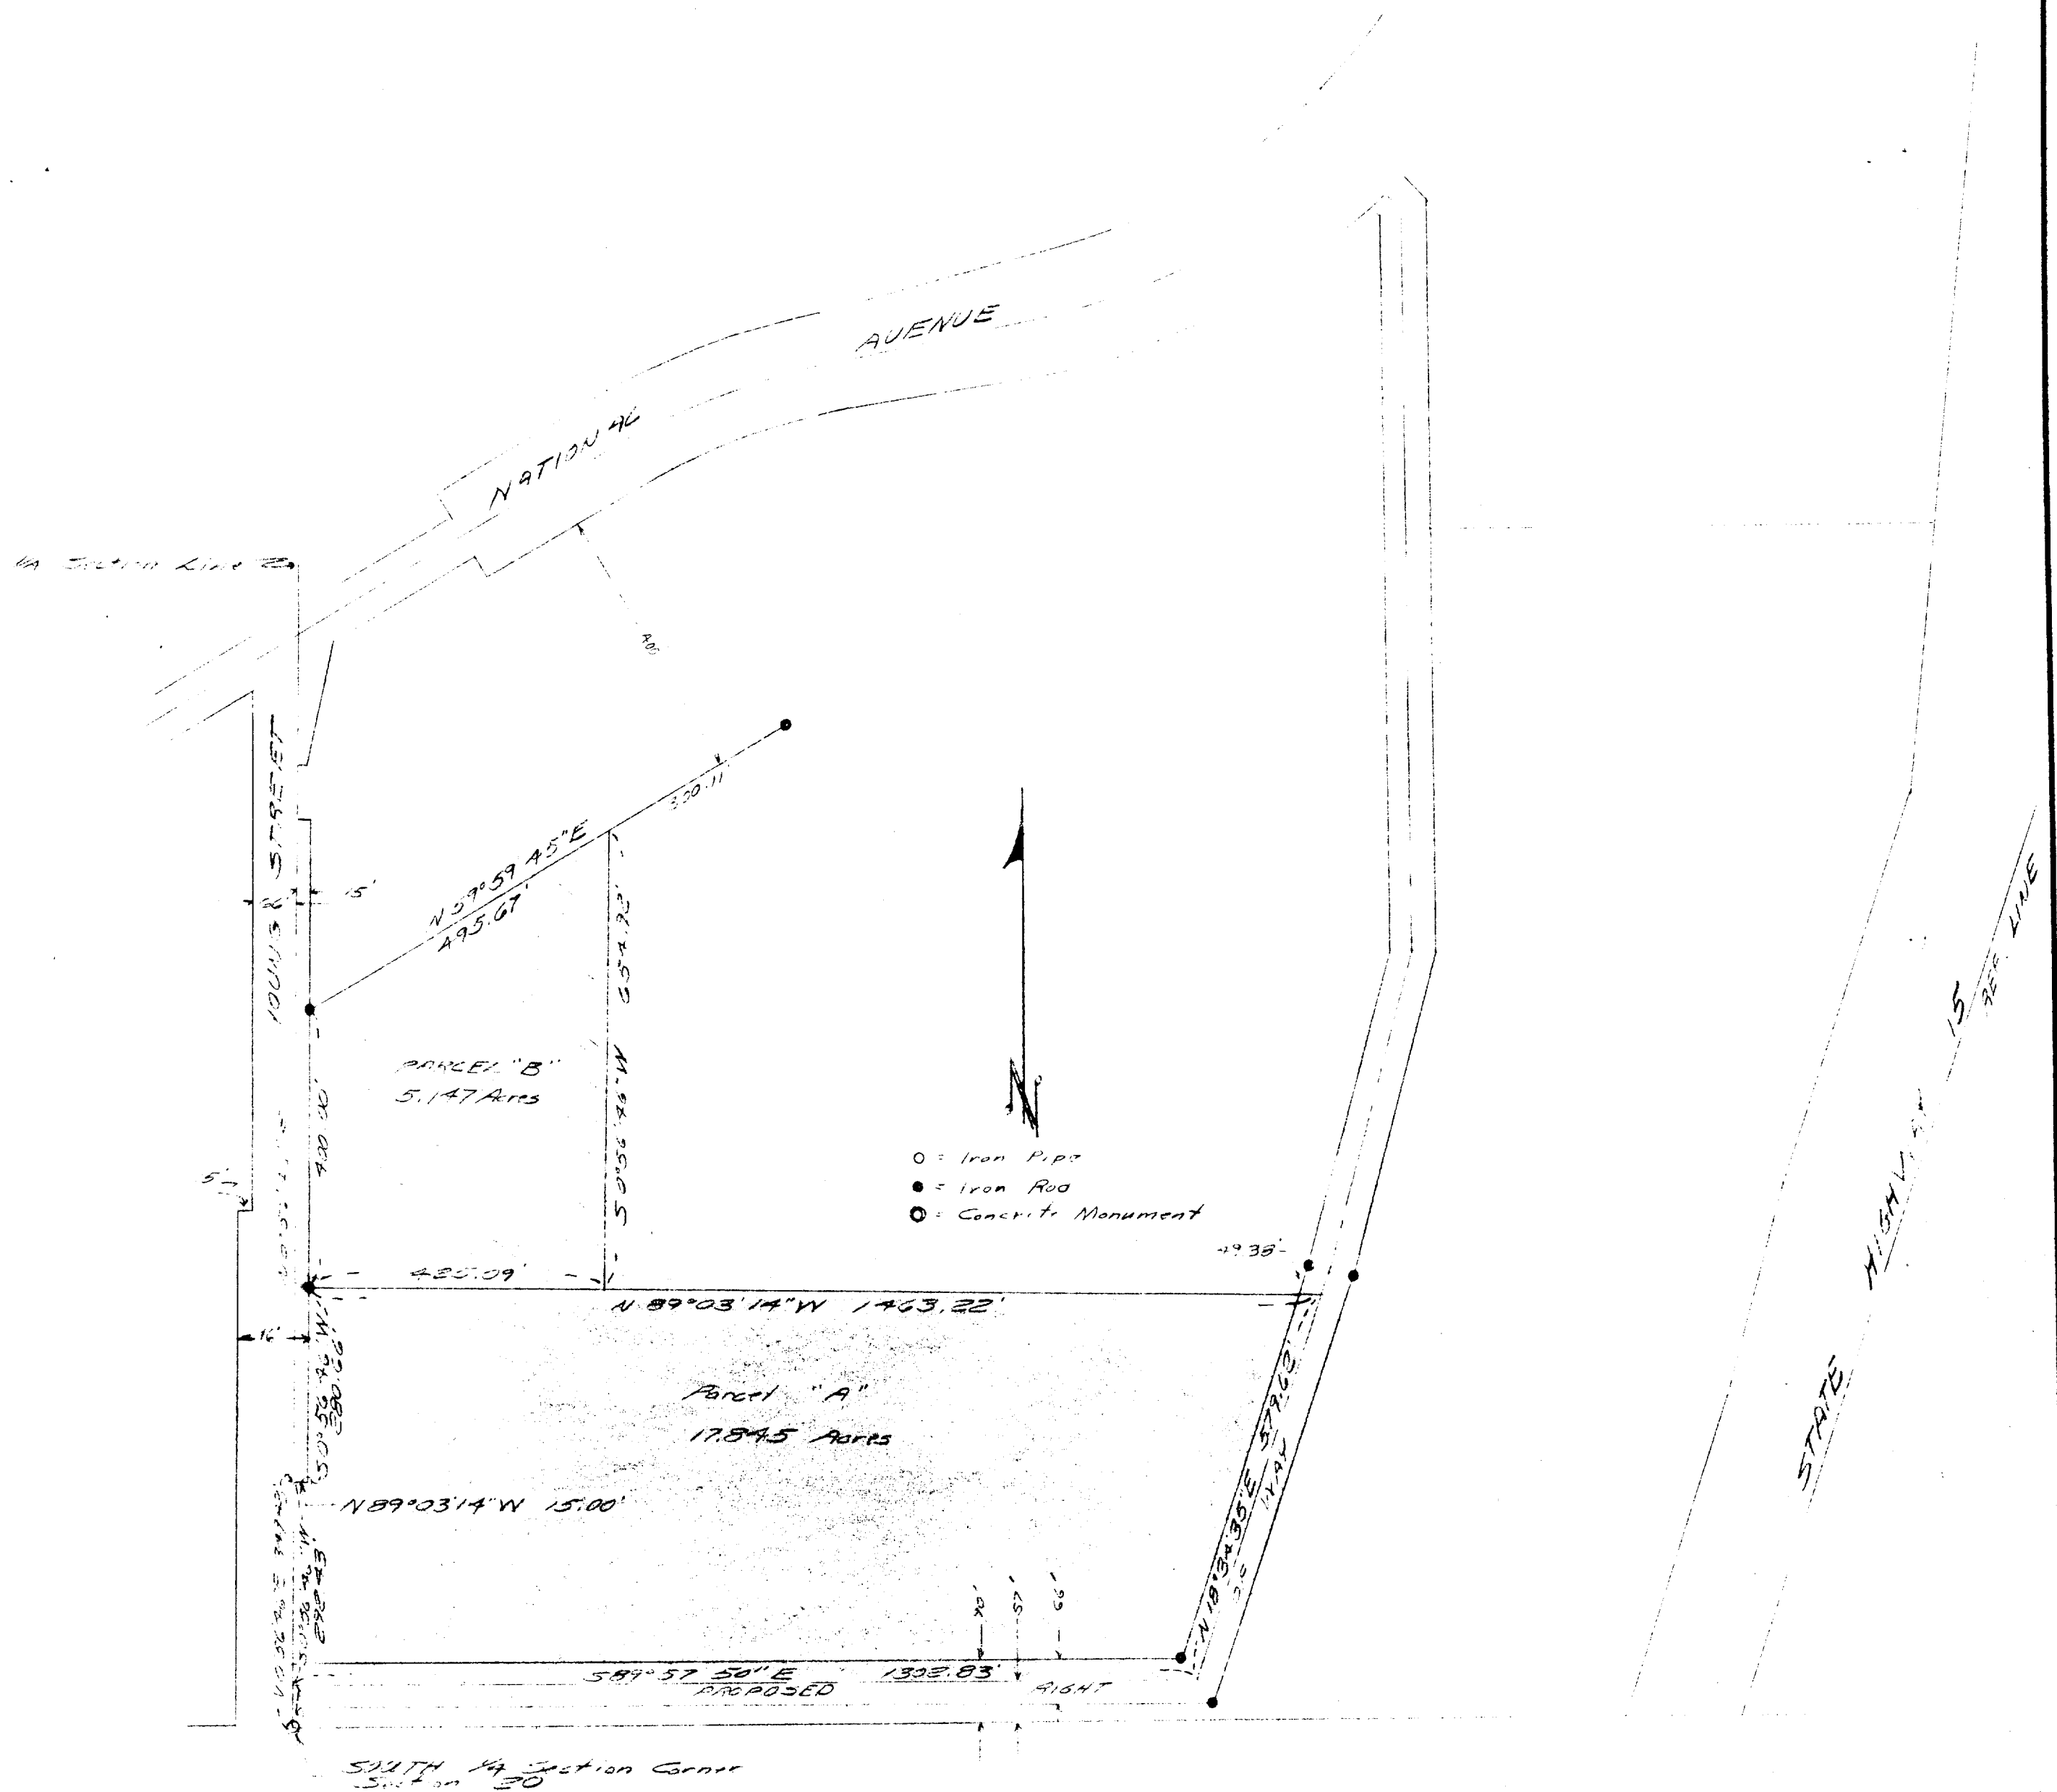

PLAT OF SURVEY OF

PART OF THE SOUTHEAST 1/4 OF
SECTION 30, TOWNSHIP 4 NORTH,
RANGE 19 EAST, VILLAGE OF
EAST TROY, WINNEBAGO COUNTY,
WISCONSIN.

Lloyd L. Jensen
SURVEYOR

SCALE 1" = 300'

DATE 31 JUL 1973