




Part of Lots 3 and 4, Block 12, Original
Plat of the Village of East Troy, Wal-
worth County, Wisconsin and described
as follows: Commencing at the Southwest
corner of said Lot 3; thence North 25.50
feet to the place of beginning; thence
S 89°57'32" E 121.97 feet; thence South
75.06 feet; thence S 89°01' W 71.73 feet;
thence North 20.00 feet; thence S 88°43' W
50.27 feet; thence North 57.50 feet to
the place of beginning.

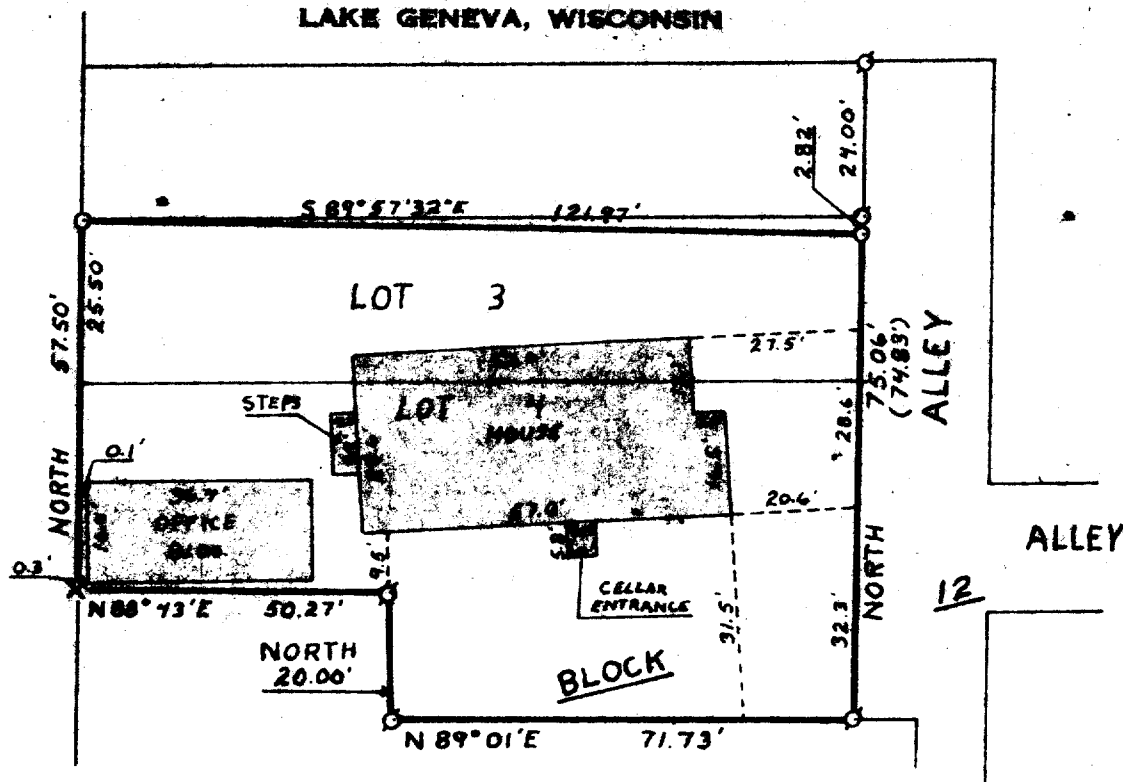

SCALE - 1" = 30'

φ - IRON PIPE FOUND
 ○ - IRON PIPE PLACED
 ● - CONCRETE MONUMENT
 x - SPIKE
 () - AS PLATTED

I, HAROLD H. KOLB, DO HEREBY CERTIFY THAT I HAVE SURVEYED THE PROPERTY HEREON DESCRIBED ACCORDING TO THE OFFICIAL RECORDS, AND THAT THE PLAY HEREON IS A CORRECT REPRESENTATION OF THE LOT LINES.

Harold H. Kolb
HAROLD H. KOLB
WISCONSIN REGISTERED LAND SURVEYOR, S-187
DATE Sept. 27, 1973

