


# PLAT OF SURVEY

LOT 177, STERLING OAKS ADDITION NO. 1, being a part of the Northwest 1/4 and Southwest 1/4 of the Northeast 1/4 and a part of the Northeast 1/4 and Southeast 1/4 of the Northwest 1/4, all in Section 20, Town 4 North, Range 18 East, Village of East Troy, Walworth County, Wisconsin.


Surveyed for: Bielinski Bros. Builders Inc./Kevin and Lucy Trinastic

66' WIDE

—MICHELE LANE—

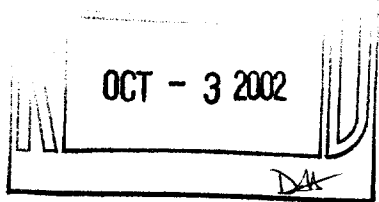

CONCRETE CURB AND GUTTER

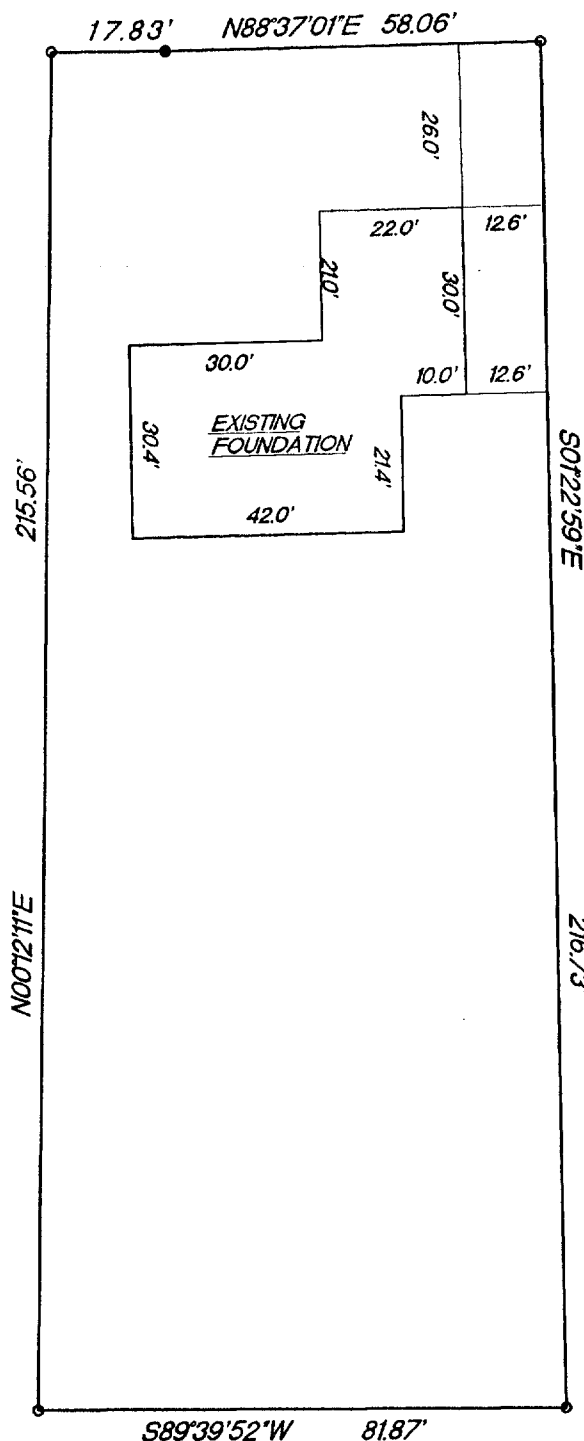

SCALE 1"=30'

- FOUND 1" IRON PIPE
- FOUND 2" IRON PIPE

| RADIUS  | LENGTH | CHORD  | BEARING     | DELTA     |
|---------|--------|--------|-------------|-----------|
| 644.04' | 17.83' | 17.83' | N89°24'36"E | 01°35'10" |

"I hereby certify that I have surveyed the above described property and that the above map is a true representation thereof and shows the size and location of the property, its exterior boundaries, the location of all visible structures and dimension of all principal buildings thereon, boundary fences, apparent easements, roadways and encroachments if any."

"This survey is made for the use of the present owners of the property, and also those who purchase, mortgage or guarantee the title thereto within one year from date hereof."

REV. 7/31/02  
REV. 7/17/02

TEP/DW

TEP

02105

DATE

FIELD WORK BY

DRAWN BY

JOB NUMBER

KETTLE MORaine SURVEYING INC.


W356 S9050 Godfrey Lane

Eagle Wisconsin 53119

P.O. Box 357

(262) 594-3484

Terrance E. Pisarek R.L.S.

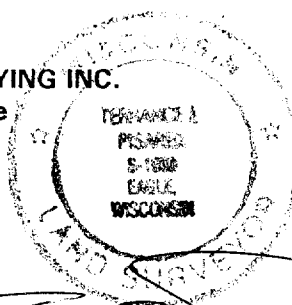

THIS IS NOT AN ORIGINAL SURVEY UNLESS THE SEAL IS RED.

✓ R5T01-107

003-829