


4

48-40


DIVISION ST.

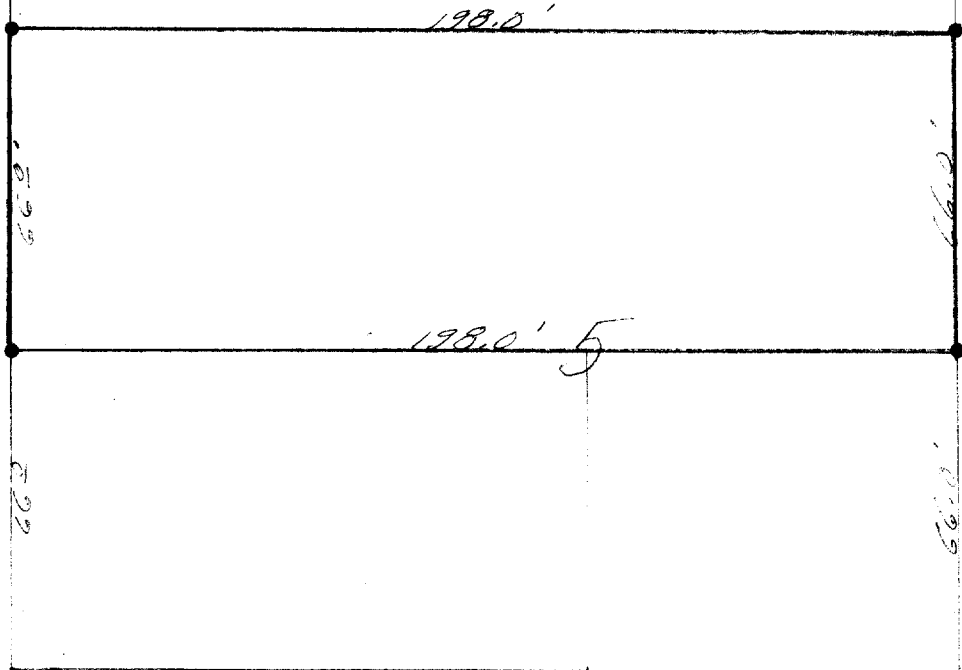

CHURCH ST.

SCHOOL

ST.

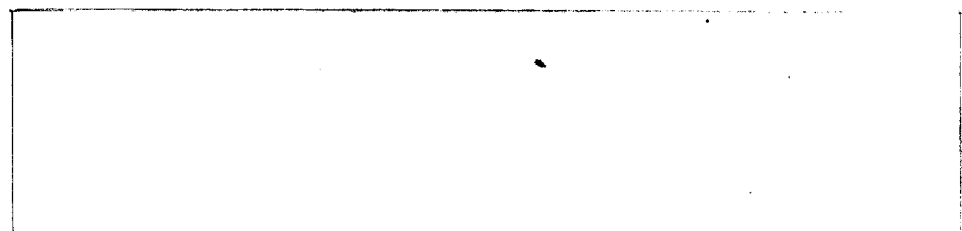

DESCRIPTION: Beginning at a stake standing 46 rods due North and 2 rods due East of the Southeast corner of Section 19, Town 4 north, Range 18 east of the 4th Principal Meridian; thence North 4 rods to an iron stake, thence East, 12 rods to an iron stake, thence South 4 rods to an iron stake, thence West 12 rods to the place of beginning; otherwise known as the north 66 feet of Lot 5, Block 2; Original Plat of the Village of East Troy, Walworth County, Wisconsin

CERTIFICATE: I, hereby certify that I have on this the 24th day of July 1948, surveyed the above described property, according to the official record on file in the office of the Recorder of Deeds in and for Walworth County, Wisconsin, and find that the measurements and bearings of the boundary lines of said property as taken at the site on this day substantially agree with those in the above description and that no encroachments exist.

SIGNED AND SEALED ON THIS THE 26TH DAY OF JULY 1948.

Joseph M. Biagi
 Joseph M. Biagi.
 Professional Engineer.
 Elkhorn Wisconsin.