


RONALD H. ZIMMERMAN
REGISTERED LAND SURVEYOR

PLAT OF SURVEY

FOR

WAUKESHA SAVINGS & LOAN

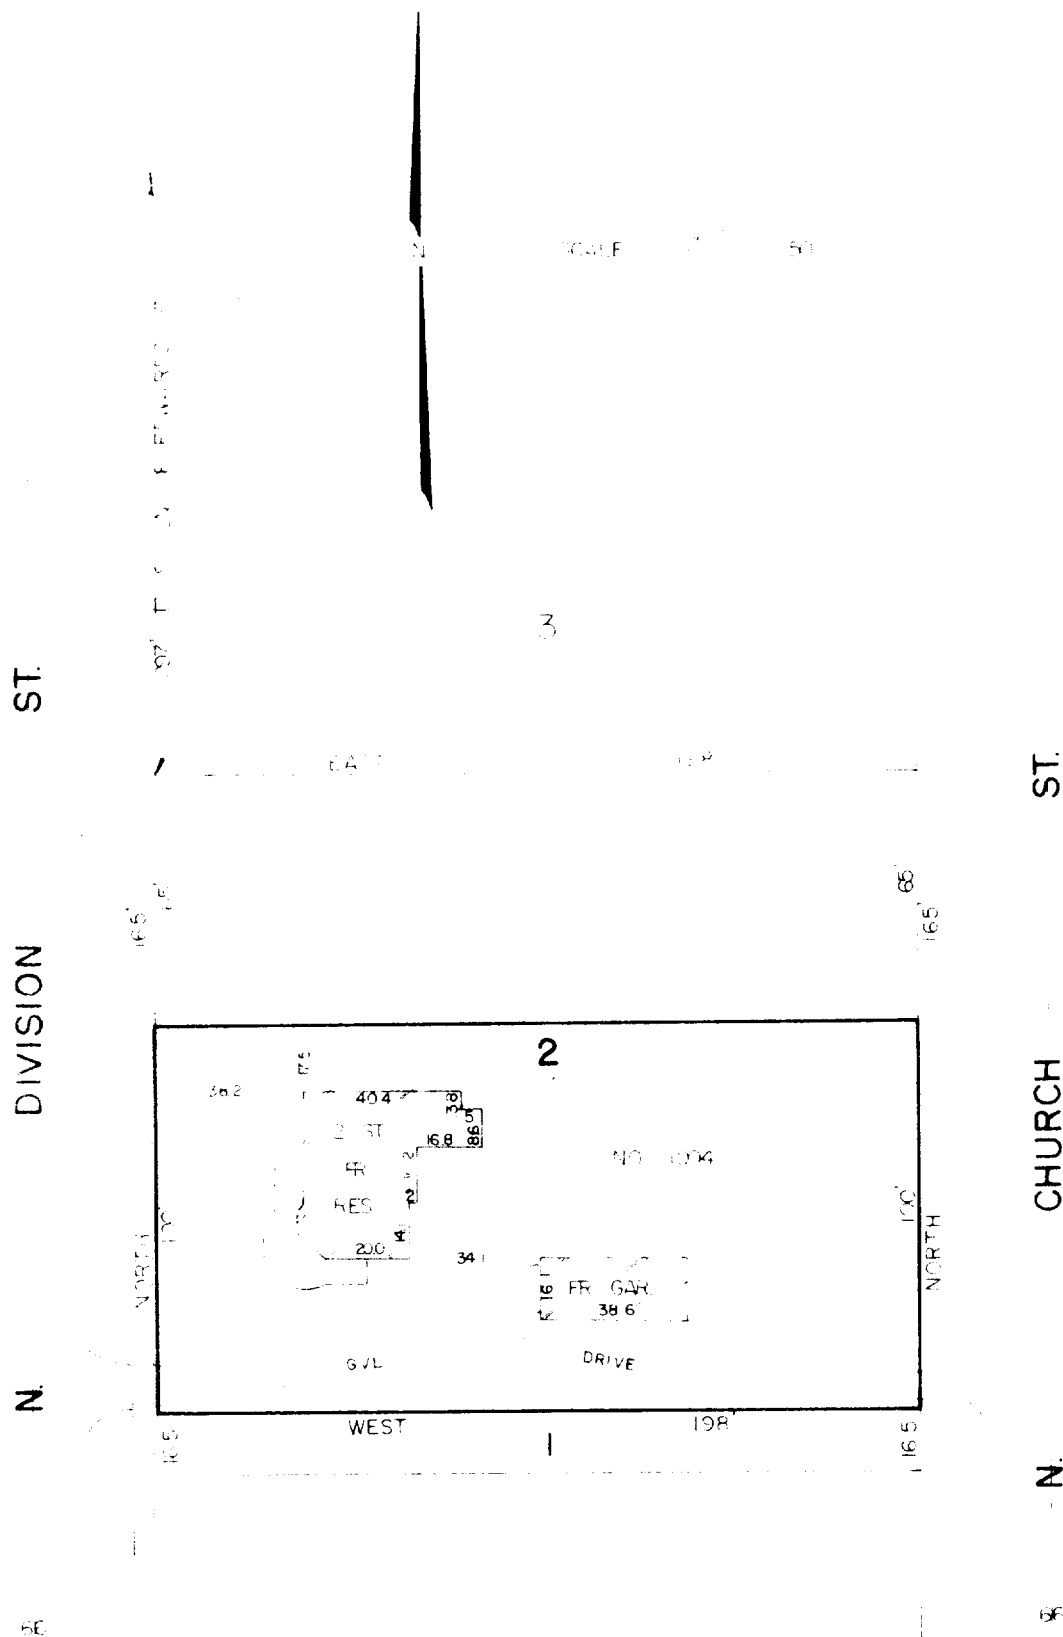

CERTIFICATION

STATE OF WISCONSIN)
COUNTY OF WAUKESHA)

I, RONALD H. ZIMMERMAN, REGISTERED LAND SURVEYOR, DO HEREBY CERTIFY THAT I HAVE MADE A SURVEY
OF LOT 2 EXCEPT N. 65' BLK. 4, S.B. EDWARDS ADD. VILLAGE OF EAST TROY.
AND THE EXISTING BUILDING AND IMPROVEMENTS LOCATED THEREON AND THAT THE PLAT HEREWITH DRAWN
IS A CORRECT REPRESENTATION OF SAID SURVEY

DATE NOV 30 1973

RONALD H. ZIMMERMAN

3-83