


RONALD H. ZIMMERMAN
REGISTERED LAND SURVEYOR

PLAT OF SURVEY

FOR

WAUKESHA SAVINGS & LOAN

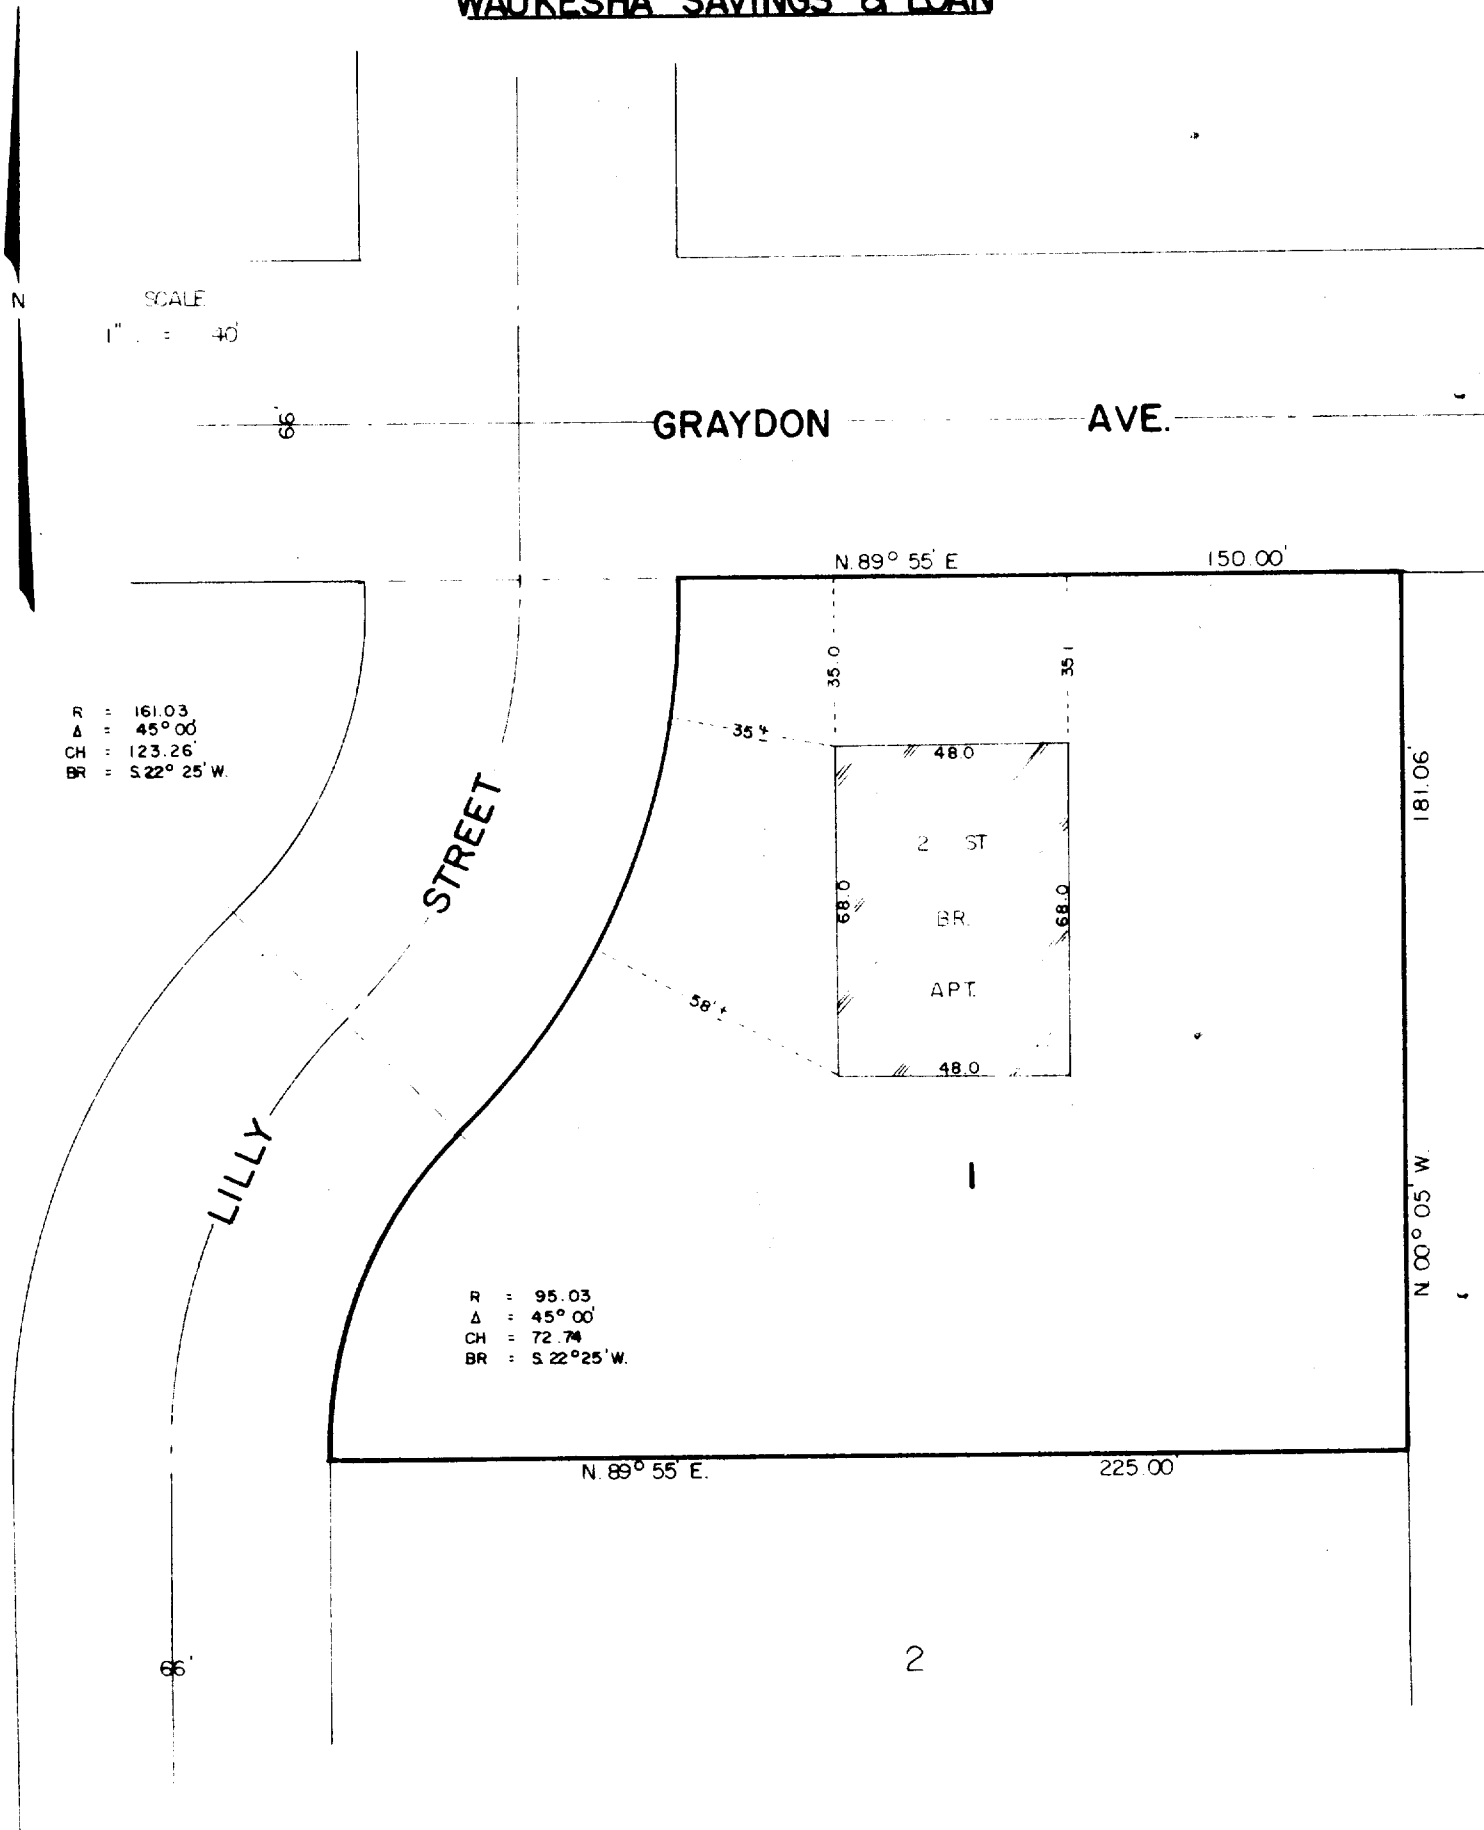

CERTIFICATION

STATE OF WISCONSIN)
COUNTY OF WAUKESHA) SS

I, RONALD H. ZIMMERMAN, REGISTERED LAND SURVEYOR, DO HEREBY CERTIFY THAT I HAVE MADE A SURVEY
OF LOT 1, TROYJENS APARTMENTS SUB'D, VILLAGE OF EAST TROY,
AND THE EXISTING BUILDING AND IMPROVEMENTS LOCATED THEREON AND THAT THE PLAT HERewith DRAWN
IS A CORRECT REPRESENTATION OF SAID SURVEY.

DATE NOV 30, 1973

RONALD H. ZIMMERMAN

S. 868

3-84