

HOLLAND & THOMAS, L.L.C. - LAND SURVEYORS

202 West Street Johnson Creek, WI 53038 (920) 699-3305

A B C D E F G

PLAT OF SURVEY

FOR LOT 15 OF CRYSTAL ACRES, PART OF THE NW 1/4 AND NE 1/4 OF THE
SOUTHWEST QUARTER OF SECTION 20, TOWN 4 NORTH, RANGE 18 EAST,
VILLAGE OF EAST TROY, WALWORTH COUNTY, WISCONSIN.

(66' R-O-W)

C1


RAD = 20.00'

ARC = 16.93'

CHD = 16.43'

C.B. = S 64°-30'-33.5" W

BROOKS COURT

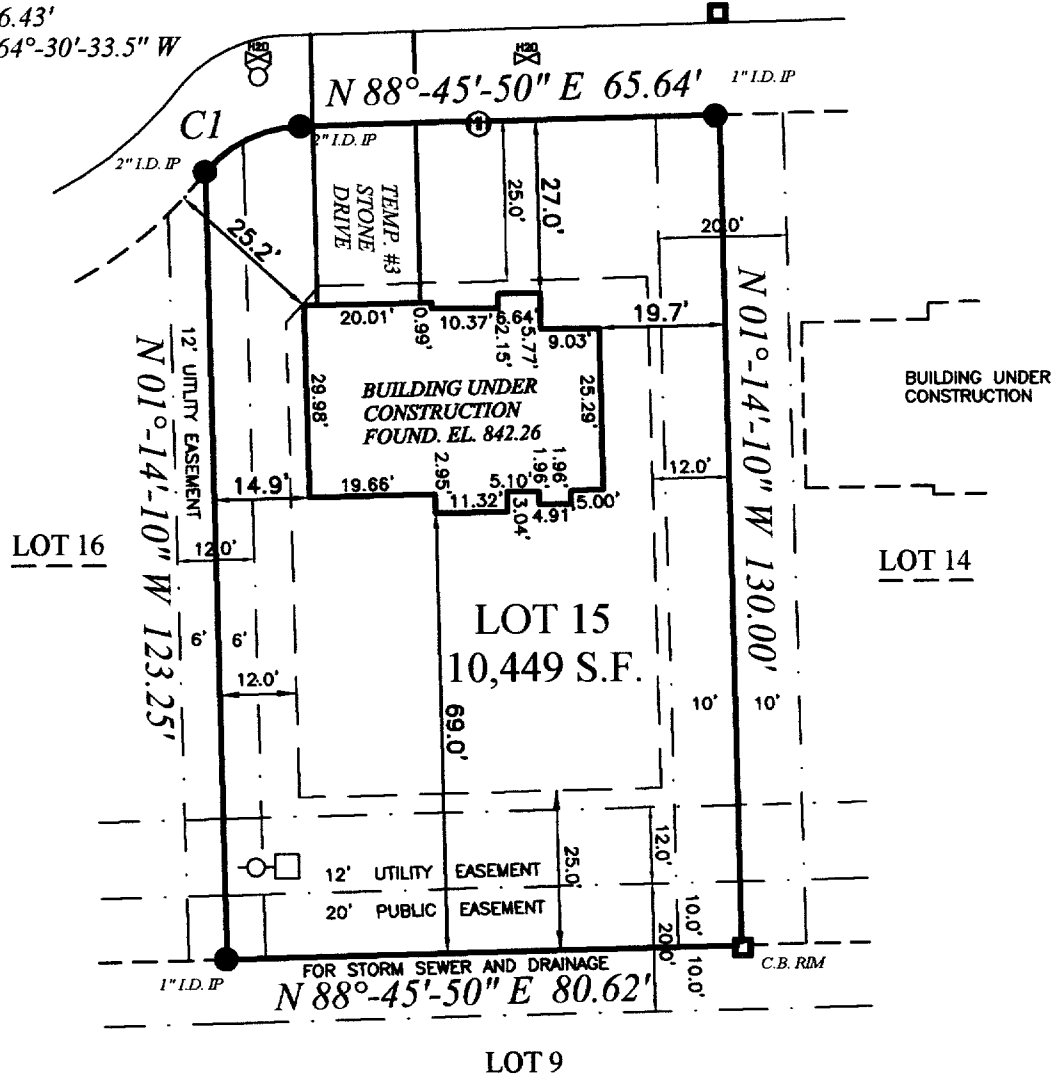

IF THE SURVEYOR'S SEAL IS NOT
RED, THE PLAN IS A COPY THAT
SHOULD BE ASSUMED TO CONTAIN
UNAUTHORIZED ALTERATIONS. THE
CERTIFICATION CONTAINED ON THIS
DOCUMENT DOES NOT APPLY TO
COPIES UNLESS THEY TOO HAVE A
RED STAMP OVER THE PHOTOCOPIED
STAMP BY SAME SURVEYOR.

SCOTT THOMAS
11/12/03

BEARINGS ARE REFERENCED TO THE WEST LINE OF
THE SOUTHWEST QUARTER OF SECTION 20-4-18,
WHICH IS ASSUMED TO BEAR N 00°-13'-59" W.



State of Wisconsin } SS.
County of Jefferson }

We, Holland & Thomas, L.L.C., do hereby certify that we have made this survey and that the information as shown on the above
Plat of Survey is a true and correct representation thereof.

LEGEND: These standard symbols may be found in the drawing.

- Lot Corner (Found) w/desc.
- Catch Basin
- Fire Hydrant
- Utility Pedestal
- Elec. Trans. Box
- ⊗ Water Valve
- Easement Boundary
- Setback Line

BUILDER: BROOKSTONE HOMES, INC.
1860 EXECUTIVE DRIVE
SUITE B1
OCONOMOWOC, WI 53066
PH: (262) 567-5700
FAX: (262) 567-7228

JAN 20

KW
003-868

RCRA-15