



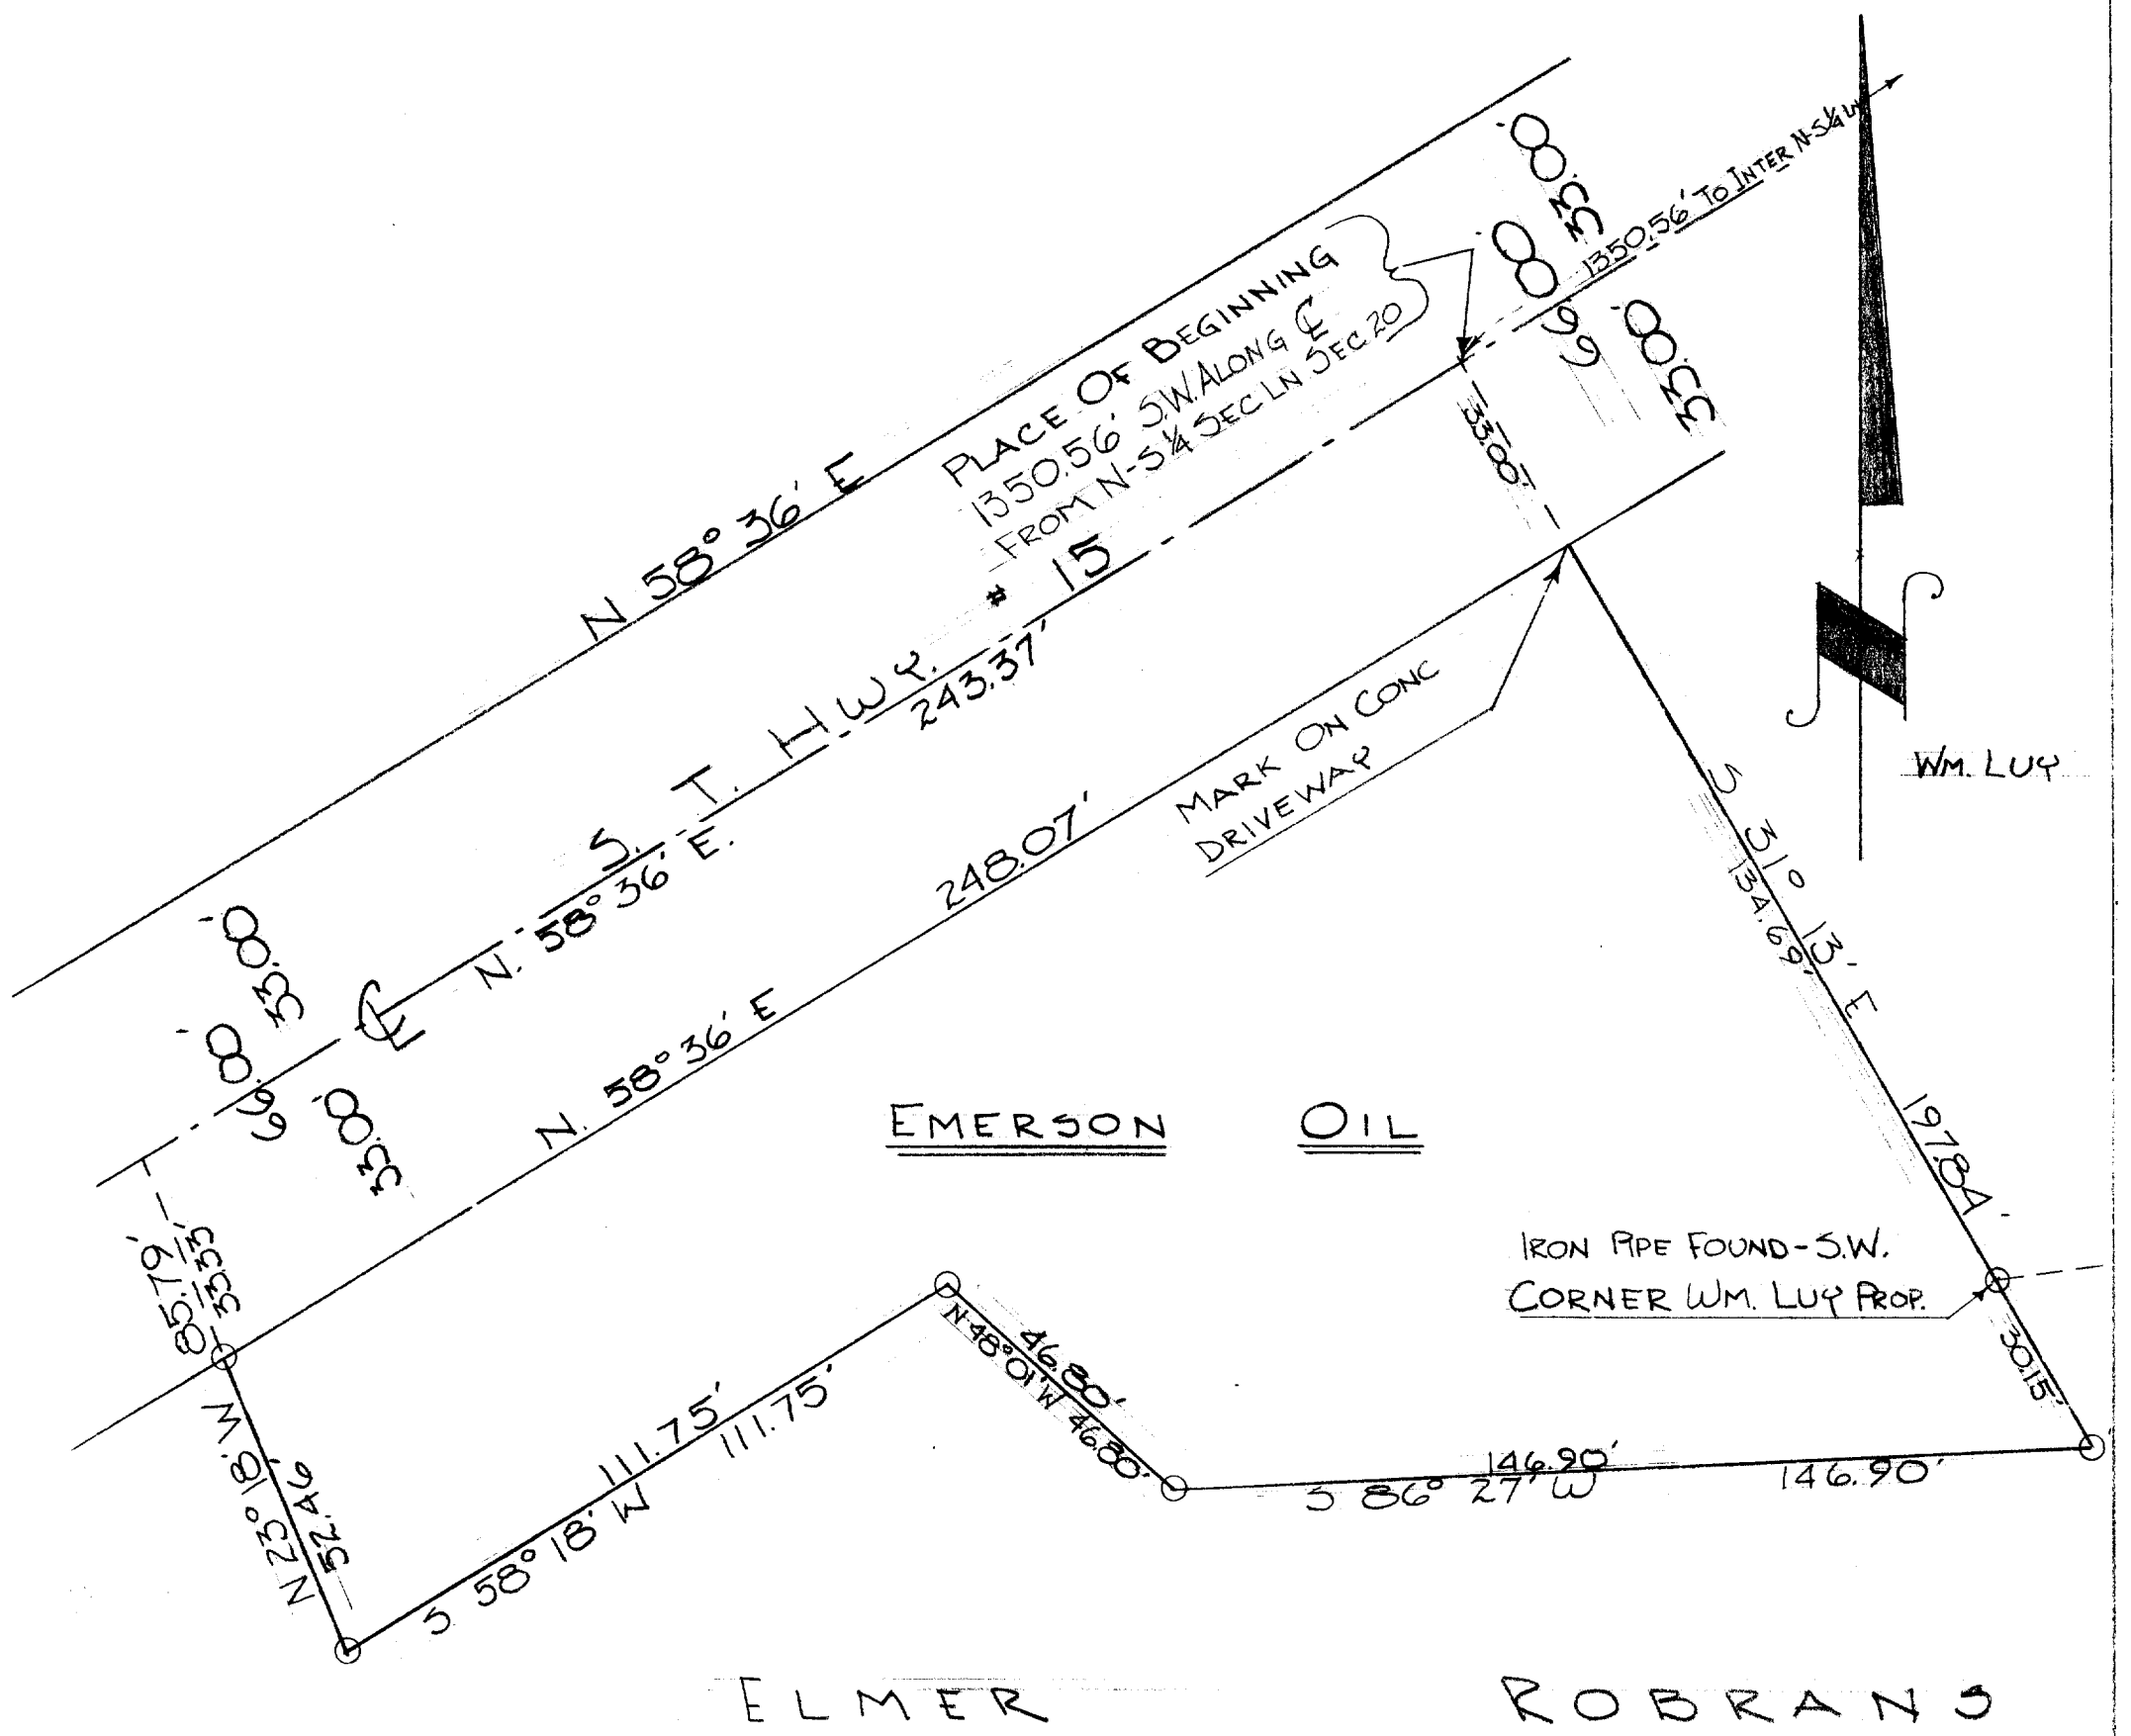

DESCRIPTION: Commencing at the point of intersection of the centerline of State Trunk Highway #15 and the N-3 1/4 Section line of Section 20, Town 4 North, Range 18 East, Walworth County, Wisconsin, thence Southwest 1350.56 feet along the centerline of said Highway to the place of beginning of the land hereinafter described; thence S 31° 13' E. 197.84 feet to an iron stake, thence S 86° 27' W. 146.90 feet to an iron stake, thence N 48° 01' W. 46.80 feet to an iron stake, thence S. 58° 18' W. 111.75 feet to an iron stake, thence N. 23° 18' W. 85.79 feet to a point in the centerline of said Highway, thence N 58° 36' E. 243.37 feet to the place of beginning.

CERTIFICATE: I, James F. Biagi, surveyor, do hereby certify that I have surveyed the property hereon described on the 16th day of October 1962.

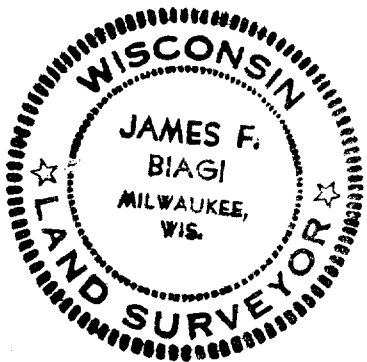

*James F. Biagi*

James F. Biagi, RLS 272