


REGISTERED LAND SURVEYORS
MILTON H. SCHMIDT, Pres.
CLARENCE H. PIEPENBURG, Vice-Pres.
JAMES A. EIDE, Sec.-Treas.

BADGER SURVEYING CO., INC.

PHONE FLAGSTONE 4-9080
7257 N. 51st STREET
MILWAUKEE 23, WIS.

PLAT OF SURVEY

Legal Description: Lots 5 and 6, in Block 12, in the Village of East Troy according to the recorded plat of said Village. Excepting and reserving therefrom that piece or parcel of land described as follows to-wit: Commencing at the northwest corner of Lot 5 and running thence East at right angles with Church Street, 50 feet; thence North parallel with Street, 14 inches; thence West 50 feet to the place of beginning; and also excepting and reserving that piece or parcel of land described as follows, to-wit: Beginning at the northwest corner of Lot 5 of Block 12 of the original Village of East Troy; thence Easterly along the south wall of the postoffice building, 50 feet; thence North 1.17 feet to the north line of said Lot 5; thence East along the north line of said Lot 5, 31.73 feet to the northeast corner of said Lot; thence South 24.00 feet to the southeast corner of said Lot 5 and continuing South along the east line of Lot 6, 24.20 feet to an iron pipe; thence West 131.78 feet to the west line of said Lot 6; thence North 17.00 feet to the northwest corner of said Lot 6, and continuing North 24.00 feet to the place of beginning.

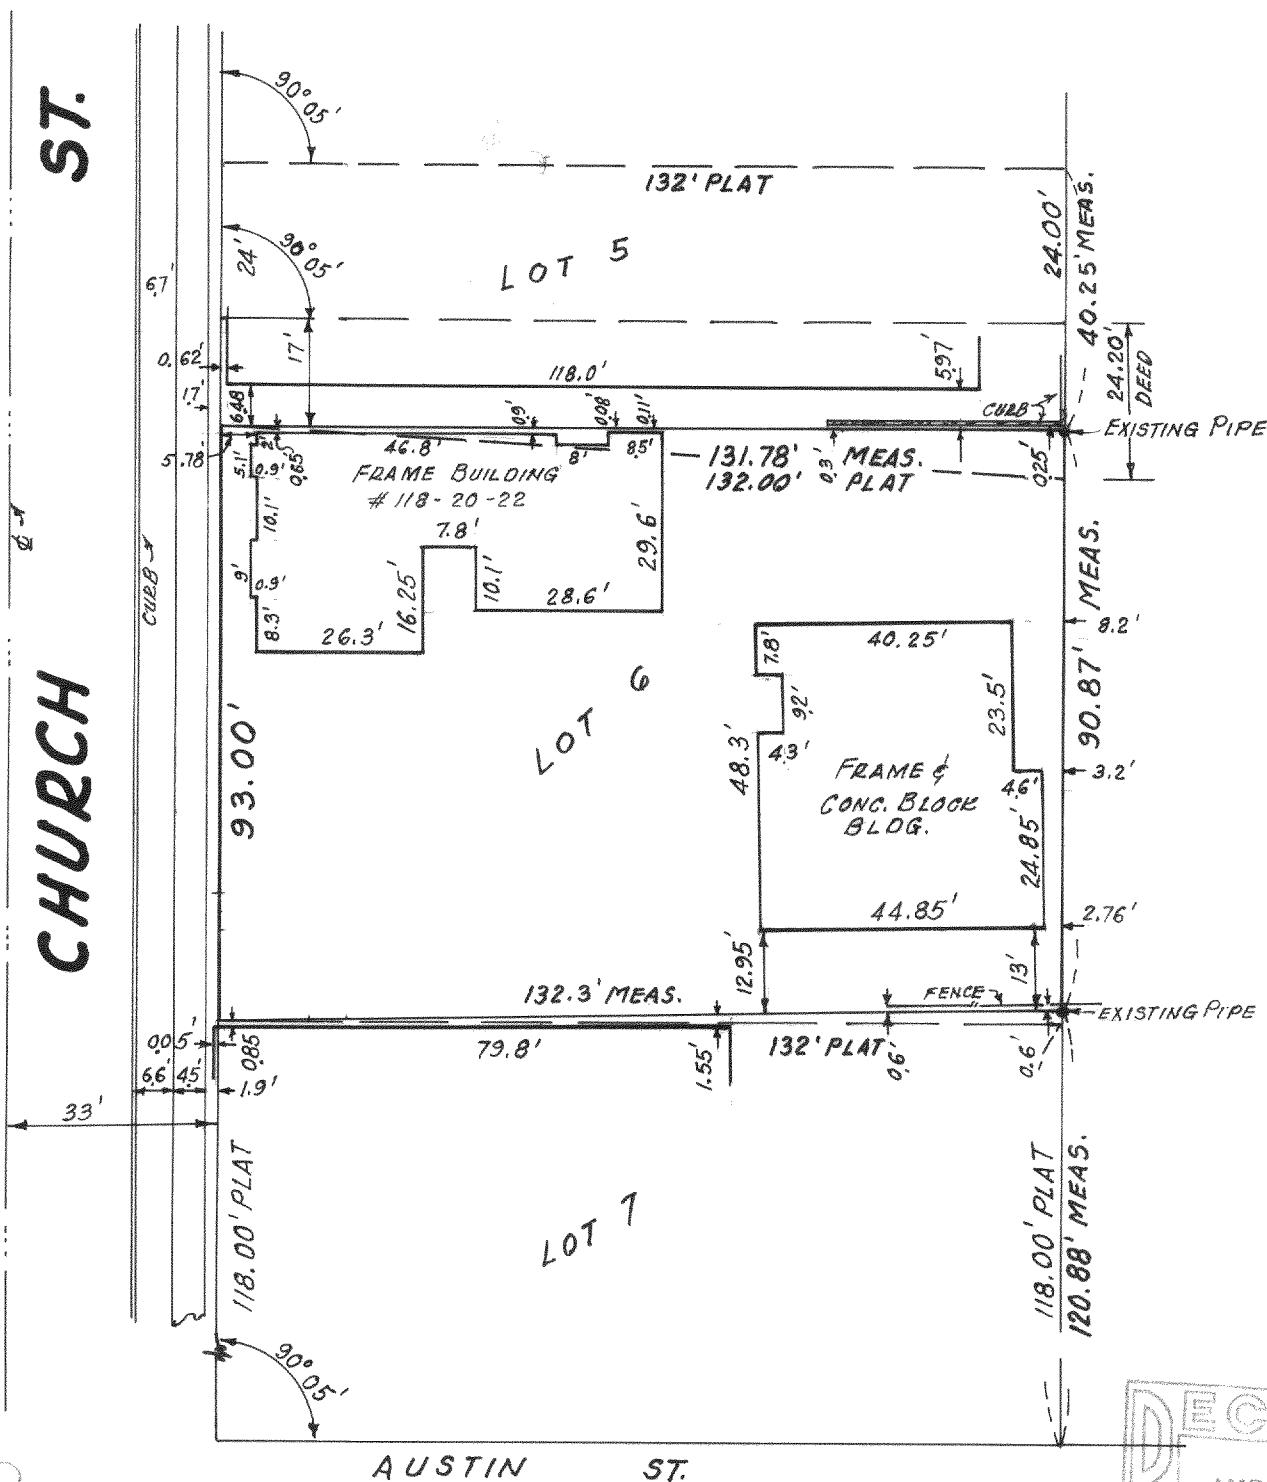


Prepared for GERALD RICE, ATTY

State of Wisconsin, } ss.
County of Milwaukee }

I hereby certify that on the 24TH day of MARCH 1964, I have accurately surveyed the above described property and that the above plat is a correct representation thereof and shows the exterior boundary lines and location of buildings and other improvements on said property and the correct measurements thereof.

Plat No. 64-216

Signed Clarence H. Piepenburg
Registered Land Surveyor

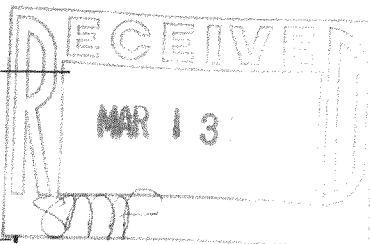

CO3-913