


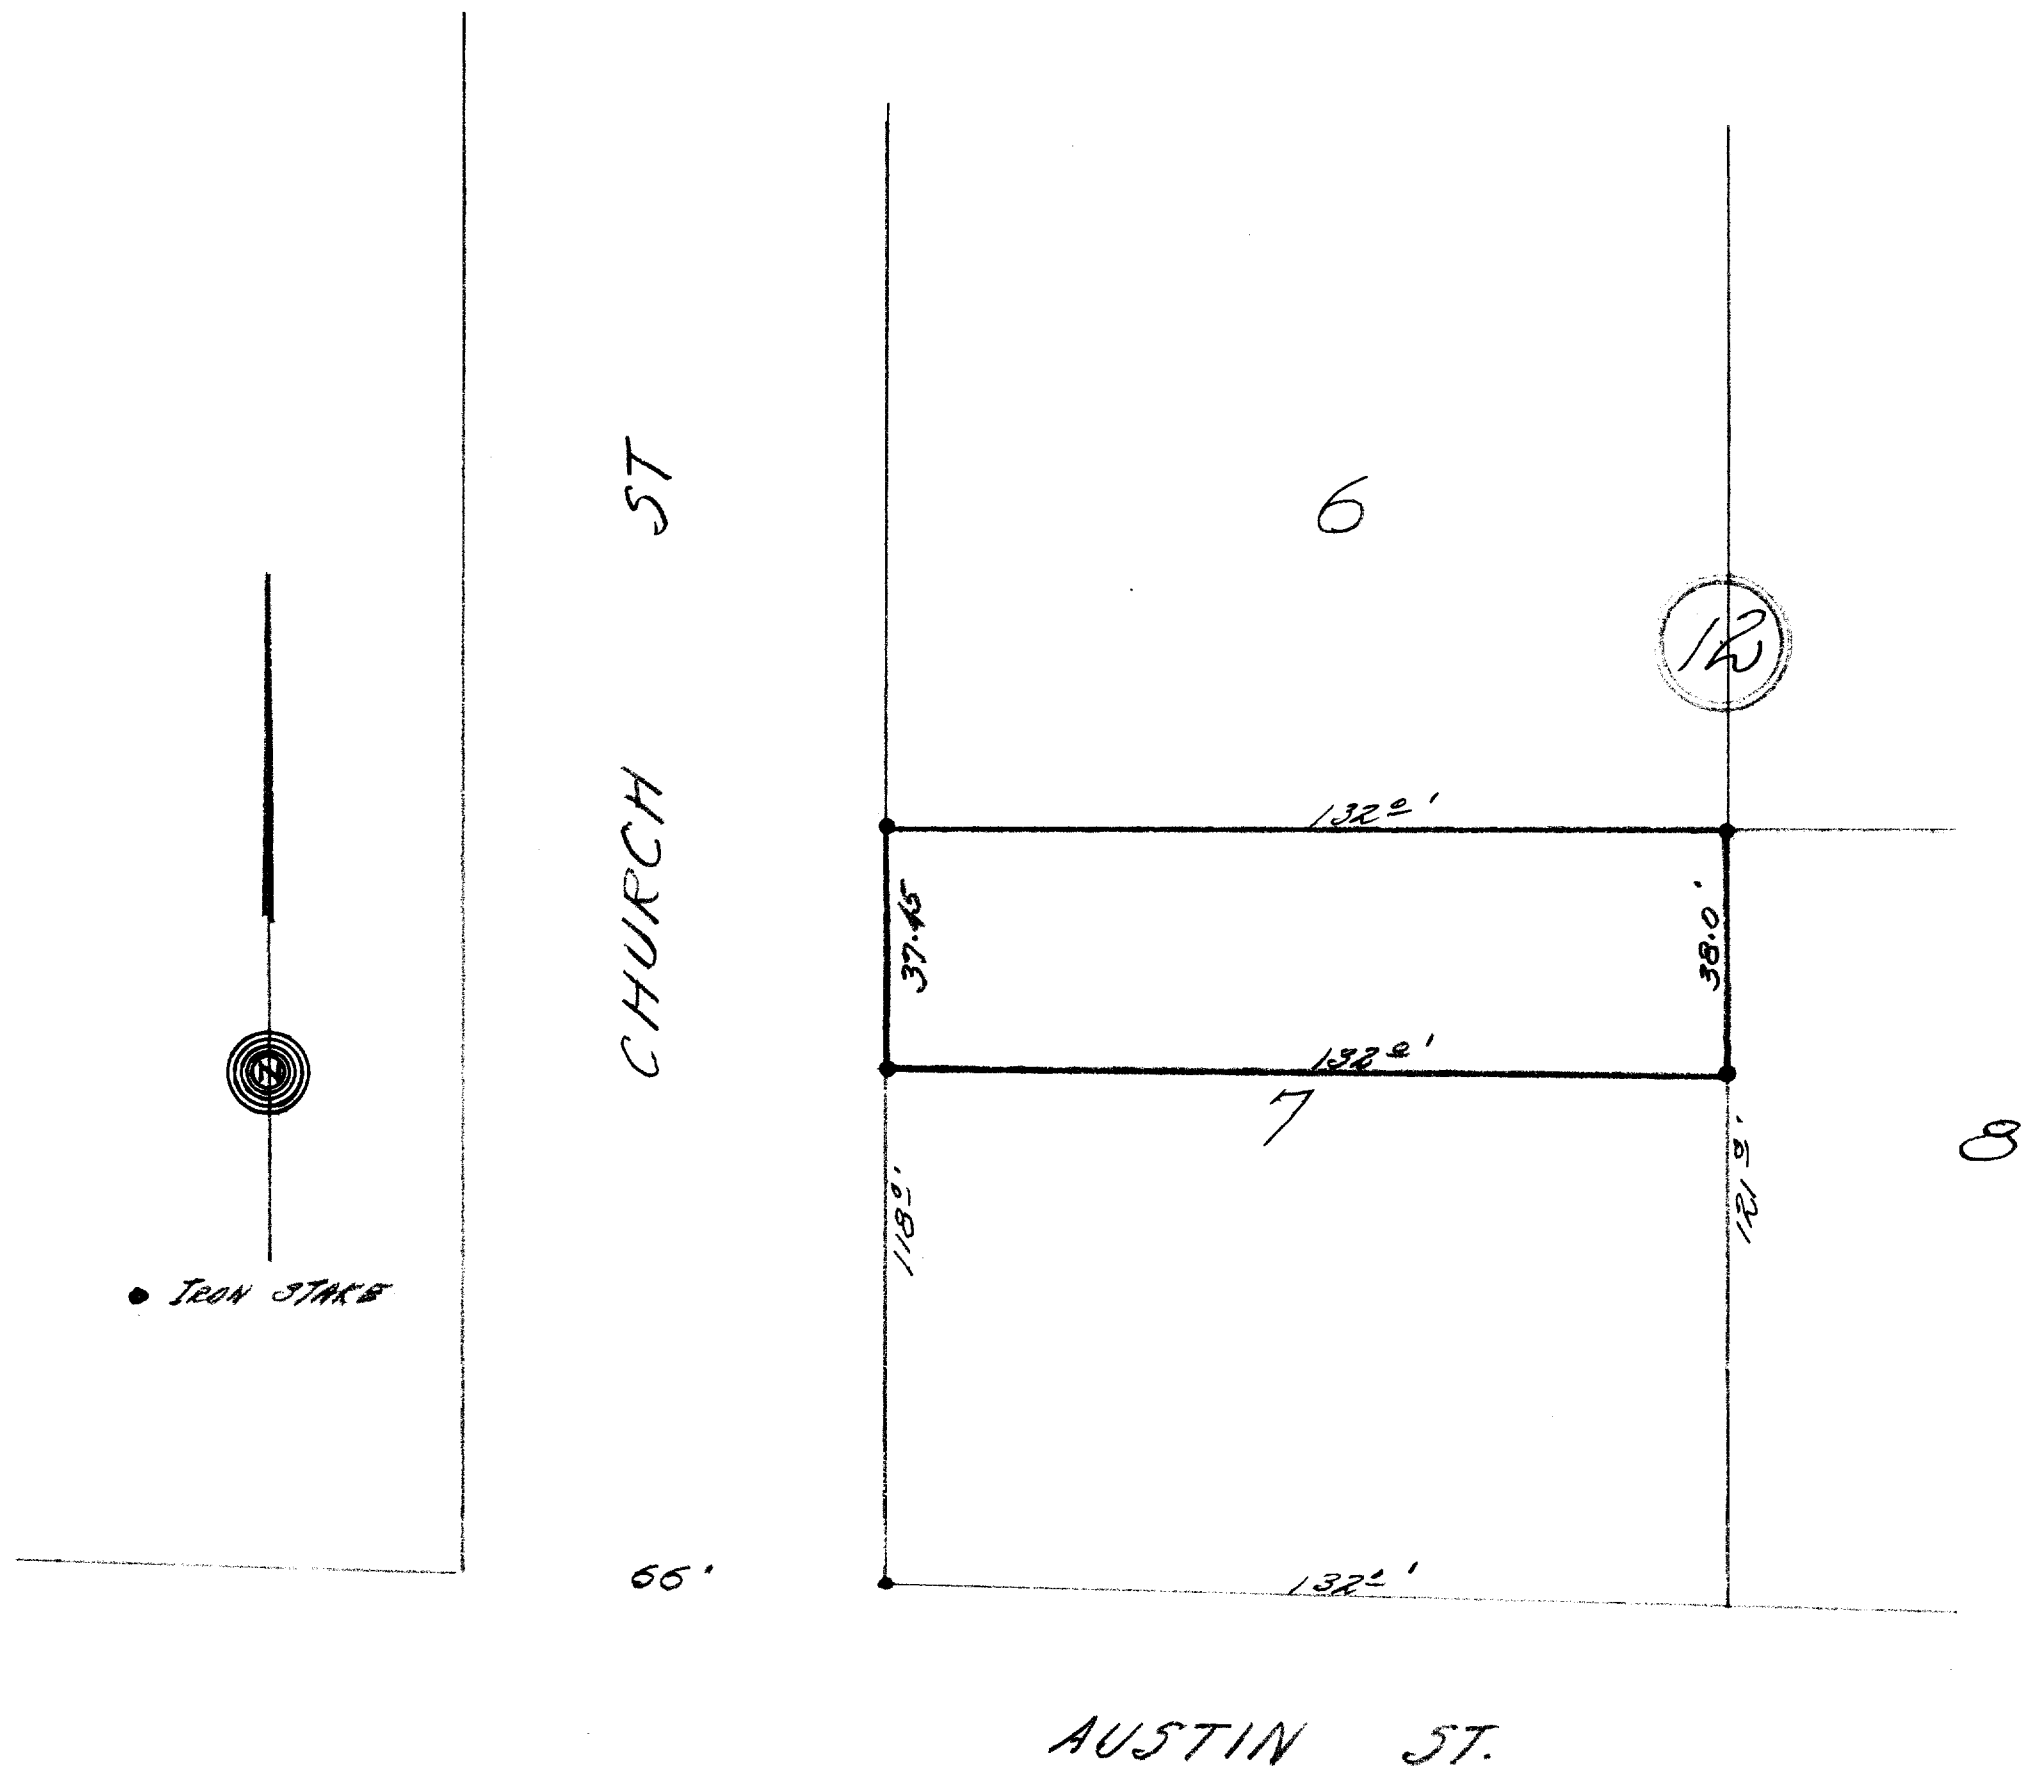

DESCRIPTION:

Commencing at the Northwest corner of Lot 7, Block 12, Original Plat of the Village of East Troy, Walworth County, Wisconsin; thence East along the north line of said lot 132 feet to an iron stake, thence South along the east line of said lot 38 feet to an iron stake, thence West 132 feet to a point in the west line of said lot, that is 37.45 feet south of the place of beginning, thence North 37.45 feet to the place of beginning.

CERTIFICATE:

This is to certify that I have on this the 19th day of August 1946. surveyed the above described property according to the official records on file in the office of the Recorder of Deeds in and for Walworth County, Wisconsin, and find that the measurements and bearings of the property lines as taken on this day substantially agree with those in the above description.

SIGNED AND SEALED THIS 20TH DAY OF AUGUST 1946.

Joseph M. Biagi
 Joseph M. Biagi.
 Professional Engineer.
 Elkhorn Wisconsin.