


PLAT OF SURVEY

OF

The North 33' of Lot 6, Block 1, North View Addition
to the Village of East Troy, Section 19, T4N R18E
Walworth County, Wisconsin.

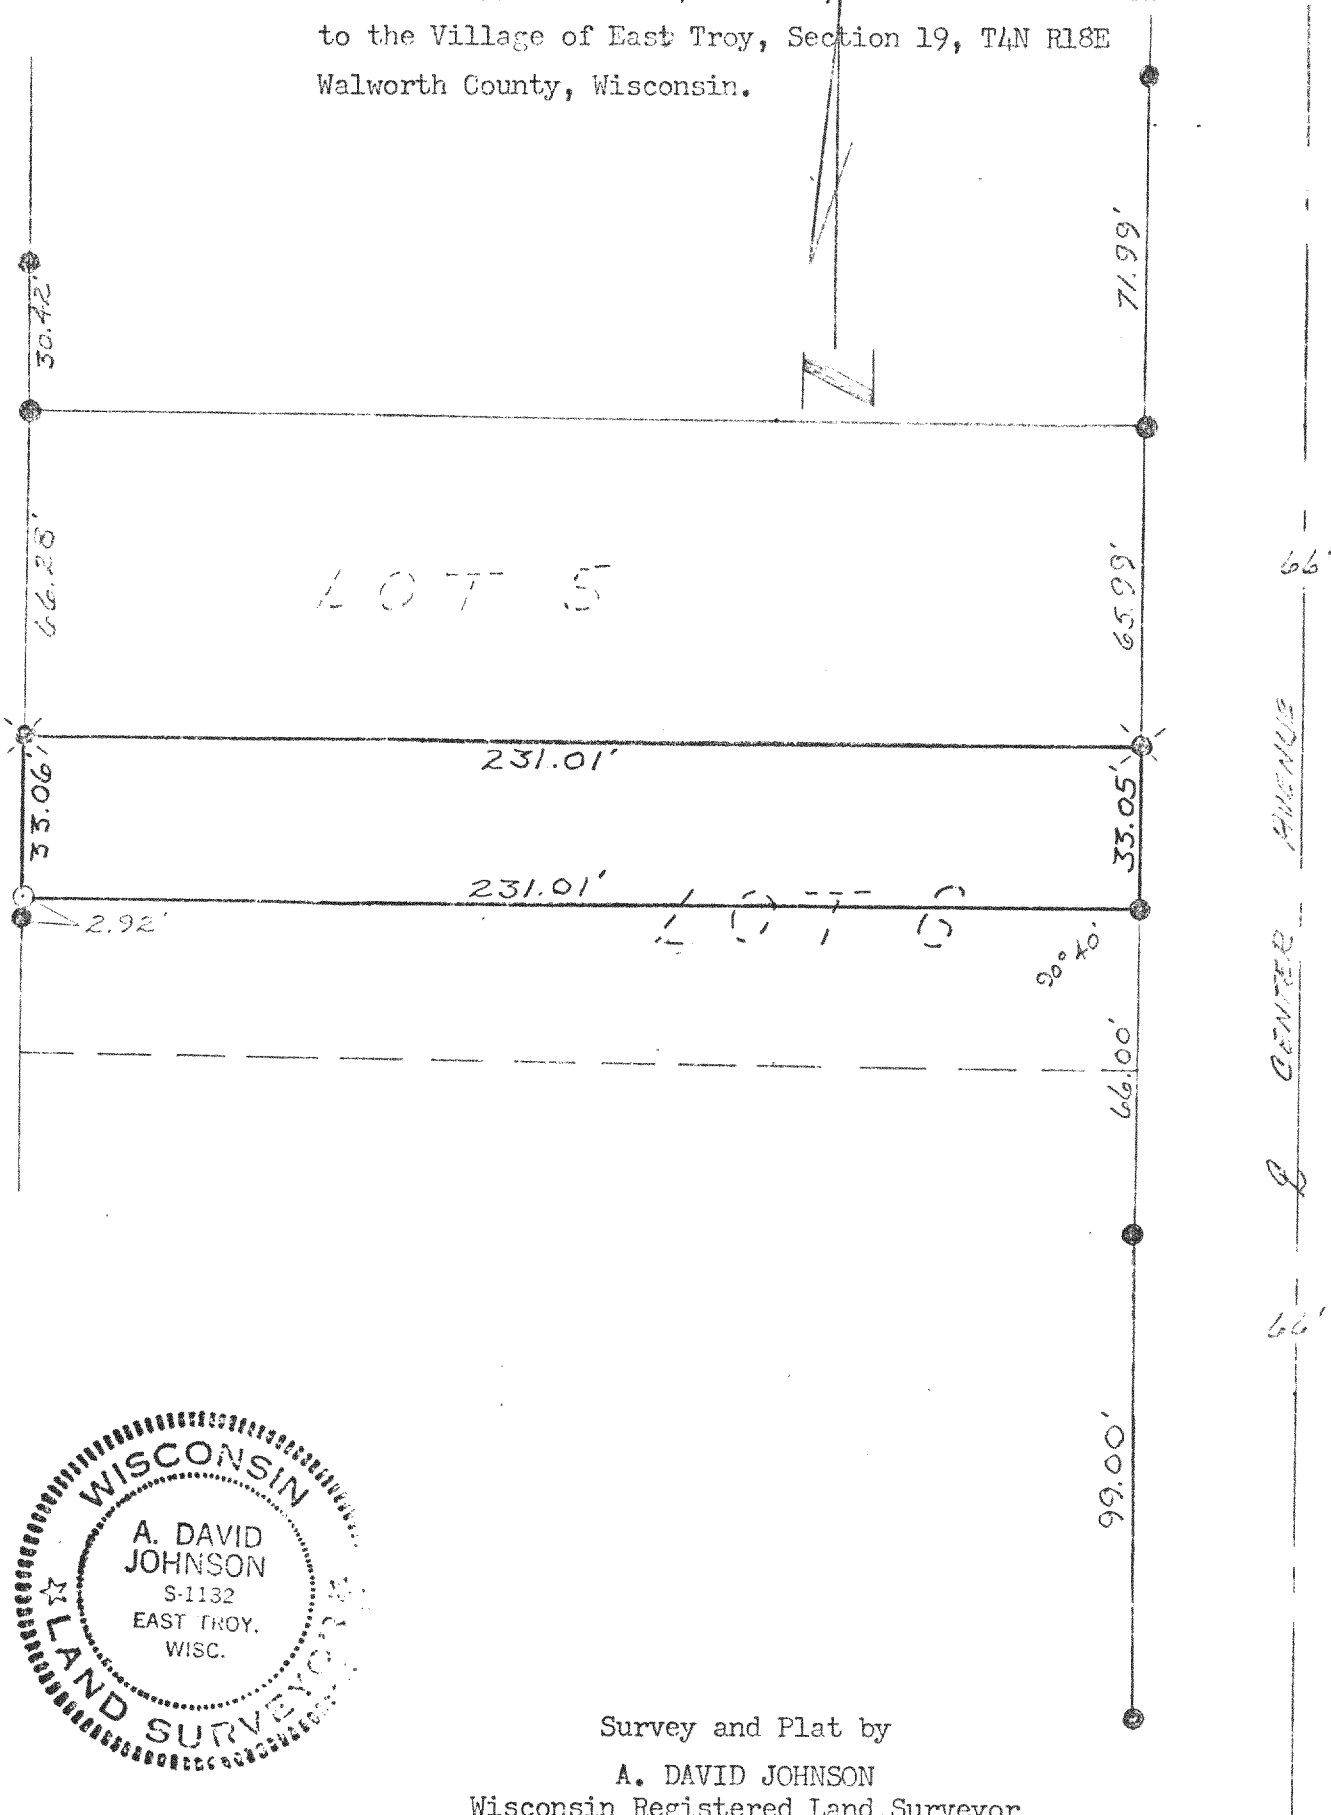

Survey and Plat by
A. DAVID JOHNSON
Wisconsin Registered Land Surveyor
East Troy, Wisconsin

LEGEND

- Iron Pipe Found
- Iron Pipe Placed
- Concrete Monument
- ✱-Iron Rod Found
- Scale 1" = 40'

I, A. DAVID JOHNSON, certify that I have surveyed the
above described property and that the plat shown hereon
is an accurate survey and a true representation thereof
and correctly shows the exterior boundary lines and all
divisions of said property.

Date 1-16-74

A. David Johnson
A. DAVID JOHNSON

Wisconsin Registered Land Surveyor, No. S-1132

3-93