



135^E - 68

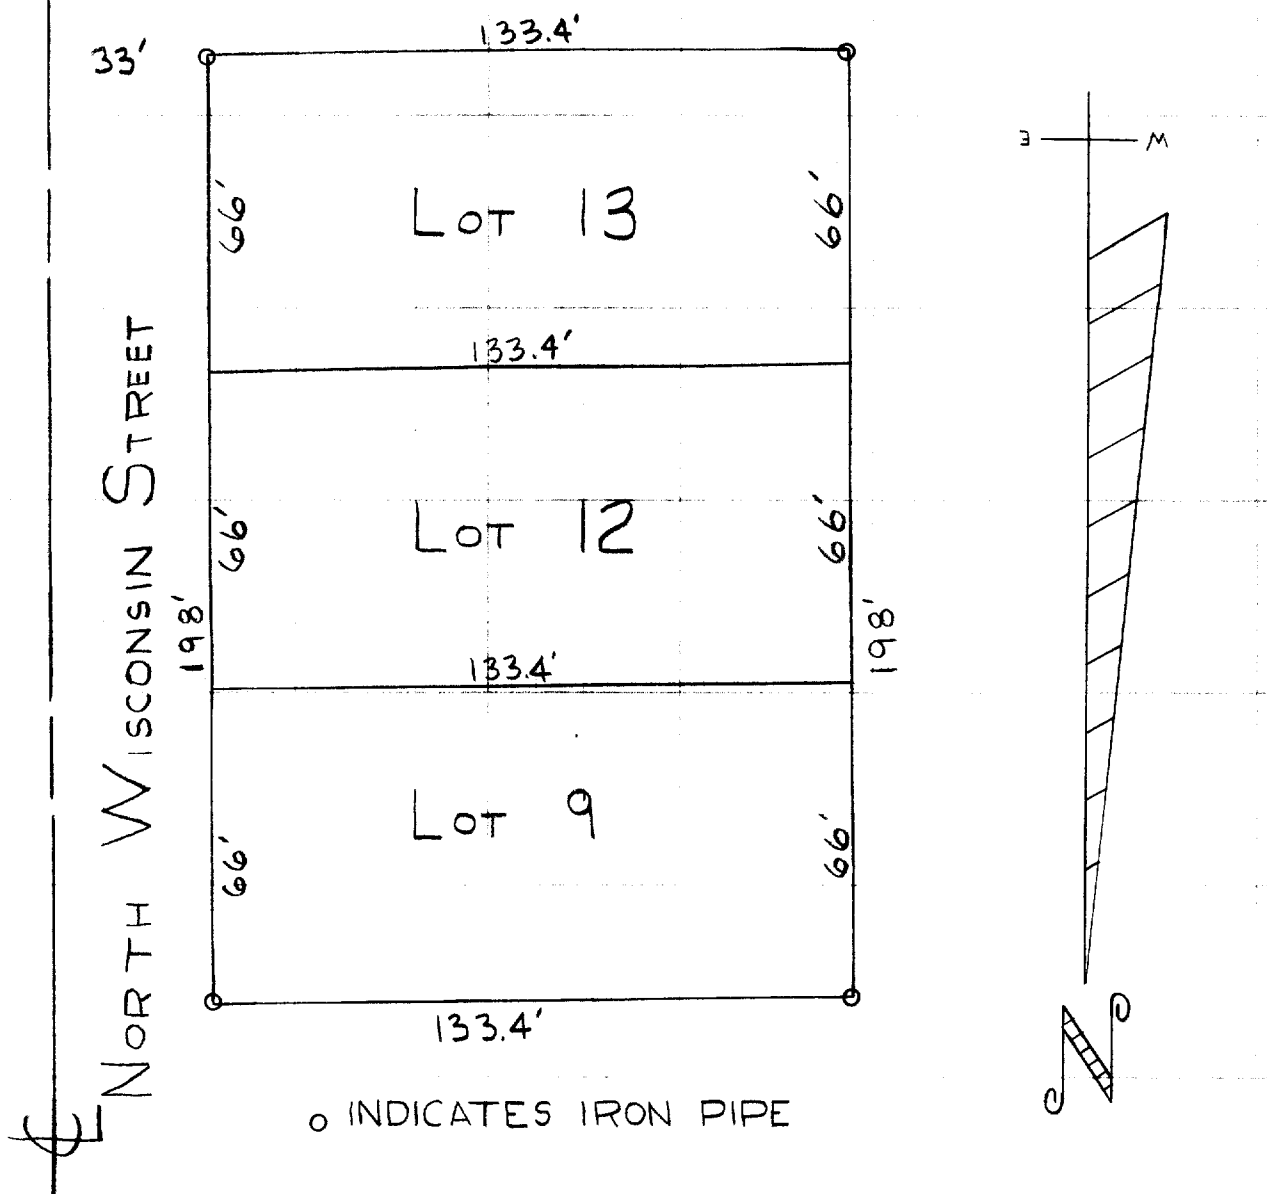

DESCRIPTION: Lot 9, 12, and 13 of Block 1 of Holton Heights Subdivision, City of Elkhorn, Walworth County, Wisconsin.

CERTIFICATE: I, James F. Biagi, surveyor, do hereby certify that I have surveyed the property hereon described.

November 8, 1968.

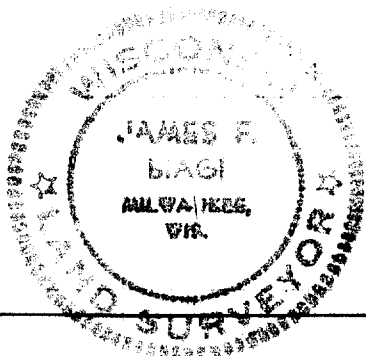

James F. Biagi
James F. Biagi RLS 272

4-100B

YHT-2,5