






# PLAT OF SURVEY

LOT 9 OF BLOCK 2 OF HOLTON HEIGHTS  
ADDITION TO THE CITY OF ELKHORN  
WALWORTH COUNTY, WISCONSIN

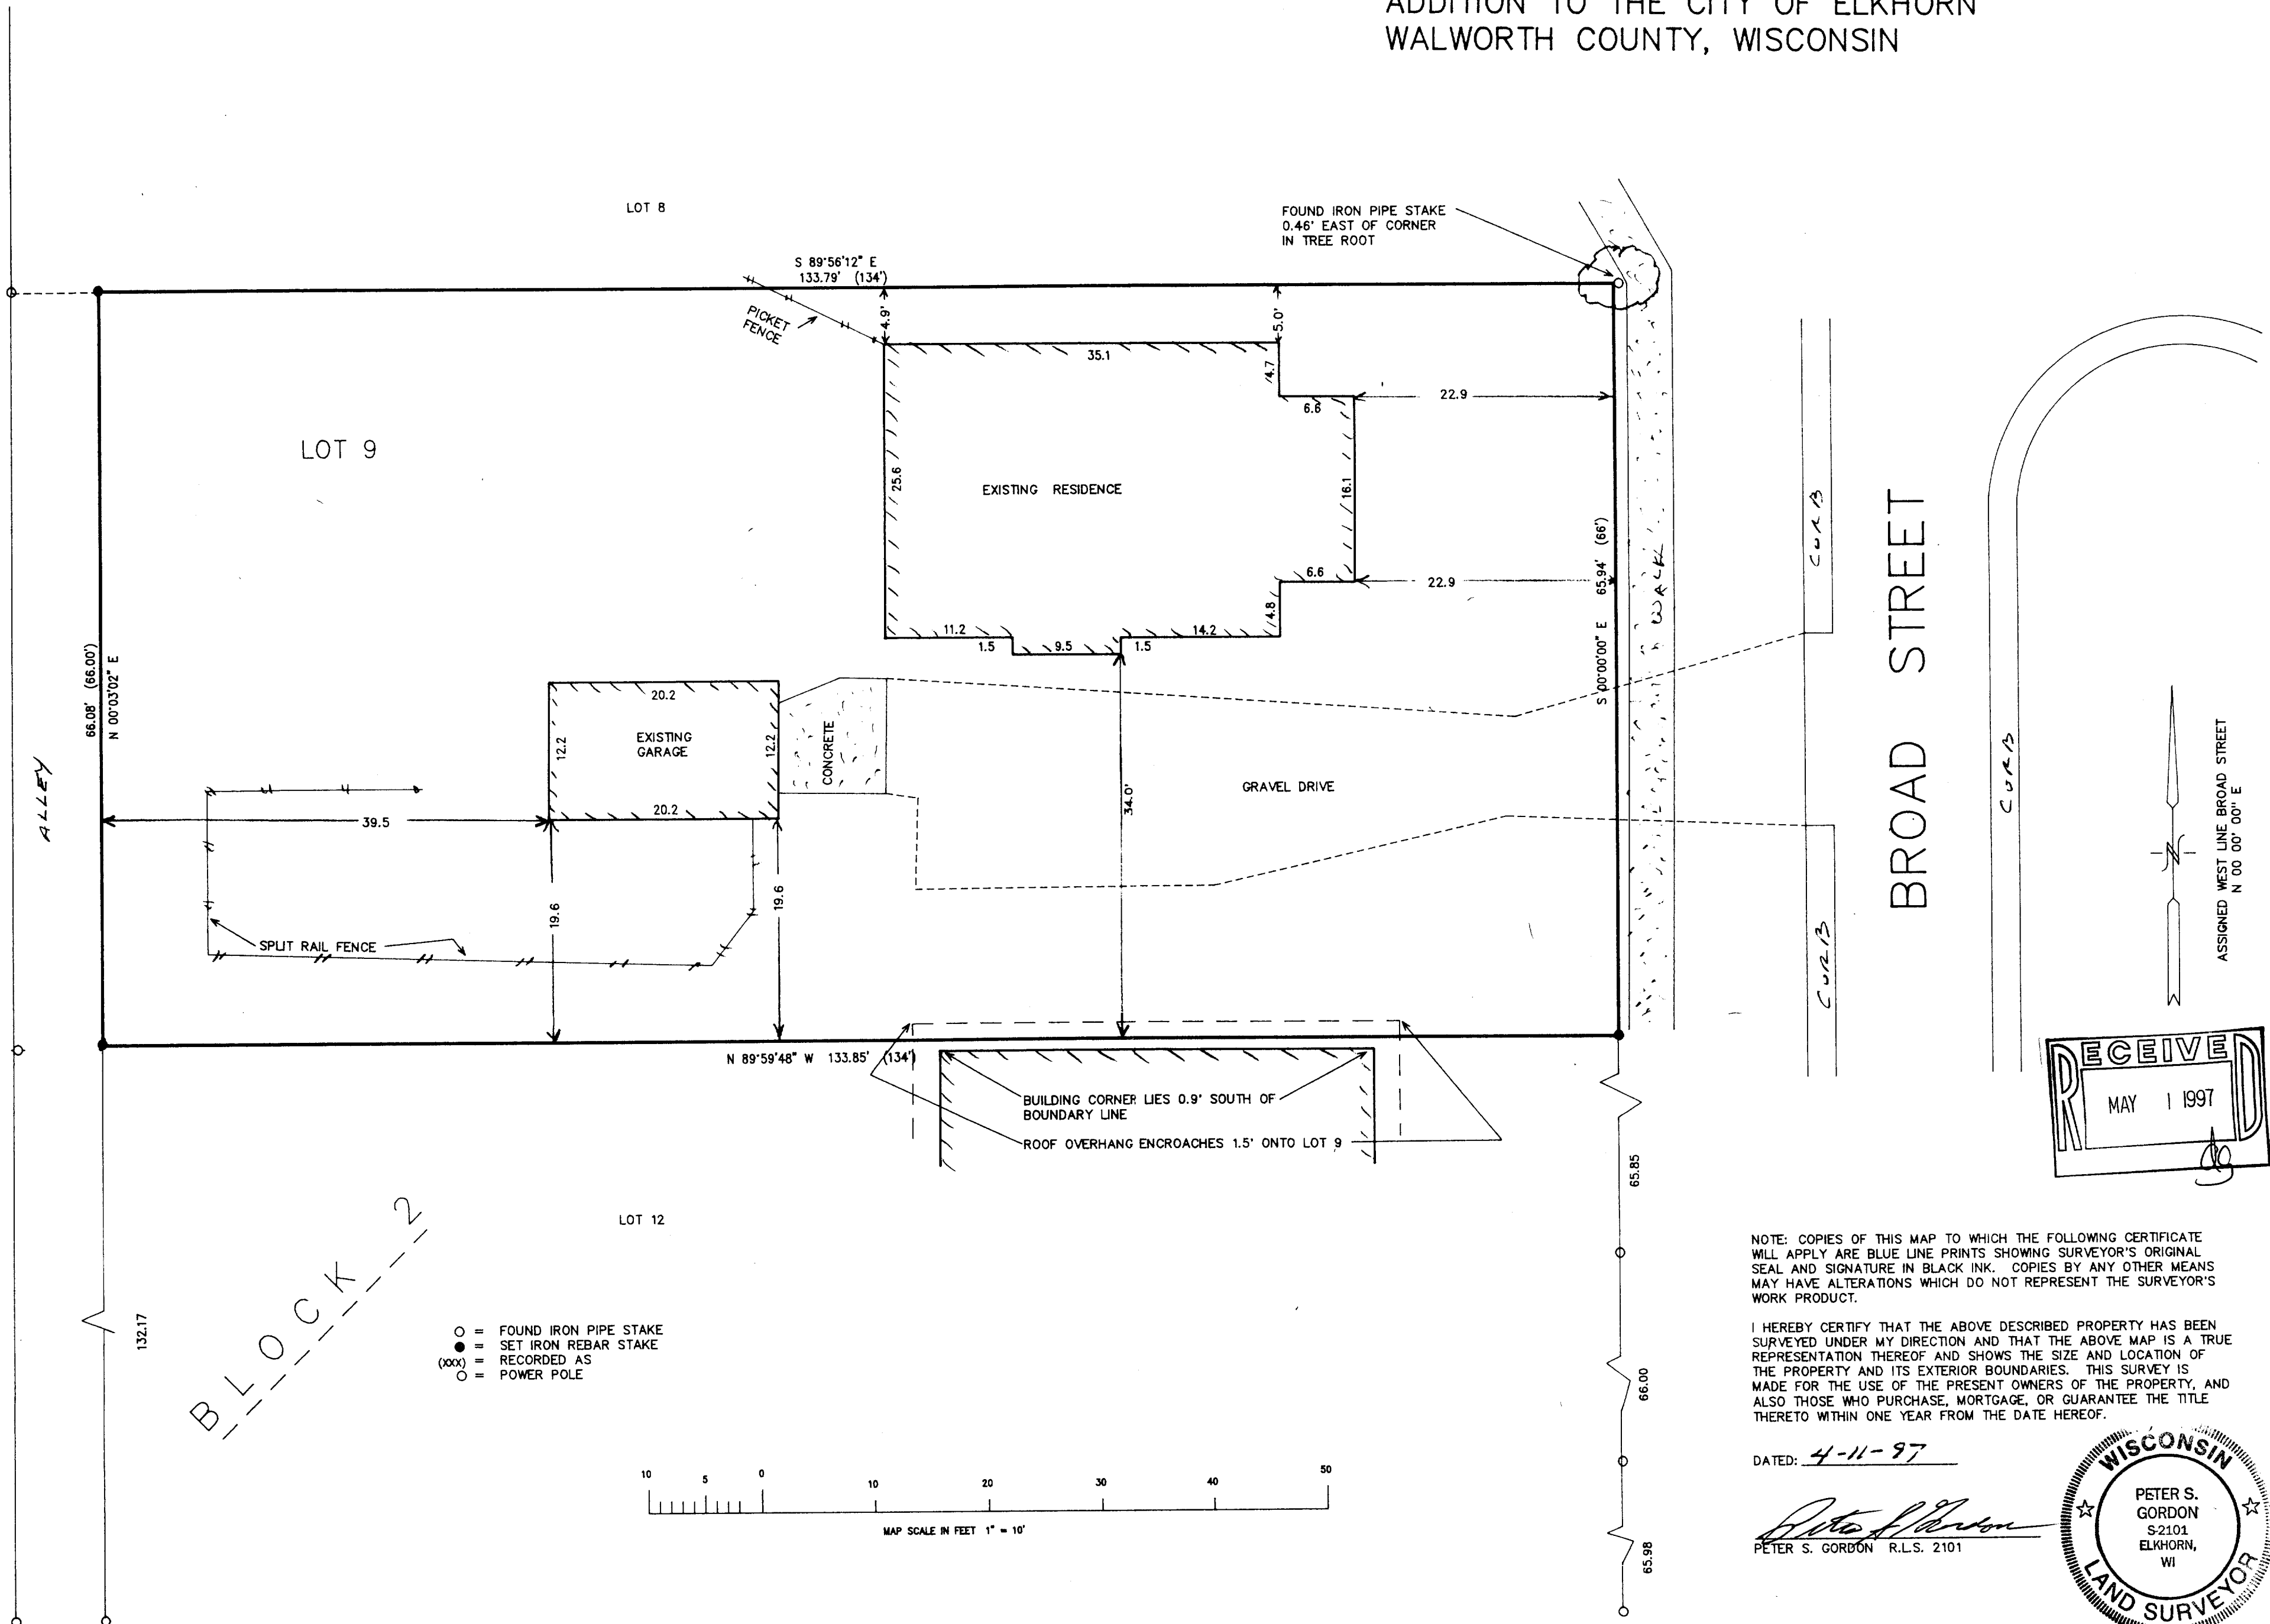

BLOCK 2

- = FOUND IRON PIPE STAKE
- = SET IRON REBAR STAKE
- (X) = RECORDED AS
- = POWER POLE

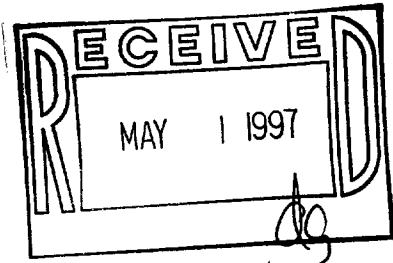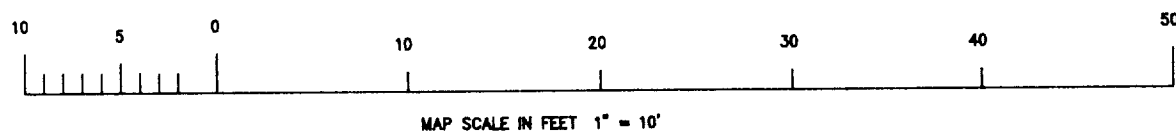

NOTE: COPIES OF THIS MAP TO WHICH THE FOLLOWING CERTIFICATE WILL APPLY ARE BLUE LINE PRINTS SHOWING SURVEYOR'S ORIGINAL SEAL AND SIGNATURE IN BLACK INK. COPIES BY ANY OTHER MEANS MAY HAVE ALTERATIONS WHICH DO NOT REPRESENT THE SURVEYOR'S WORK PRODUCT.

I HEREBY CERTIFY THAT THE ABOVE DESCRIBED PROPERTY HAS BEEN SURVEYED UNDER MY DIRECTION AND THAT THE ABOVE MAP IS A TRUE REPRESENTATION THEREOF AND SHOWS THE SIZE AND LOCATION OF THE PROPERTY AND ITS EXTERIOR BOUNDARIES. THIS SURVEY IS MADE FOR THE USE OF THE PRESENT OWNERS OF THE PROPERTY, AND ALSO THOSE WHO PURCHASE, MORTGAGE, OR GUARANTEE THE TITLE THERETO WITHIN ONE YEAR FROM THE DATE HEREOF.

DATED: 4-11-97

*Peter S. Gordon*  
PETER S. GORDON R.L.S. 2101



WORK ORDERED BY:  
LLOYD & JULIE ROMIE  
632 N. BROAD ST.  
ELKHORN

FARRIS, HANSEN & ASSOCIATES, INC.  
Engineering, Architecture, Surveying  
7 Ridgeway Court P.O. Box 437  
ELKHORN, WISCONSIN 53121  
Office: (414) 723-2098  
Fax: (414) 723-5886

REVISIONS

PROJECT NO.	4739
DATE	04-10-97
SHEET NO.	1 OF 1

VHT-17  
804-1037