


DESCRIPTION: Lot 14 of the Landmark Subdivision in the City of Elkhorn, Walworth County, Wisconsin.

CERTIFICATE: I James F. Biagi, Surveyor, do hereby certify that I have surveyed the above described property and the measurements and elevations shown on the above drawing are as shown.

SIGNED AND SEALED THIS 22ND DAY OF JUNE 1959.

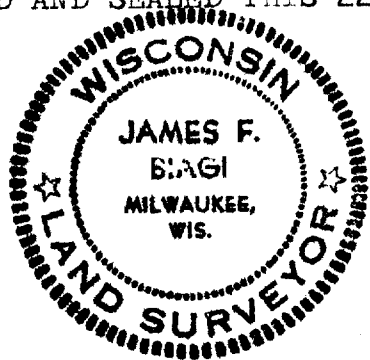

James F. Biagi
SURVEYOR (272)