


DESCRIPTION: Lot # 19 of the Landmark Subdivision in the City of Elkhorn, Walworth County, Wisconsin

CERTIFICATE: I James F. Biagi, Surveyor, do hereby certify that I have surveyed the property hereon described, and that the location of the improvements are as shown on the above drawing.

RECORDED AND SEALED 22 Feb, 1960.

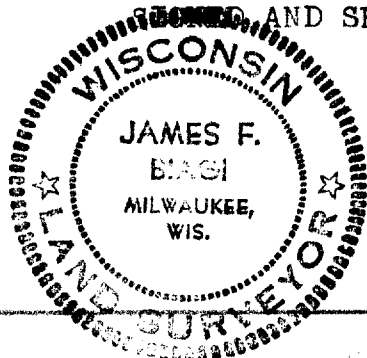

James F. Biagi
James F. Biagi RLS (272)