



PREPARED FOR
ELAINE JOHNSON
KEEFE REAL ESTATE
LAKE GENEVA WI

PLAT OF SURVEY

- OF -

PATHFINDER SURVEYING INC.
(formerly)
J.K. SURVEYING INC.
P.O BOX 322
LAKE GENEVA, WI. 53147
262-248-8303

LOT 7 AND THE WEST 8 FEET OF LOT 8, BARTELSON SUBDIVISION, LOCATED IN
SECTION 36, TOWN 3 NORTH, RANGE 16 EAST, CITY OF ELKHORN, COUNTY
OF WALWORTH AND STATE OF WISCONSIN.

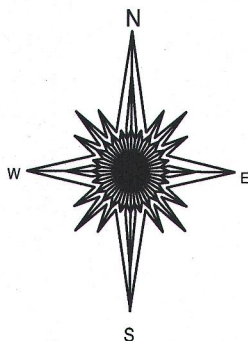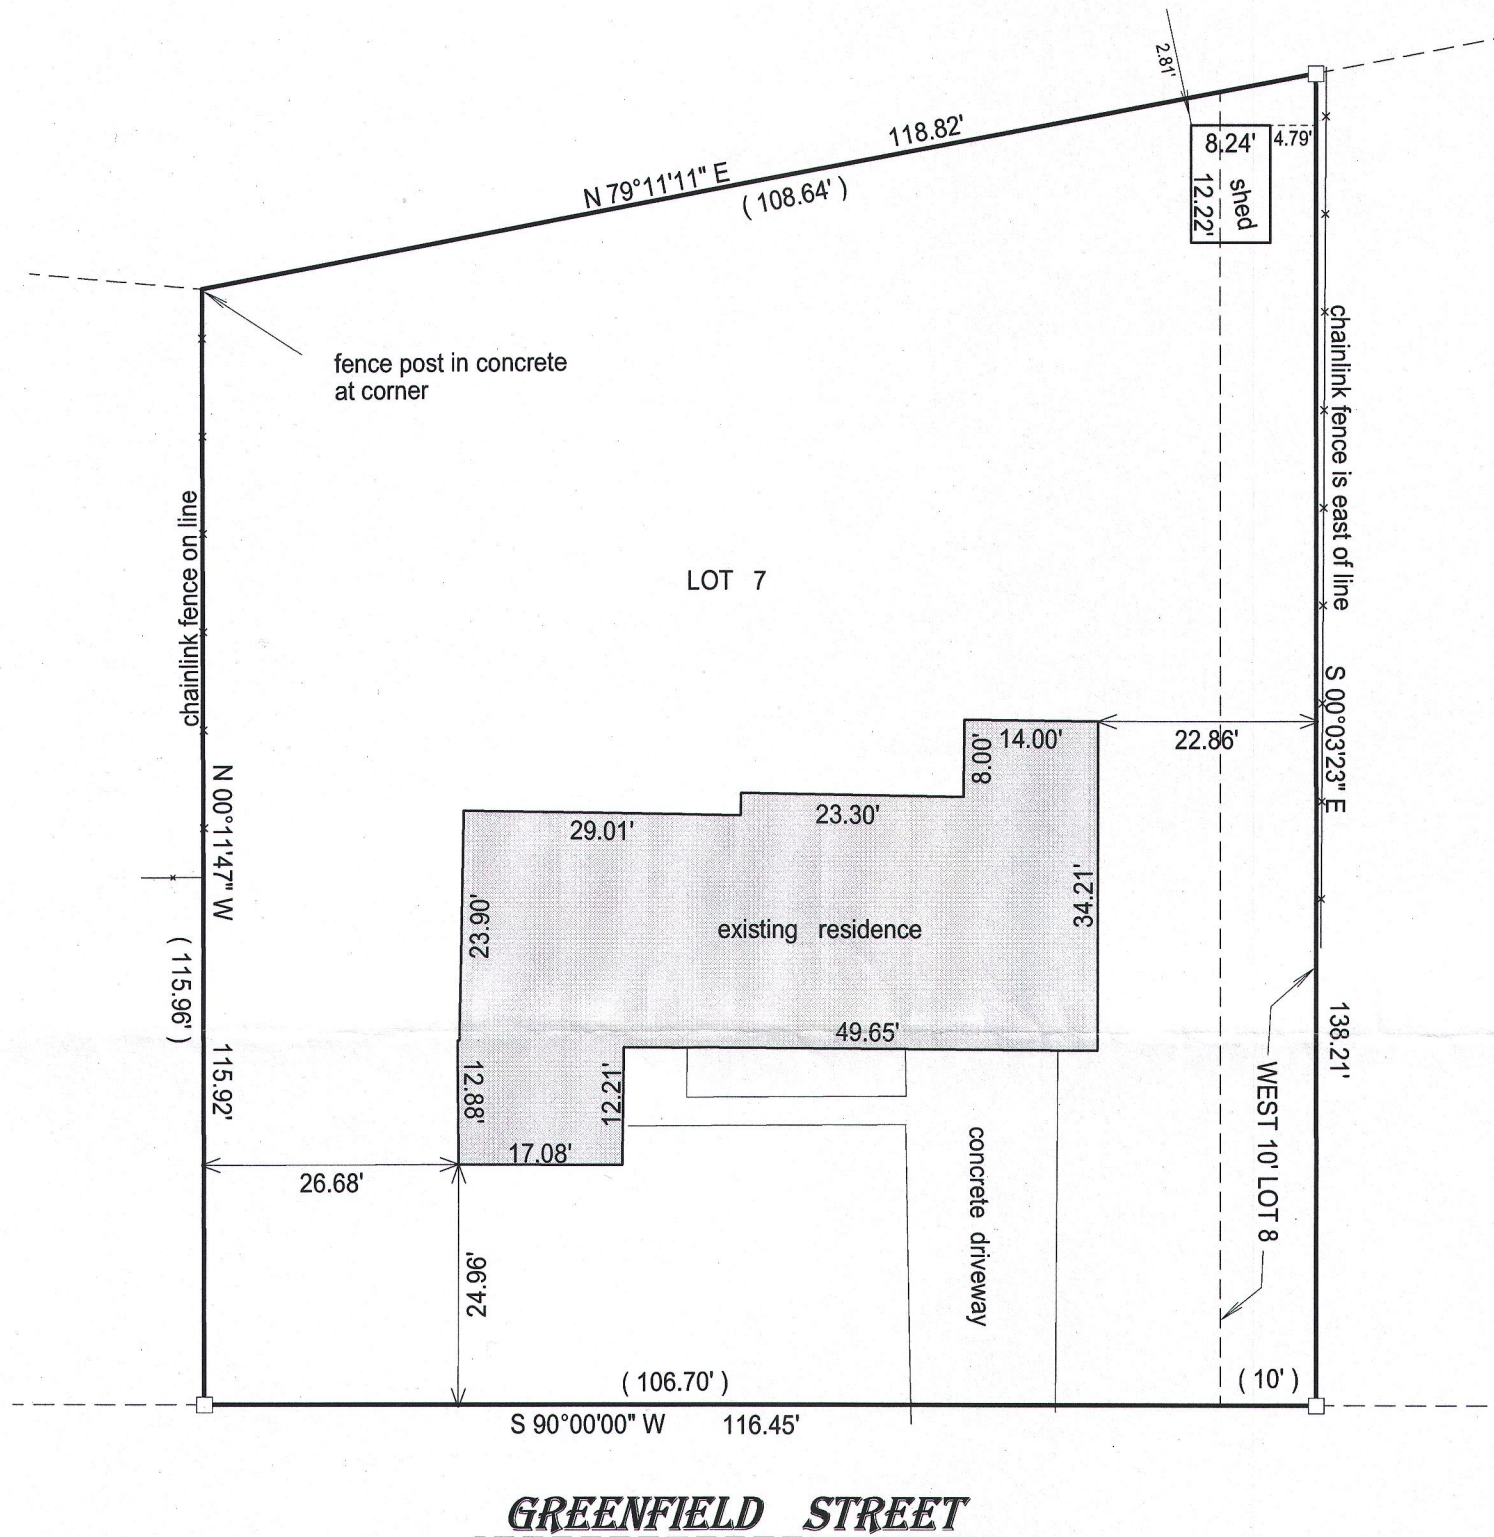


- () = recorded as
- = set iron bar
- = found iron bar
- = found iron pipe
- = set iron pipe

SCALE 1" = 20'

JOB # 16-119

TAX ID #
YB00006


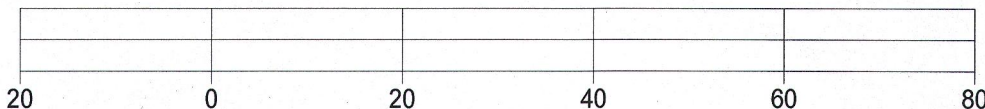


BASIS OF BEARING OF THIS PLAT: THE NORTH LINE OF GREENFIELD
WAS ASSUMED TO BEAR WEST AS MONUMENTED.

"I hereby certify that I have surveyed the above described property and that the above
map is a true representation of its exterior boundary and shows the size and location of
all visible structures, apparent easements and encroachments if any."

This survey is made for the present owners of the property, and those who
purchase, mortgage, or guarantee the title thereto, within one year from
the date hereof.

DATED THIS 5TH DAY OF MAY, 2016.

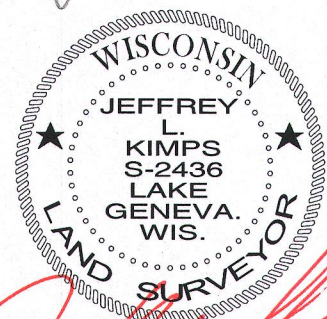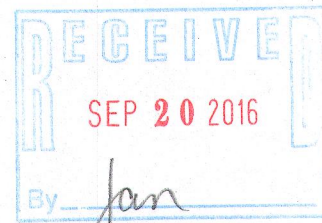

JEFFREY L KIMPS S - 2436
Wisconsin Professional Land Surveyor
(original if signed in red)