

Farris, Hansen & Associates, Inc.

Engineering, Surveying & Land Planning
P.O. BOX 487
715 W. WALWORTH STREET
ELKHORN, WISCONSIN 53121


PLAT OF SURVEY OF LOT 21,
EDGEWOOD ESTATES, 1st ADDITION,
CITY OF ELKHORN, WALWORTH COUNTY
WISCONSIN.

WORK ORDERED BY: SCHAUDER BUILDING
AND REALTY

LEGEND

- ⊙ - IRON PIPE SET
- - IRON PIPE FOUND
- () - RECORD DIMENSION

GARAGE FLOOR
ON LOT 23
EL. = 1015.7

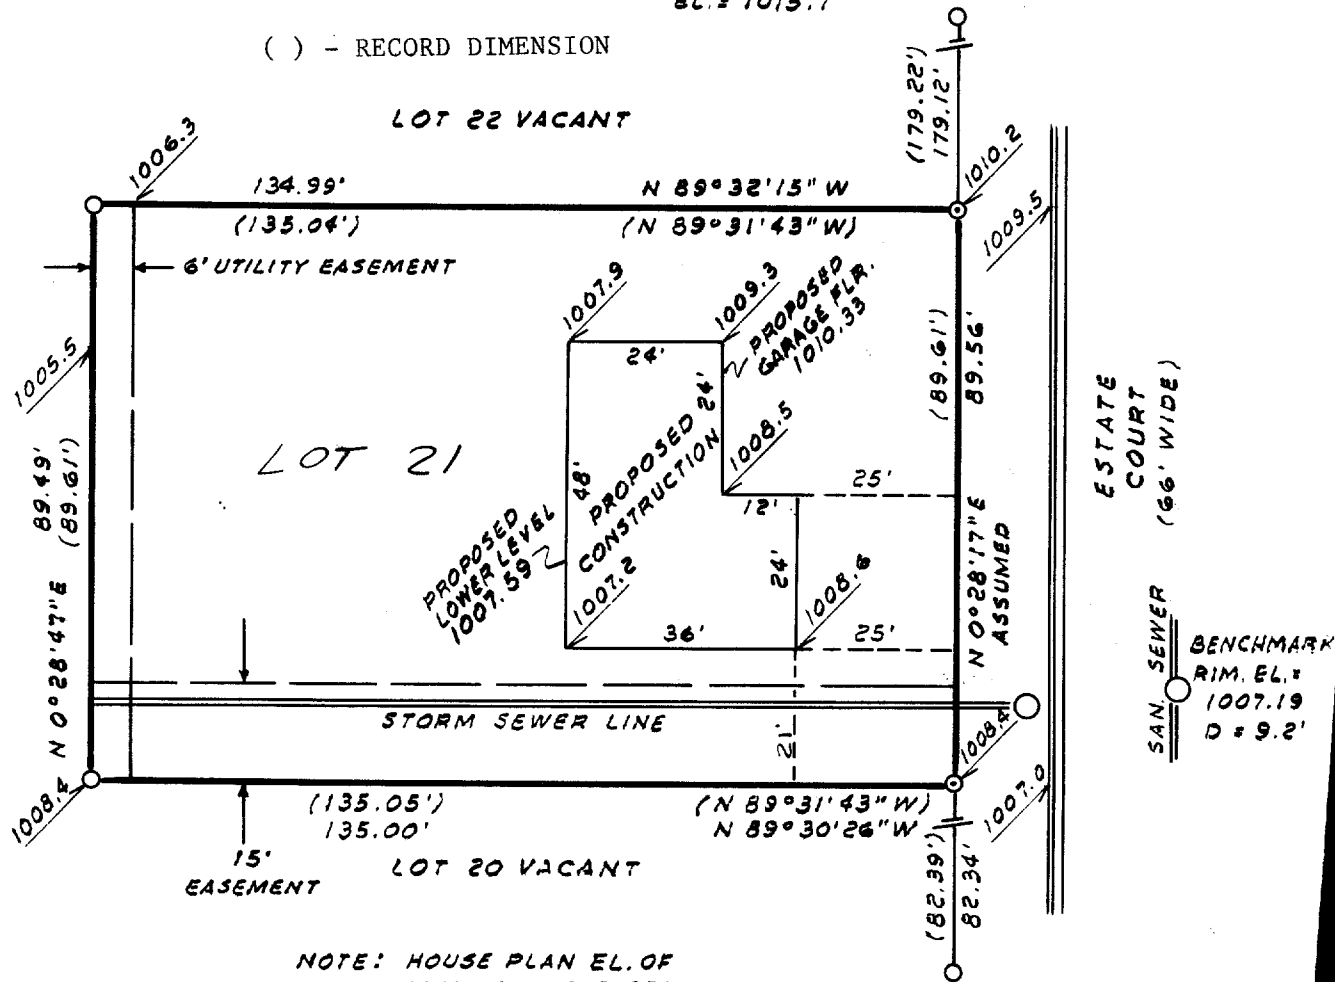

NOTE: HOUSE PLAN EL. OF
100'-0" = 1010.67'

GARAGE FLOOR ON LOT 19 EL. = 1013.1


I Hereby Certify that this Plat is a true and accurate representation of the lot lines and of the elevations shown to the best of my professional knowledge and belief.

William R. Ohberg
William R. Ohberg, R.L.S.

Dated this 19TH day of MARCH, 1984



4DWI-15

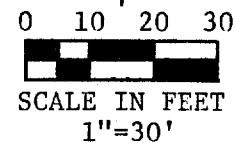

PROJECT #2223

4-346'

Farris, Hansen & Associates, Inc.


Engineering, Surveying & Land Planning
P.O. BOX 487
715 W. WALWORTH STREET
ELKHORN, WISCONSIN 53121

PLAT OF SURVEY OF LOT 21,
EDGEWOOD ESTATES, 1st ADDITION,
CITY OF ELKHORN, WALWORTH COUNTY
WISCONSIN.

WORK ORDERED BY: SCHAUDER BUILDING
AND REALTY

LEGEND

- ⊙ - IRON PIPE SET
- - IRON PIPE FOUND
- () - RECORD DIMENSION

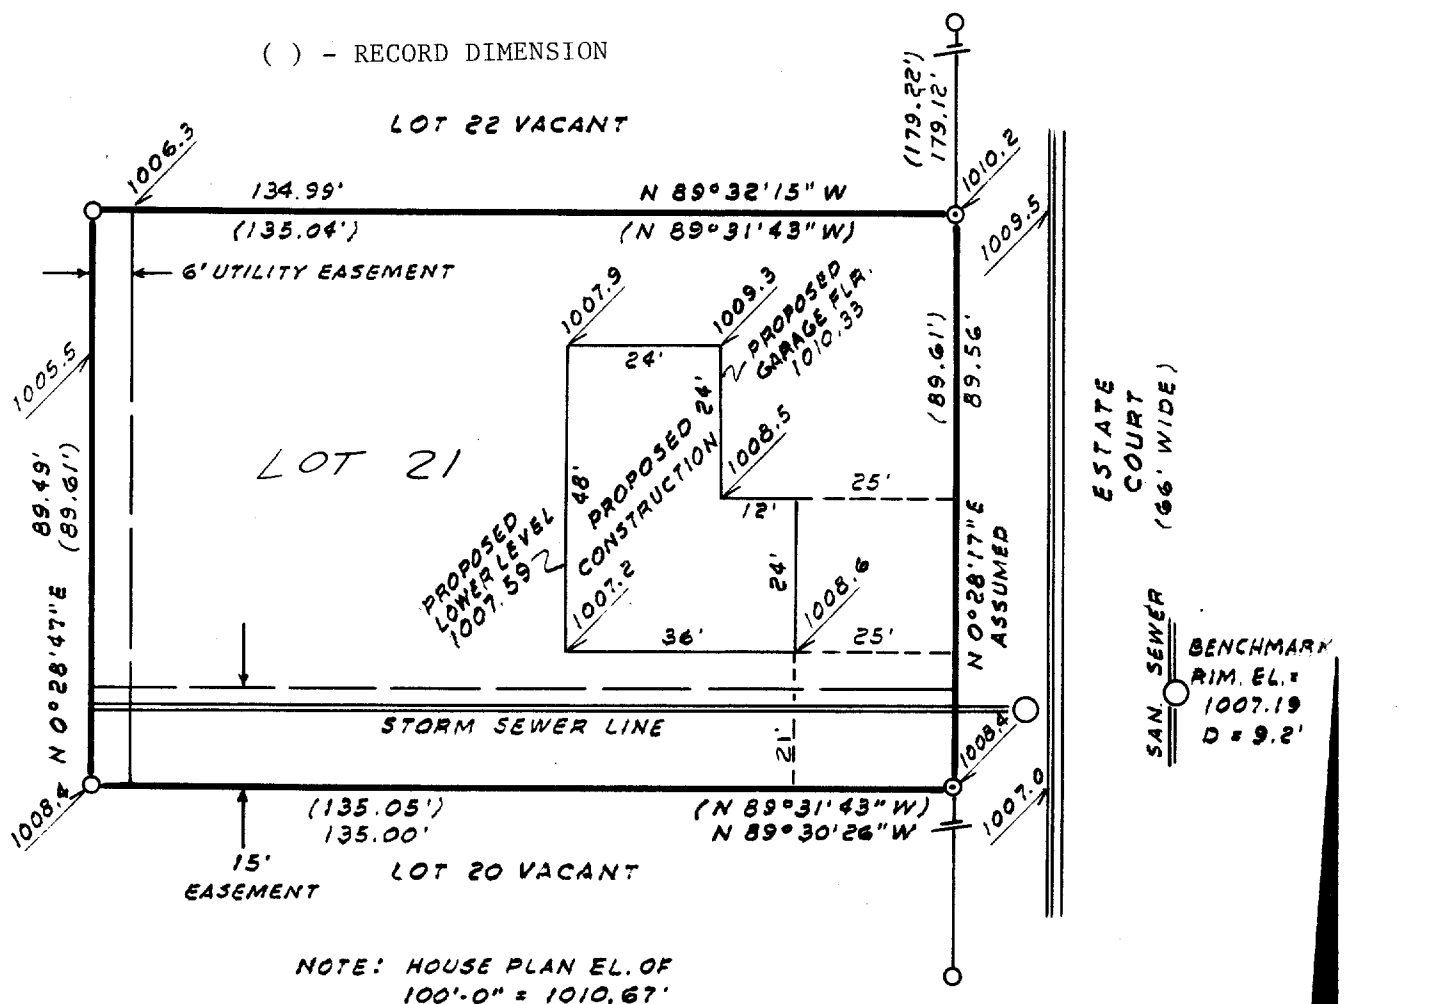

NOTE: HOUSE PLAN EL. OF
100'-0" = 1010.67'

I Hereby Certify that this Plat is a true and accurate representation of the lot lines and of the elevations shown to the best of my professional knowledge and belief.


William R. Ohberg
William R. Ohberg, R.L.S.

Dated this 19TH day of MARCH, 1984



0 10 20 30
SCALE IN FEET
1"=30'

PROJECT #2223

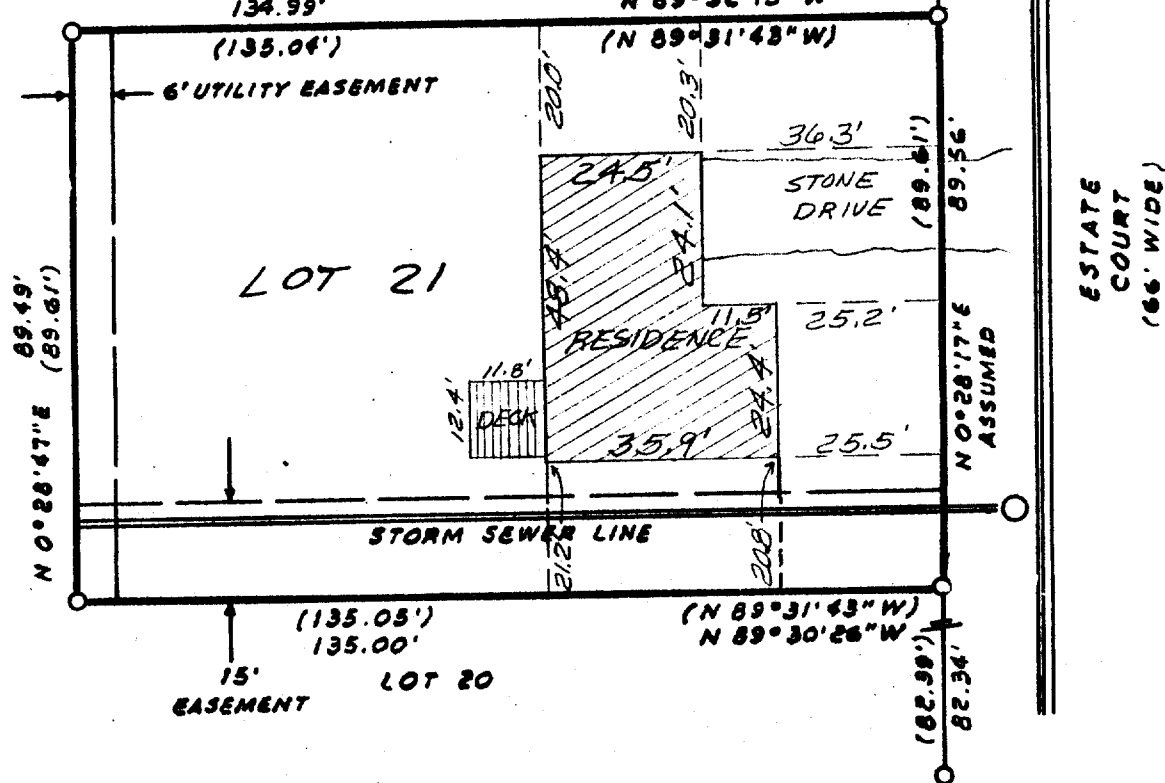

LEGEND


○ = iron pipe stake found
 (xxx) = record dimension

PLAT OF SURVEY OF LOT 21,
 EDGEWOOD ESTATES, 1st ADDITION,
 CITY OF ELKHORN, WALWORTH COUNTY
 WISCONSIN.

WORK ORDERED BY: SCHAUDER BUILDING
 AND REALTY

I hereby certify that this Plat of Survey is a
 true and accurate representation of the lot lines
 and of the location of the existing new structure
 to the best of my professional knowledge and belief.

Robert A. Farris
 Robert A. Farris RLS

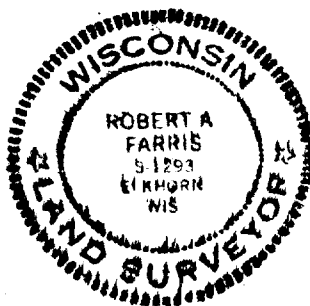

Dated this 14 th day of May, 1984

0 10 20 30
 SCALE IN FEET
 1"=30'

PROJECT #2223