


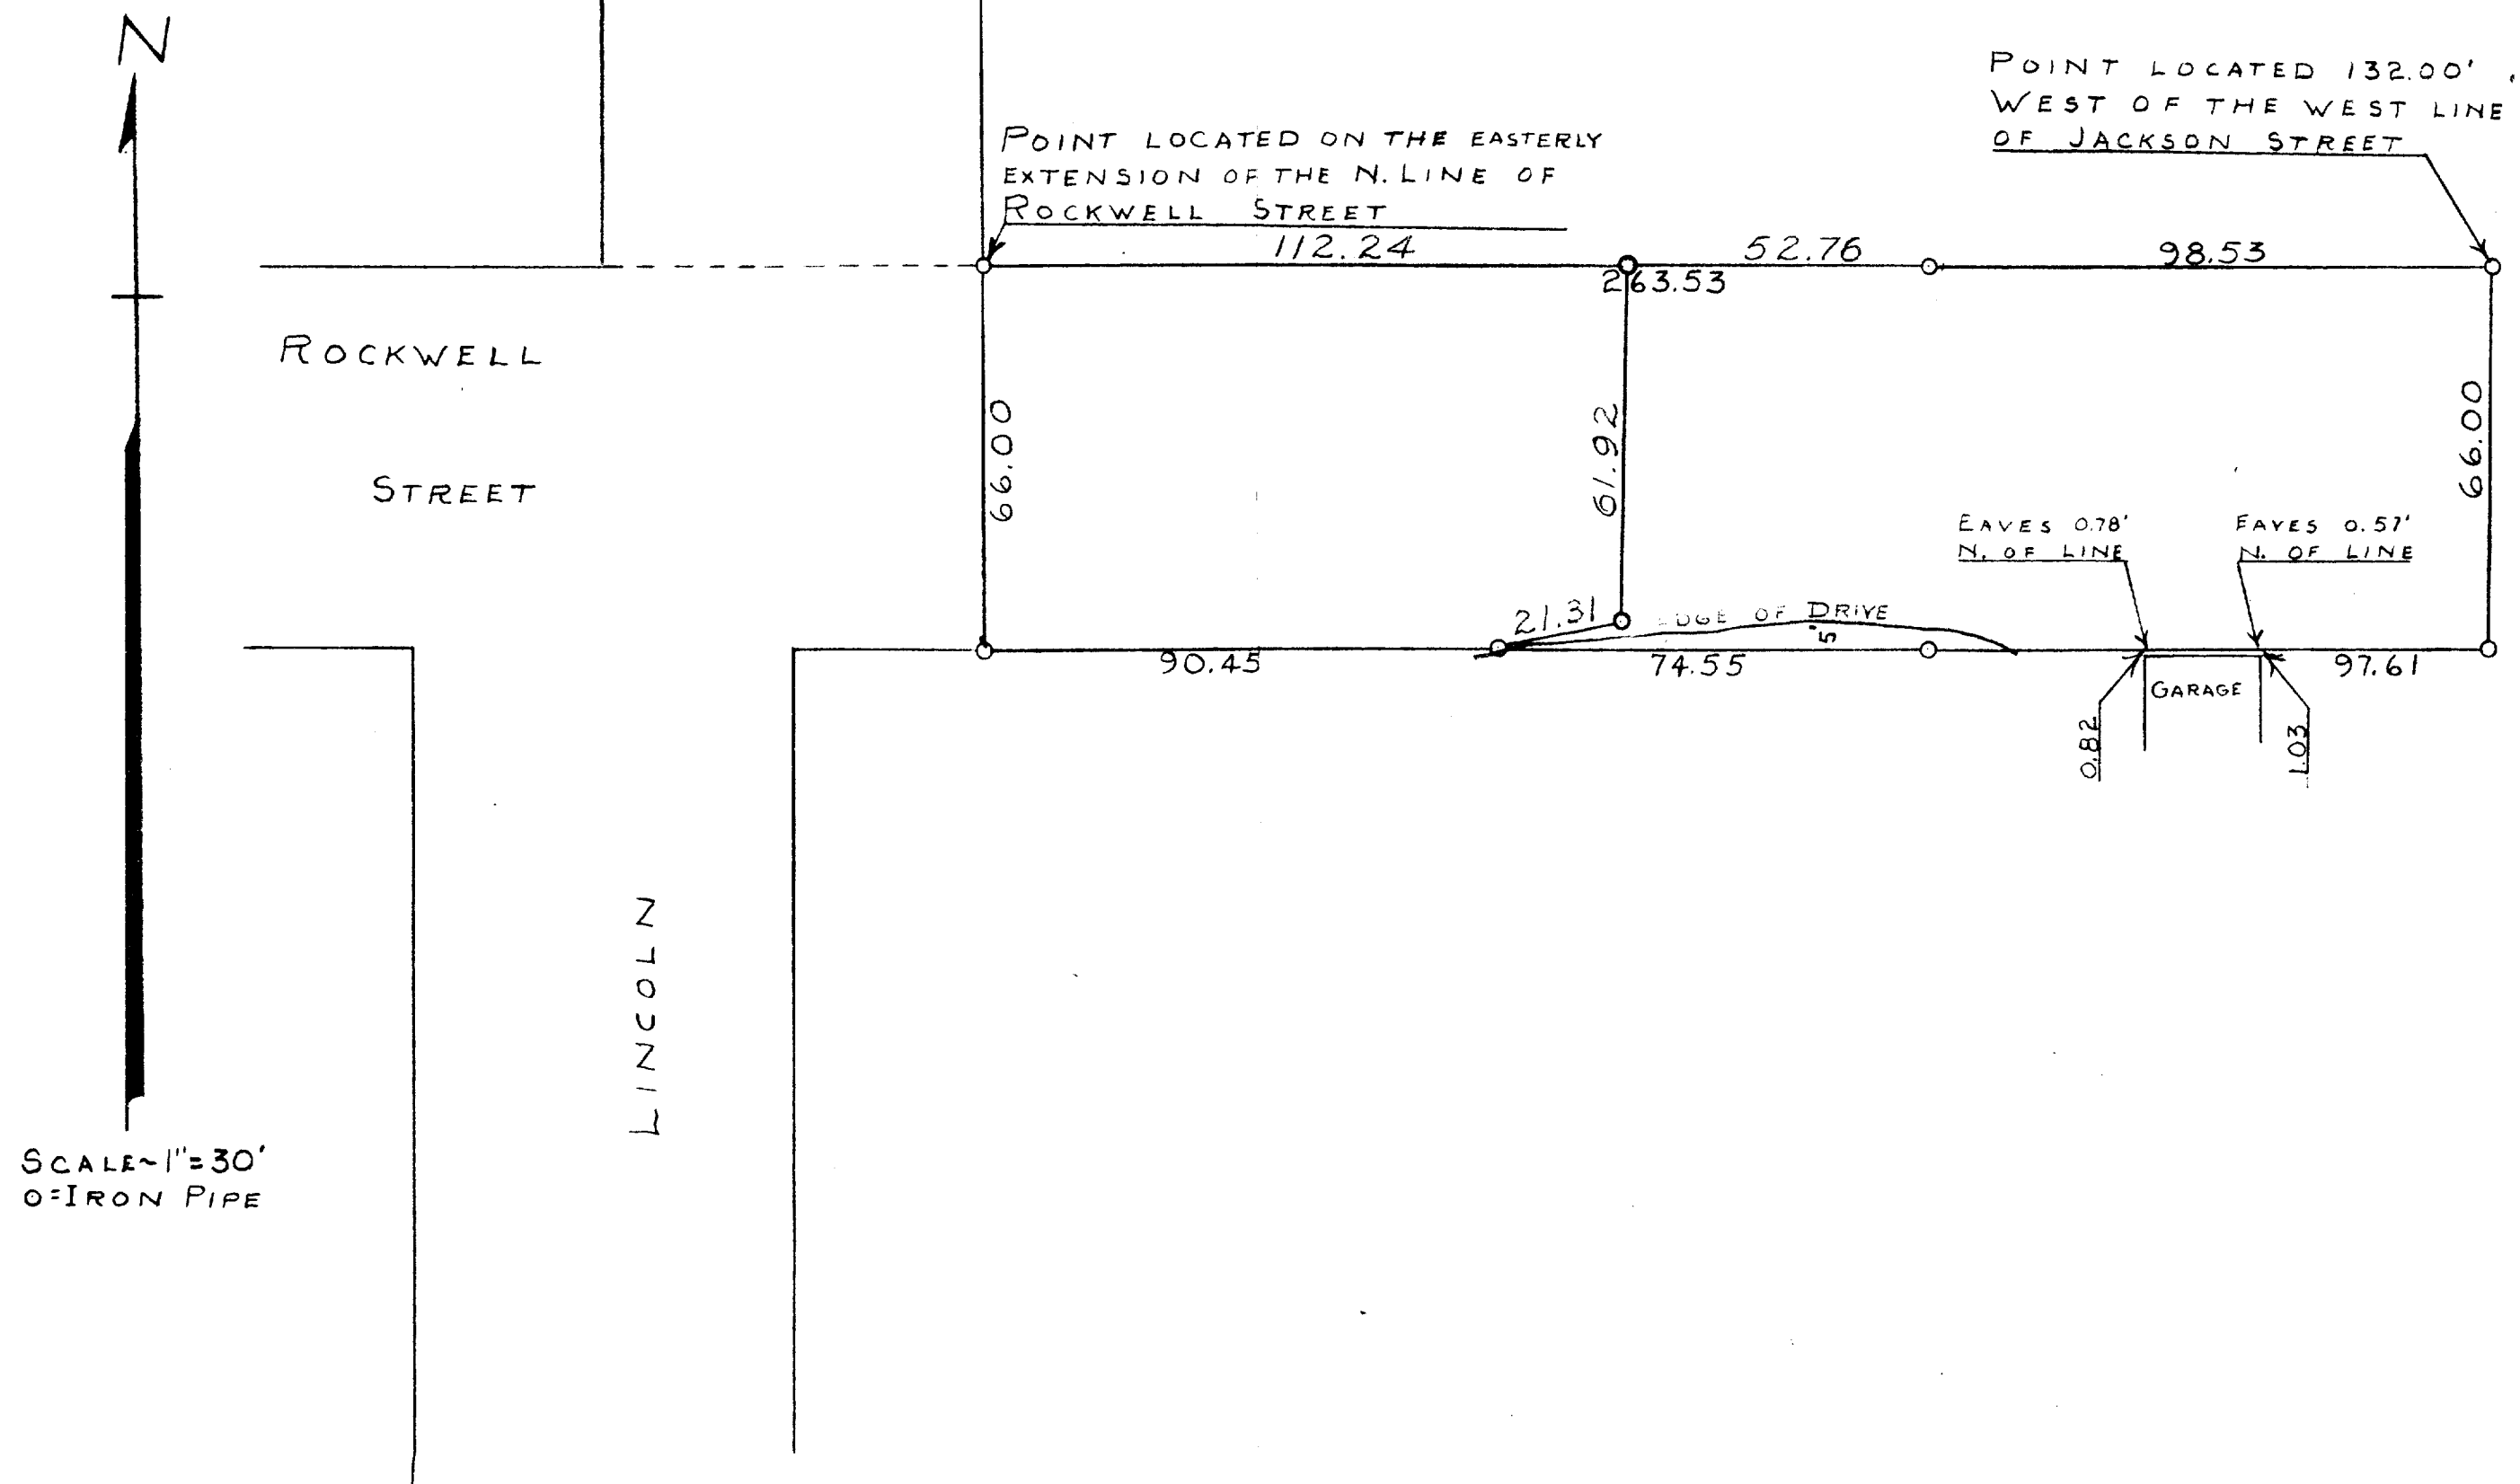

PLAT OF SURVEY OF PART OF BLOCK 1, ELDERKIN'S ADDITION TO THE
VILLAGE (NOW CITY) OF ELKHORN, WALWORTH COUNTY, WISCONSIN
SEPT. 30, 1954
REVISED JULY 18, 1957

George T. Dunham
GEORGE T. DUNHAM, SURVEYOR
DELAVER, WISCONSIN

Y&K-11 + A Y&K-12

~~EK-11 (part of)~~

4-1