


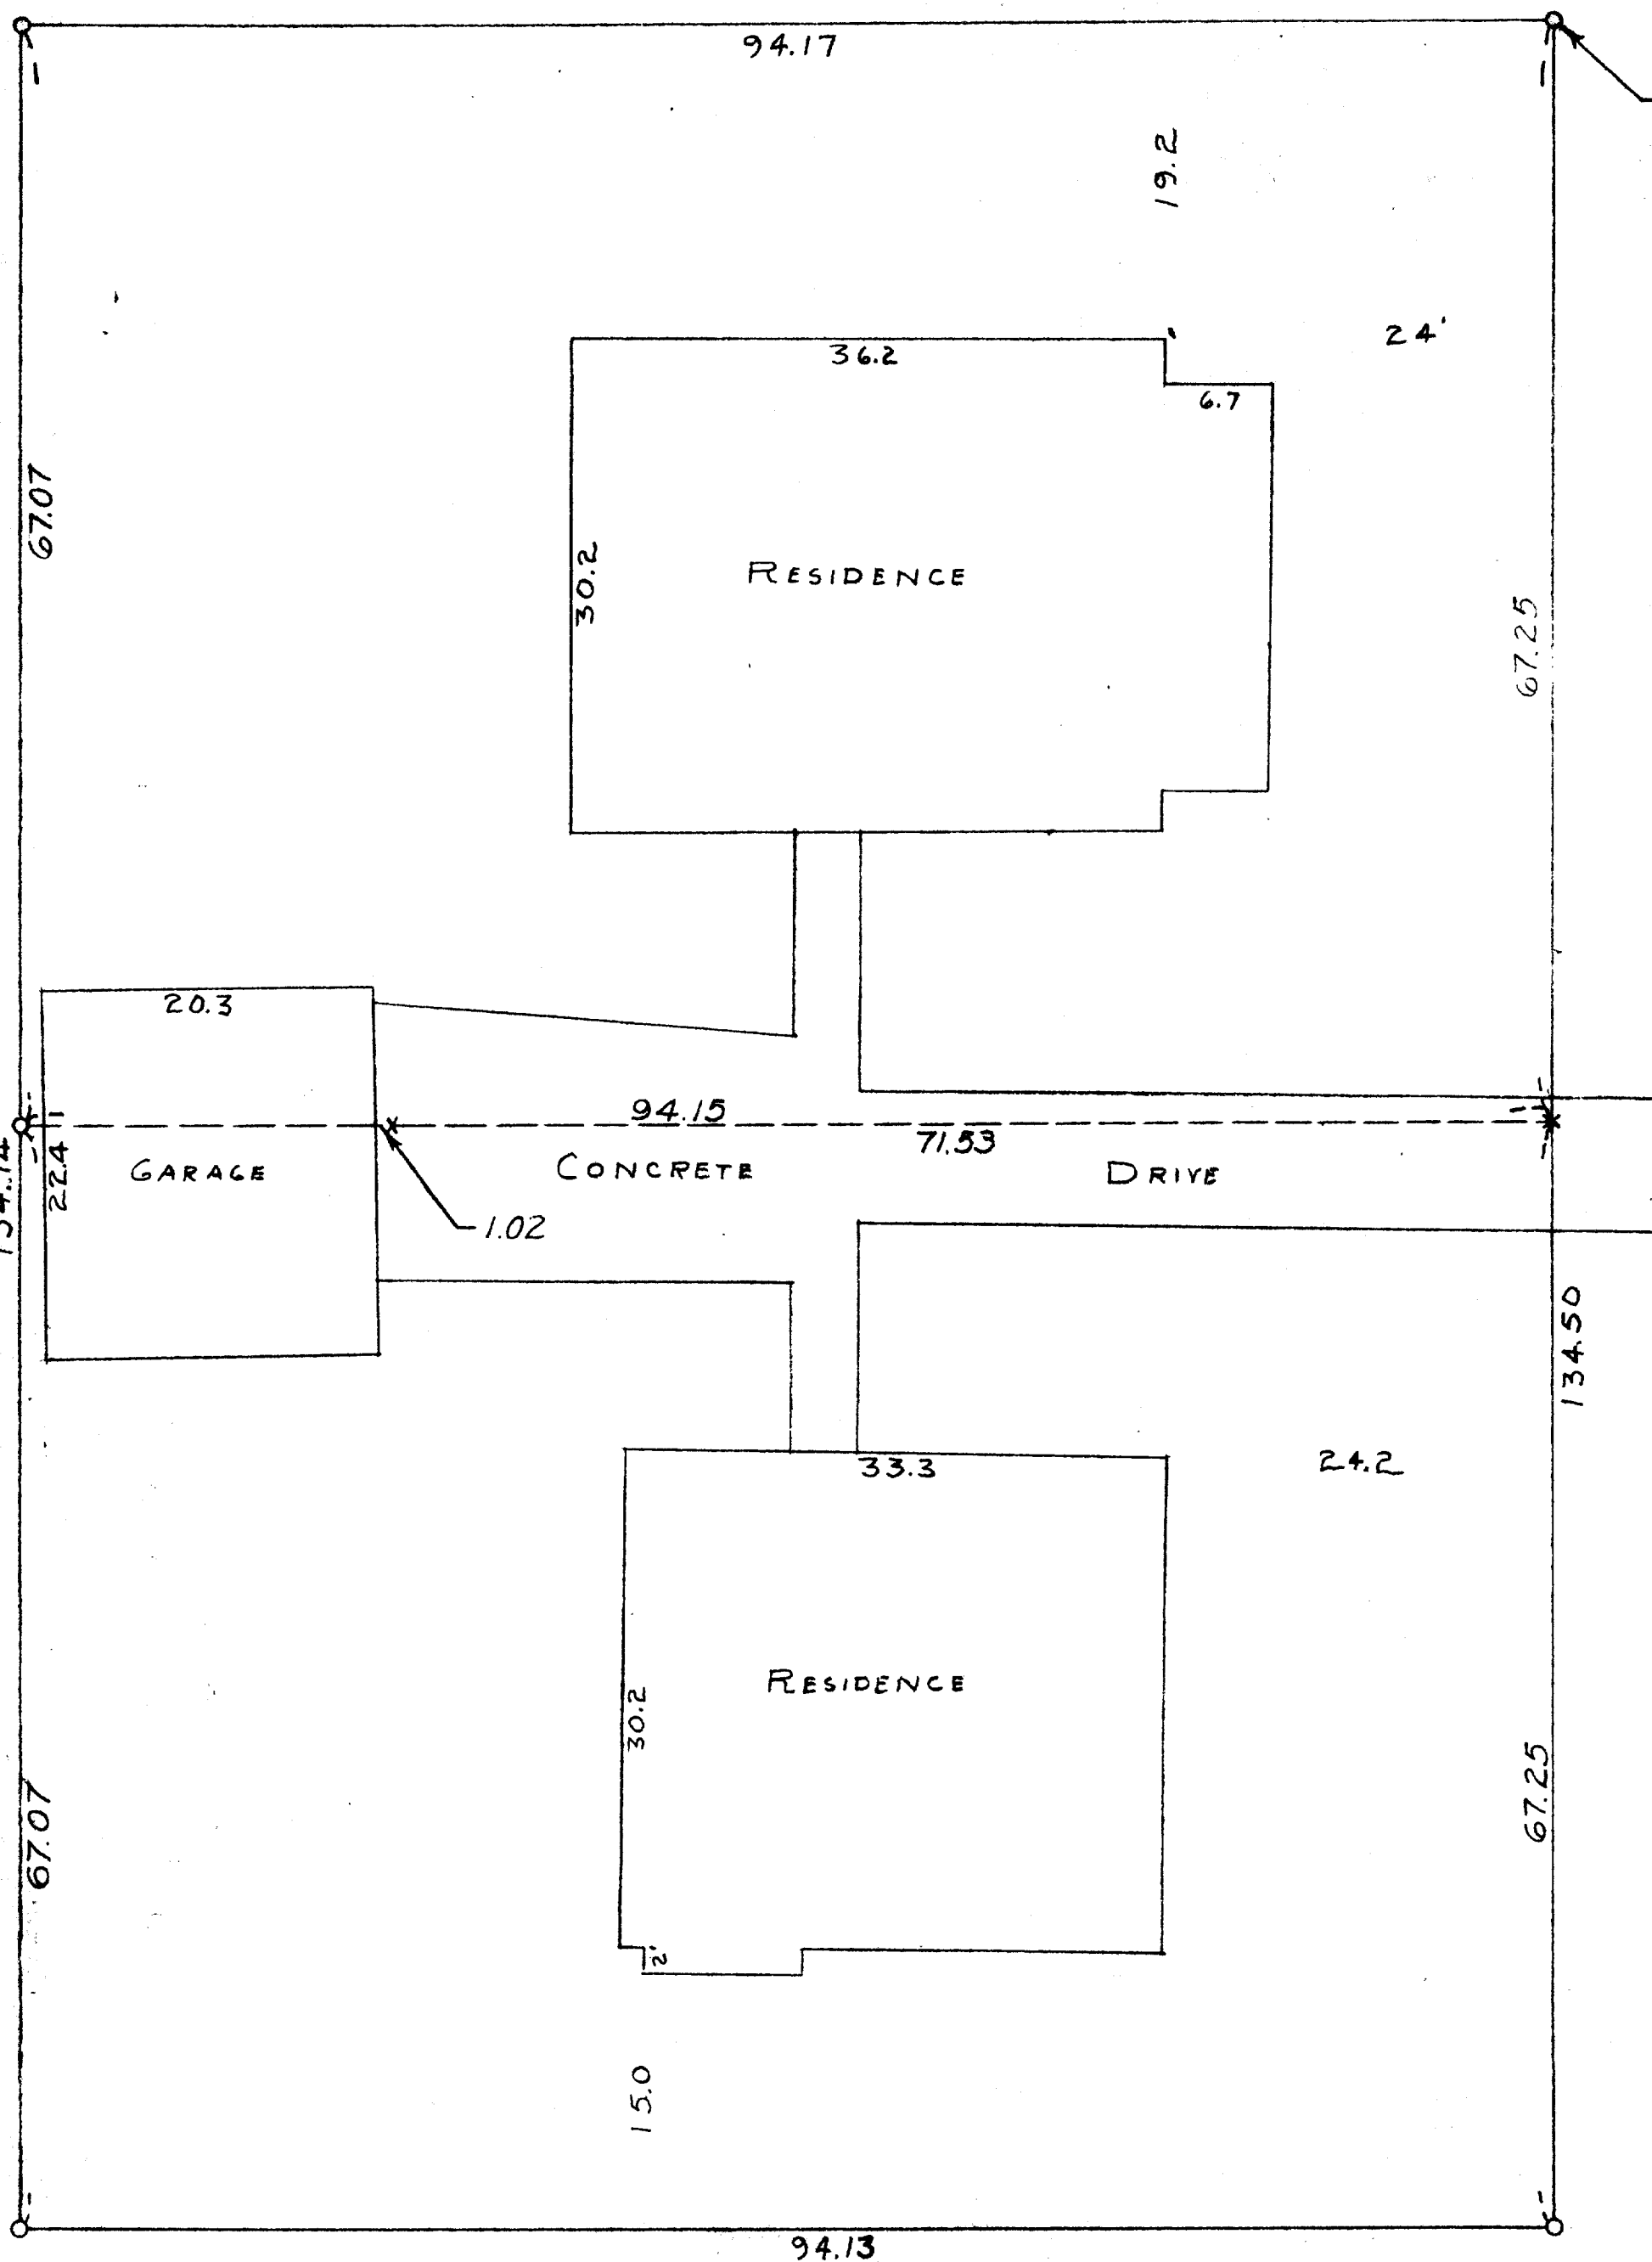

POINT LOCATED 66.00 FEET SOUTH OF THE NORTHEAST CORNER OR LOT 2, BLOCK 33 ROCKWELL'S ADDITION

LINCOLN
SOUTH

SCALE - 1" = 10'
O - IRON PIPE
X - CROSS IN CONC.

PLAT OF SURVEY OF PART OF LOTS 2, 3 AND 4, BLOCK 33 OF ROCKWELL'S ADDITION TO THE CITY OF ELKHORN, WALWORTH COUNTY, WISCONSIN.

JUNE 1958

RW 71-72

YRW-71, 72

George T. Dunham
GEORGE T. DUNHAM, SURVEYOR
DELAN, WISCONSIN

4-10