


W 238 S 3712 BIG BEND ROAD
WAUKESHA, WIS 53186

TELEPHONE
542-5616

RONALD H. ZIMMERMAN
REGISTERED LAND SURVEYOR

PLAT OF SURVEY
FOR
WAUKESHA SAVINGS & LOAN

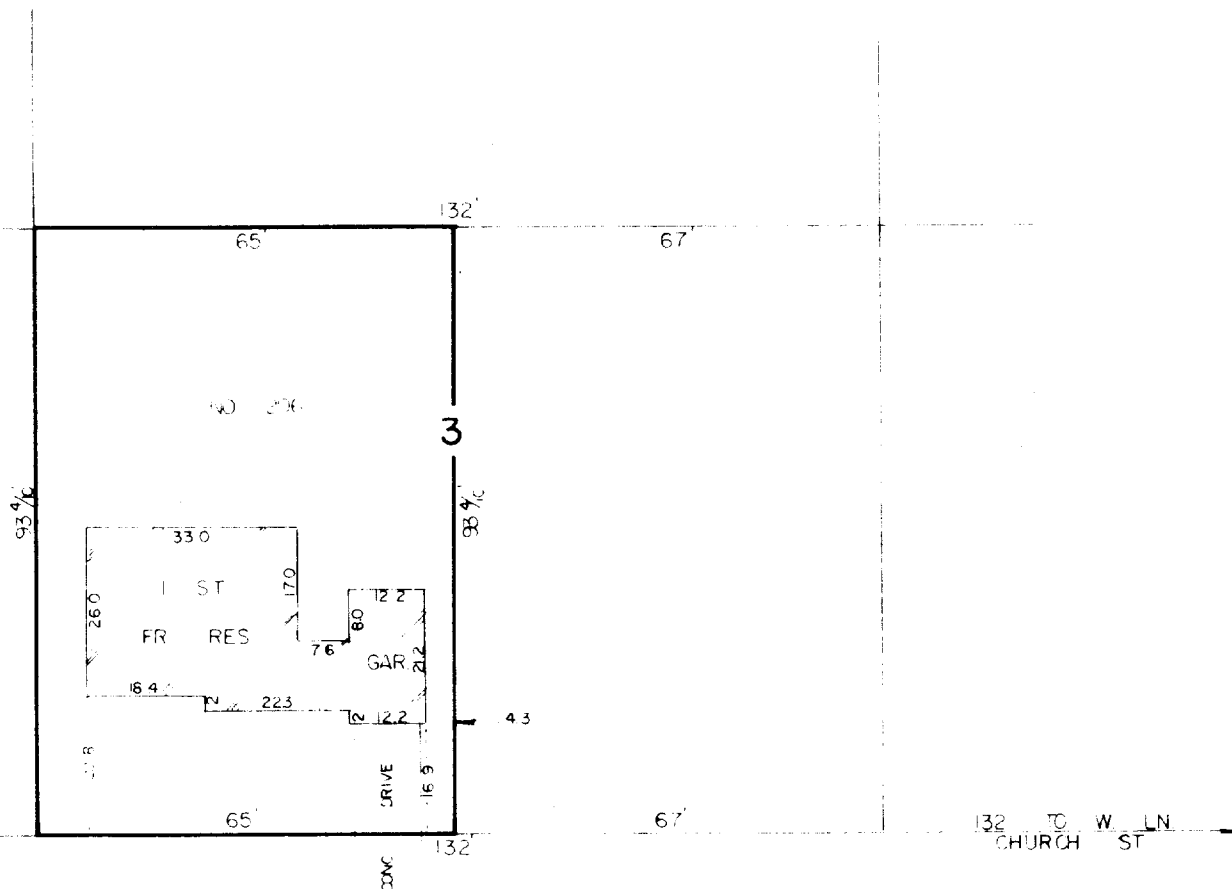

66

N.

PAGE

STREET

SCALE 1" = 30'

CERTIFICATION

STATE OF WISCONSIN)
COUNTY OF WAUKESHA) SS

I, RONALD H. ZIMMERMAN, REGISTERED LAND SURVEYOR, DO HEREBY CERTIFY THAT I HAVE MADE A SURVEY
OF W 65' LOT 3, BLK 6, ORIGINAL PLAT OF VILLAGE OF ELKHORN
AND THE EXISTING BUILDING AND IMPROVEMENTS LOCATED THEREON AND THAT THE PLAT HERewith DRAWN
IS A CORRECT REPRESENTATION OF SAID SURVEY.

DATE NOV 30 1973

RONALD H. ZIMMERMAN

S - 868

4-102