


RONALD H. ZIMMERMAN
REGISTERED LAND SURVEYOR

PLAT OF SURVEY

FOR

WAUKESHA SAVINGS & LOAN

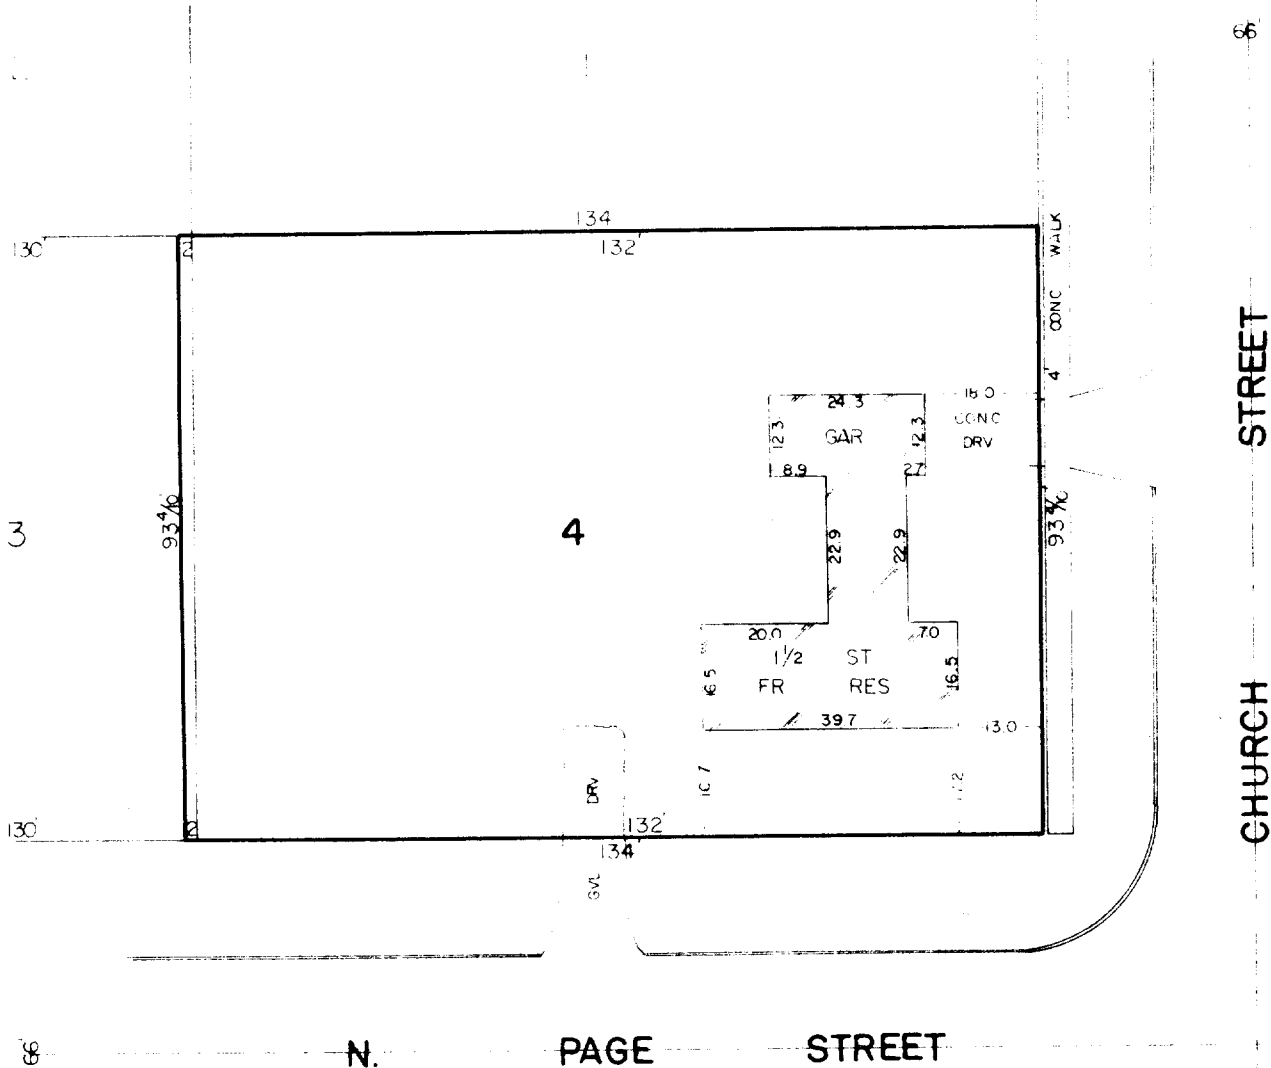

N. PAGE STREET

N.



SCALE 1" = 30'

CERTIFICATION

STATE OF WISCONSIN)
COUNTY OF WAUKESHA)

I, RONALD H. ZIMMERMAN, REGISTERED LAND SURVEYOR, DO HEREBY CERTIFY THAT I HAVE MADE A SURVEY
OF LOTS 3 & 4, EXCEPT W 130 LOT 3, BLK 6, ORIG PLAT OF VILLAGE OF ELKHORN
AND THE EXISTING BUILDING AND IMPROVEMENTS LOCATED THEREON AND THAT THE PLAT HEREWITH DRAWN
IS A CORRECT REPRESENTATION OF SAID SURVEY

DATE NOV 30 19 73

Ronald H. Zimmerman
RONALD H. ZIMMERMAN S 868

4-103

YOP-17A