

PREPARED FOR : FIRST FINANCIAL BANK OF ELKHORN

BEGINNING AT THE SOUTHWEST CORNER OF BLOCK 24 IN THE VILLAGE, NOW CITY OF ELKHORN, ACCORDING TO THE RECORDED PLAT OF SAID VILLAGE, RUNNING THENCE NORTH 81.00', THENCE EAST TO THE EAST LINE OF SAID BLOCK, THENCE SOUTH IN THE EAST LINE OF SAID BLOCK 81.00' TO THE SOUTHEAST CORNER THEREOF, THENCE WEST IN THE SOUTH LINE OF SAID BLOCK TO THE PLACE OF BEGINNING.

PLAT OF SURVEY

973267

MARCH 11, 1997

MARCH 19, 1997

NIENOW ENGINEERING ASSOC. INC
(414) 534-9190 / FAX# 534-9192

FIRST FINANCIAL BANK
OF ELKHORN


SJN

GBF


$$1'' = 20'$$

PLAT OF SURVEY

1 OF 1

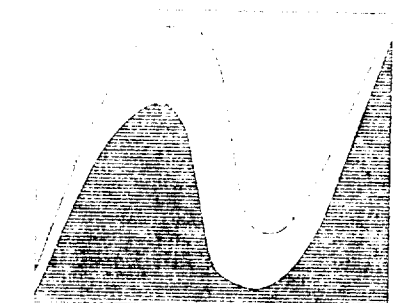

229 E. MAIN STREET
WATERFORD, WI 53185
PHONE (414) 534-9190
FAX (414) 534-9192

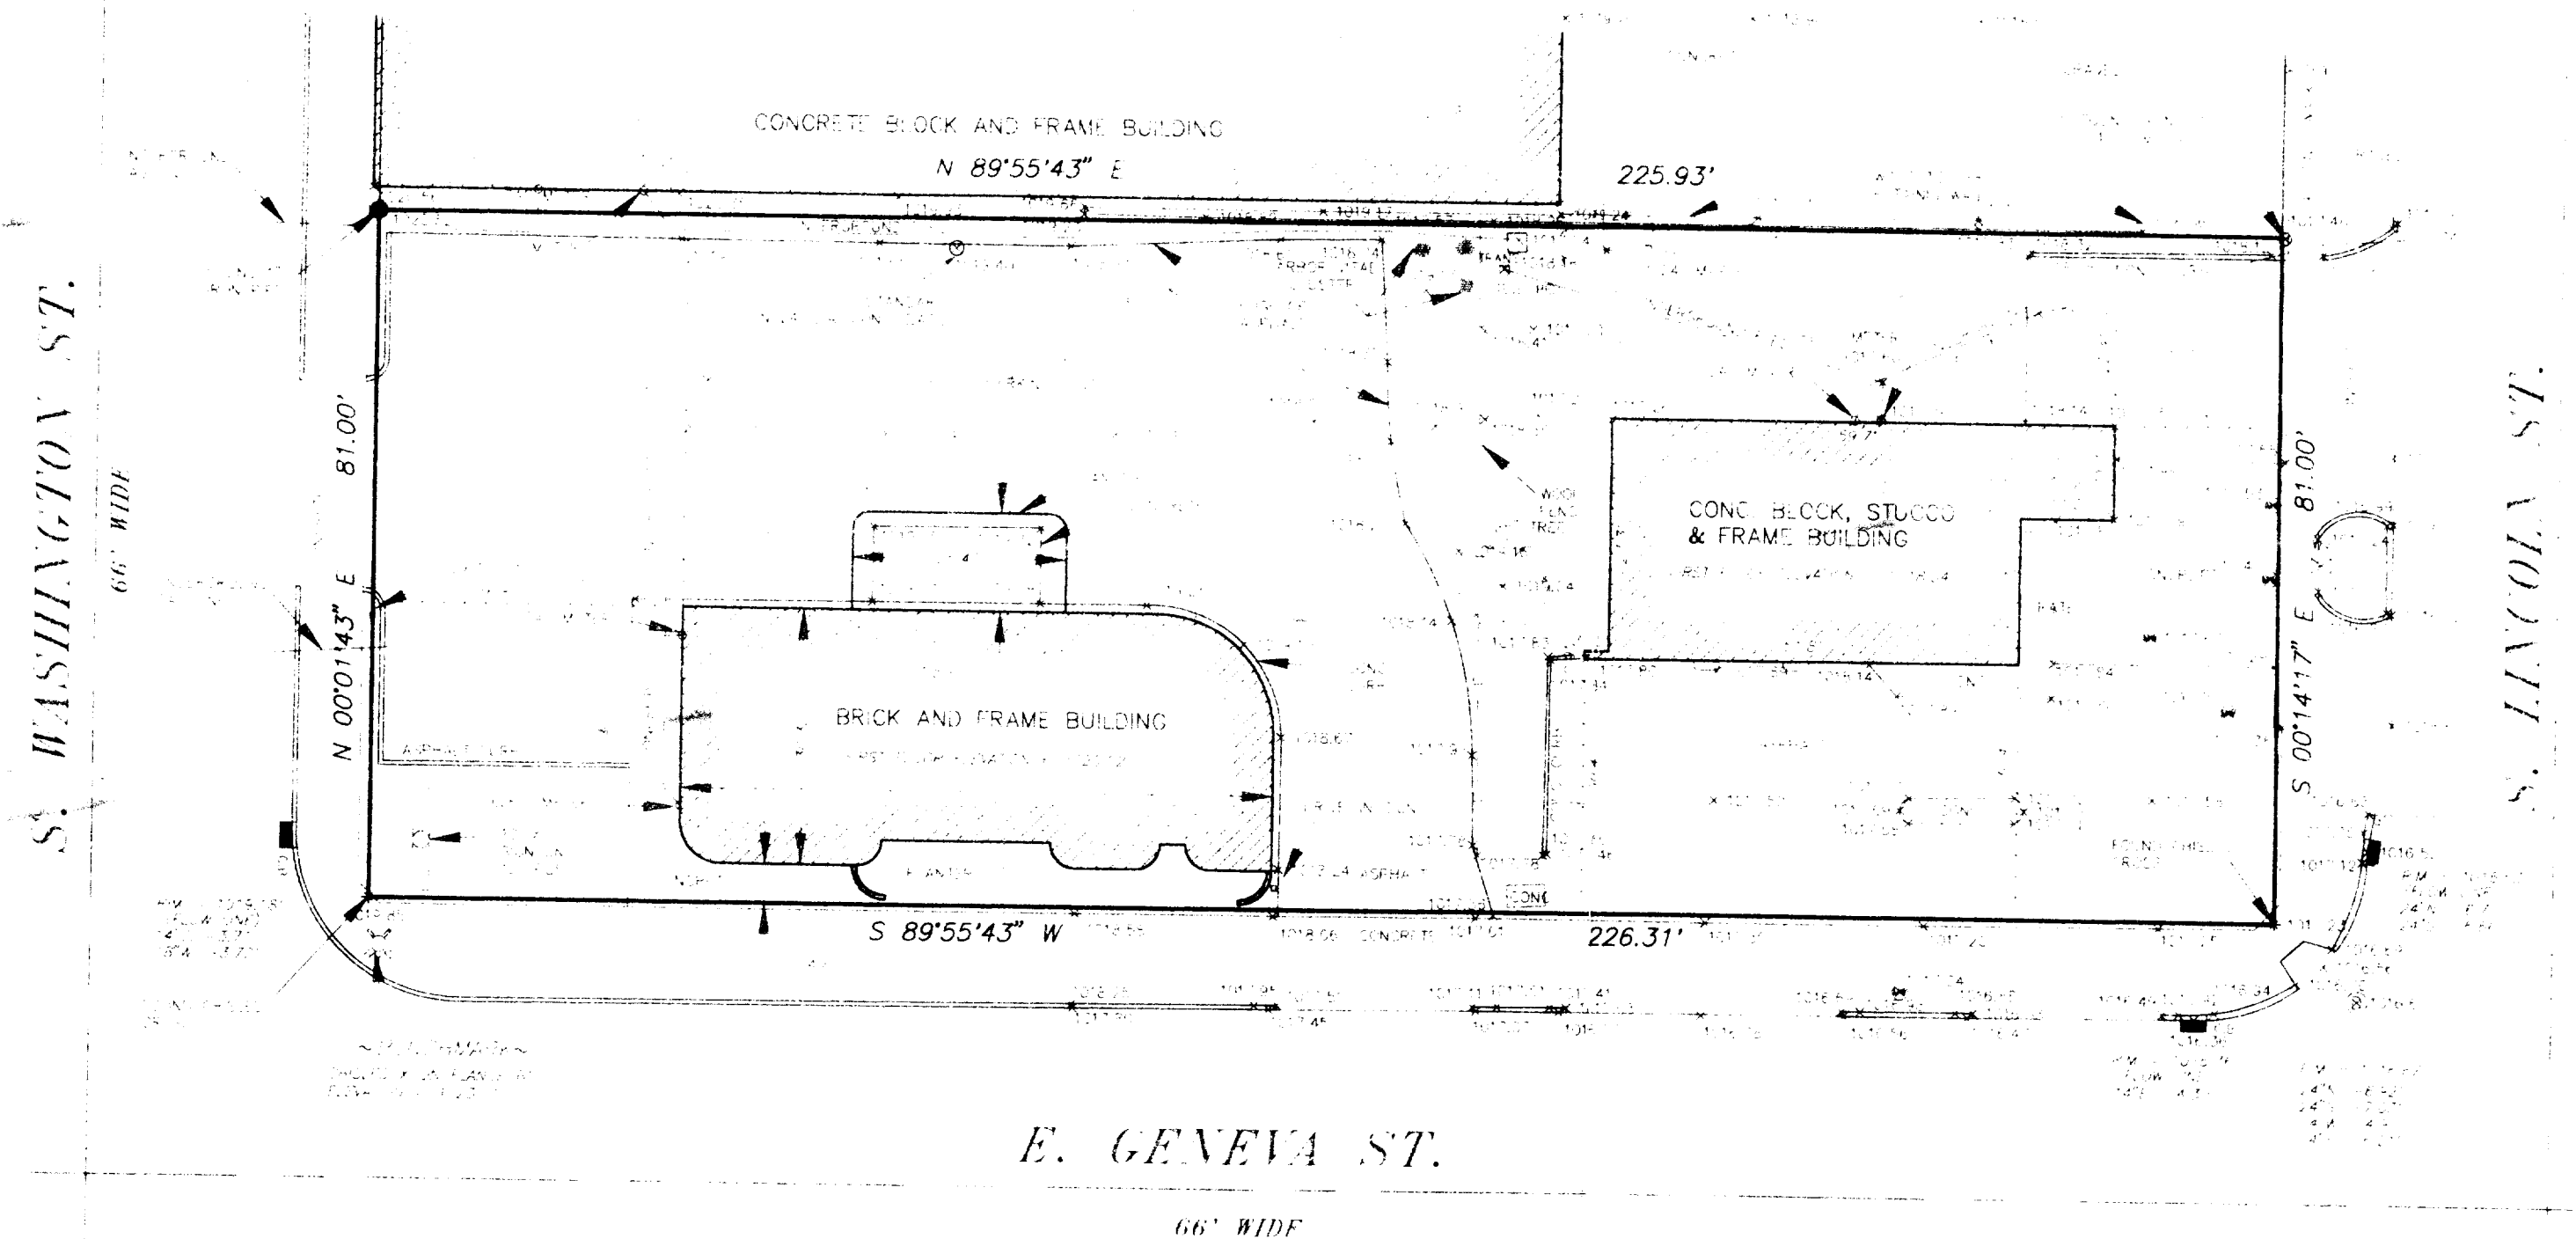

RECEIVED
APR 9 1967



STATE OF MISSISSIPPI
FACINE COUNTY

WHEREBY CERTIFY THAT I HAVE SURVEYED THE ABOVE DESCRIBED PROPERTY AND THE ABOVE MAP IS A TRUE REPRESENTATION OF THE BOUND AND CORNER, THE SIZE AND LOCATION OF THE PROPERTY, THE LOCATION OF ALL ADJACENT STRUCTURES AND DIMENSION OF ALL PRINCIPAL BUILDINGS THEREON, LOCATION OF ALL EASEMENTS, ADJACENTS, ROADWAY AND VISIBLE ENCROACHMENTS, IF ANY.

THIS SURVEY IS MADE FOR THE PRESENT OWNERS OF THE PROPERTY AND ALSO THOSE WHO PURCHASE, OR GUARANTEE THE TITLE HEREON.

DATED AT THE WATERFORD 11TH DAY OF MARCH 1977

SUBSCRIBED: *John B. B. B.*

- ~ LEGEND ~
- | | |
|---|-----------------------------------|
|  | - DENOTES 1" DIA. IRON PIPE FOUND |
|  | - DENOTES 3/4" DIA. REBAR FOUND |
|  | - DENOTES CHISELED CROSS FOUND |
|  | - DENOTES STORM MANHOLE |
|  | - DENOTES STORM CATCH BASIN |
|  | - DENOTES MONITORING WELL |
|  | - DENOTES WOOD FENCE |
| X 1023.01' | - DENOTES SPOT ELEVATIONS |
| TELE. PED. | - DENOTES ELECTRIC PEDESTAL |
| ELEC. PED. | - DENOTES TELEPHONE TRANSFORMER |
|  | - DENOTES PAINTED GAS LINE |
|  | - DENOTES PAINTED ELECTRIC LINE |
|  | - DENOTES FIRE HYDRANT |
|  | - DENOTES WATER VALVE |

40P-190

64-1034