

WALWORTH COUNTY
SURVEYING & MAPPING
P. O. BOX 1115
LAKE GENEVA, WISCONSIN
414-248-0505

PLAT OF SURVEY OF

TAX KEY NO. U-NW-19, PART OF THE NORTHEAST
1/4 OF SECTION 36, T 3 N, R 16 E, CITY OF ELKHORN,
WALWORTH COUNTY, WISCONSIN.

ORDERED BY: TRIAD ENGINEERING INC.
325 WEST CHICAGO STREET
MILWAUKEE, WISCONSIN
53202

GRAPHIC SCALE



(IN FEET)
1 inch = 60 ft.

- IRON PIPE FOUND
- IRON ROD FOUND
- CONCRETE MONUMENT FOUND
- IRON PIPE PLACED
- ()-RECORDED AS
- ⊙-MONITOR WELL
- ⊕-UTILITY POLE
- △-NEW WELL SITE
- OVERHEAD UTILITY LINES
- BORING HOLE



I HEREBY CERTIFY THAT I HAVE SURVEYED THE ABOVE DESCRIBED
PROPERTY AND THAT THE ABOVE MAP IS A TRUE REPRESENTATION
THEREOF AND SHOWS THE SIZE AND LOCATION OF THE PROPERTY,
ITS EXTERIOR BOUNDARIES, THE LOCATION OF ALL VISIBLE STRUCTURES
AND DIMENSIONS OF ALL PRINCIPAL BUILDINGS THEREON, BOUNDARY
FENCES, APPARENT EASEMENTS, ROADWAYS AND VISIBLE ENCROACH-
MENTS, IF ANY, TO THE BEST OF MY KNOWLEDGE AND BELIEF.

THIS SURVEY IS MADE FOR THE USE OF THE PRESENT OWNERS OF
THE PROPERTY AND ALSO THOSE WHO PURCHASE, MORTGAGE OR
GUARANTEE THE TITLE THEREON WITHIN ONE (1) YEAR FROM DATE
HEREOF.

Robert M. Baerewald
ROBERT M. BAEREWALD
WISCONSIN REGISTERED LAND SURVEYOR S-1508

DATE: Feb 22, 1996
JOB NO. 4884

NOTE: THIS IS NOT A CERTIFIED COPY UNLESS SEALED.

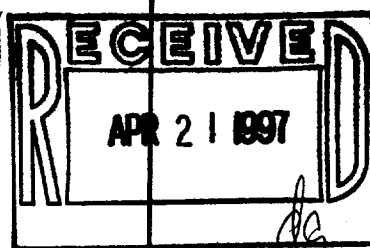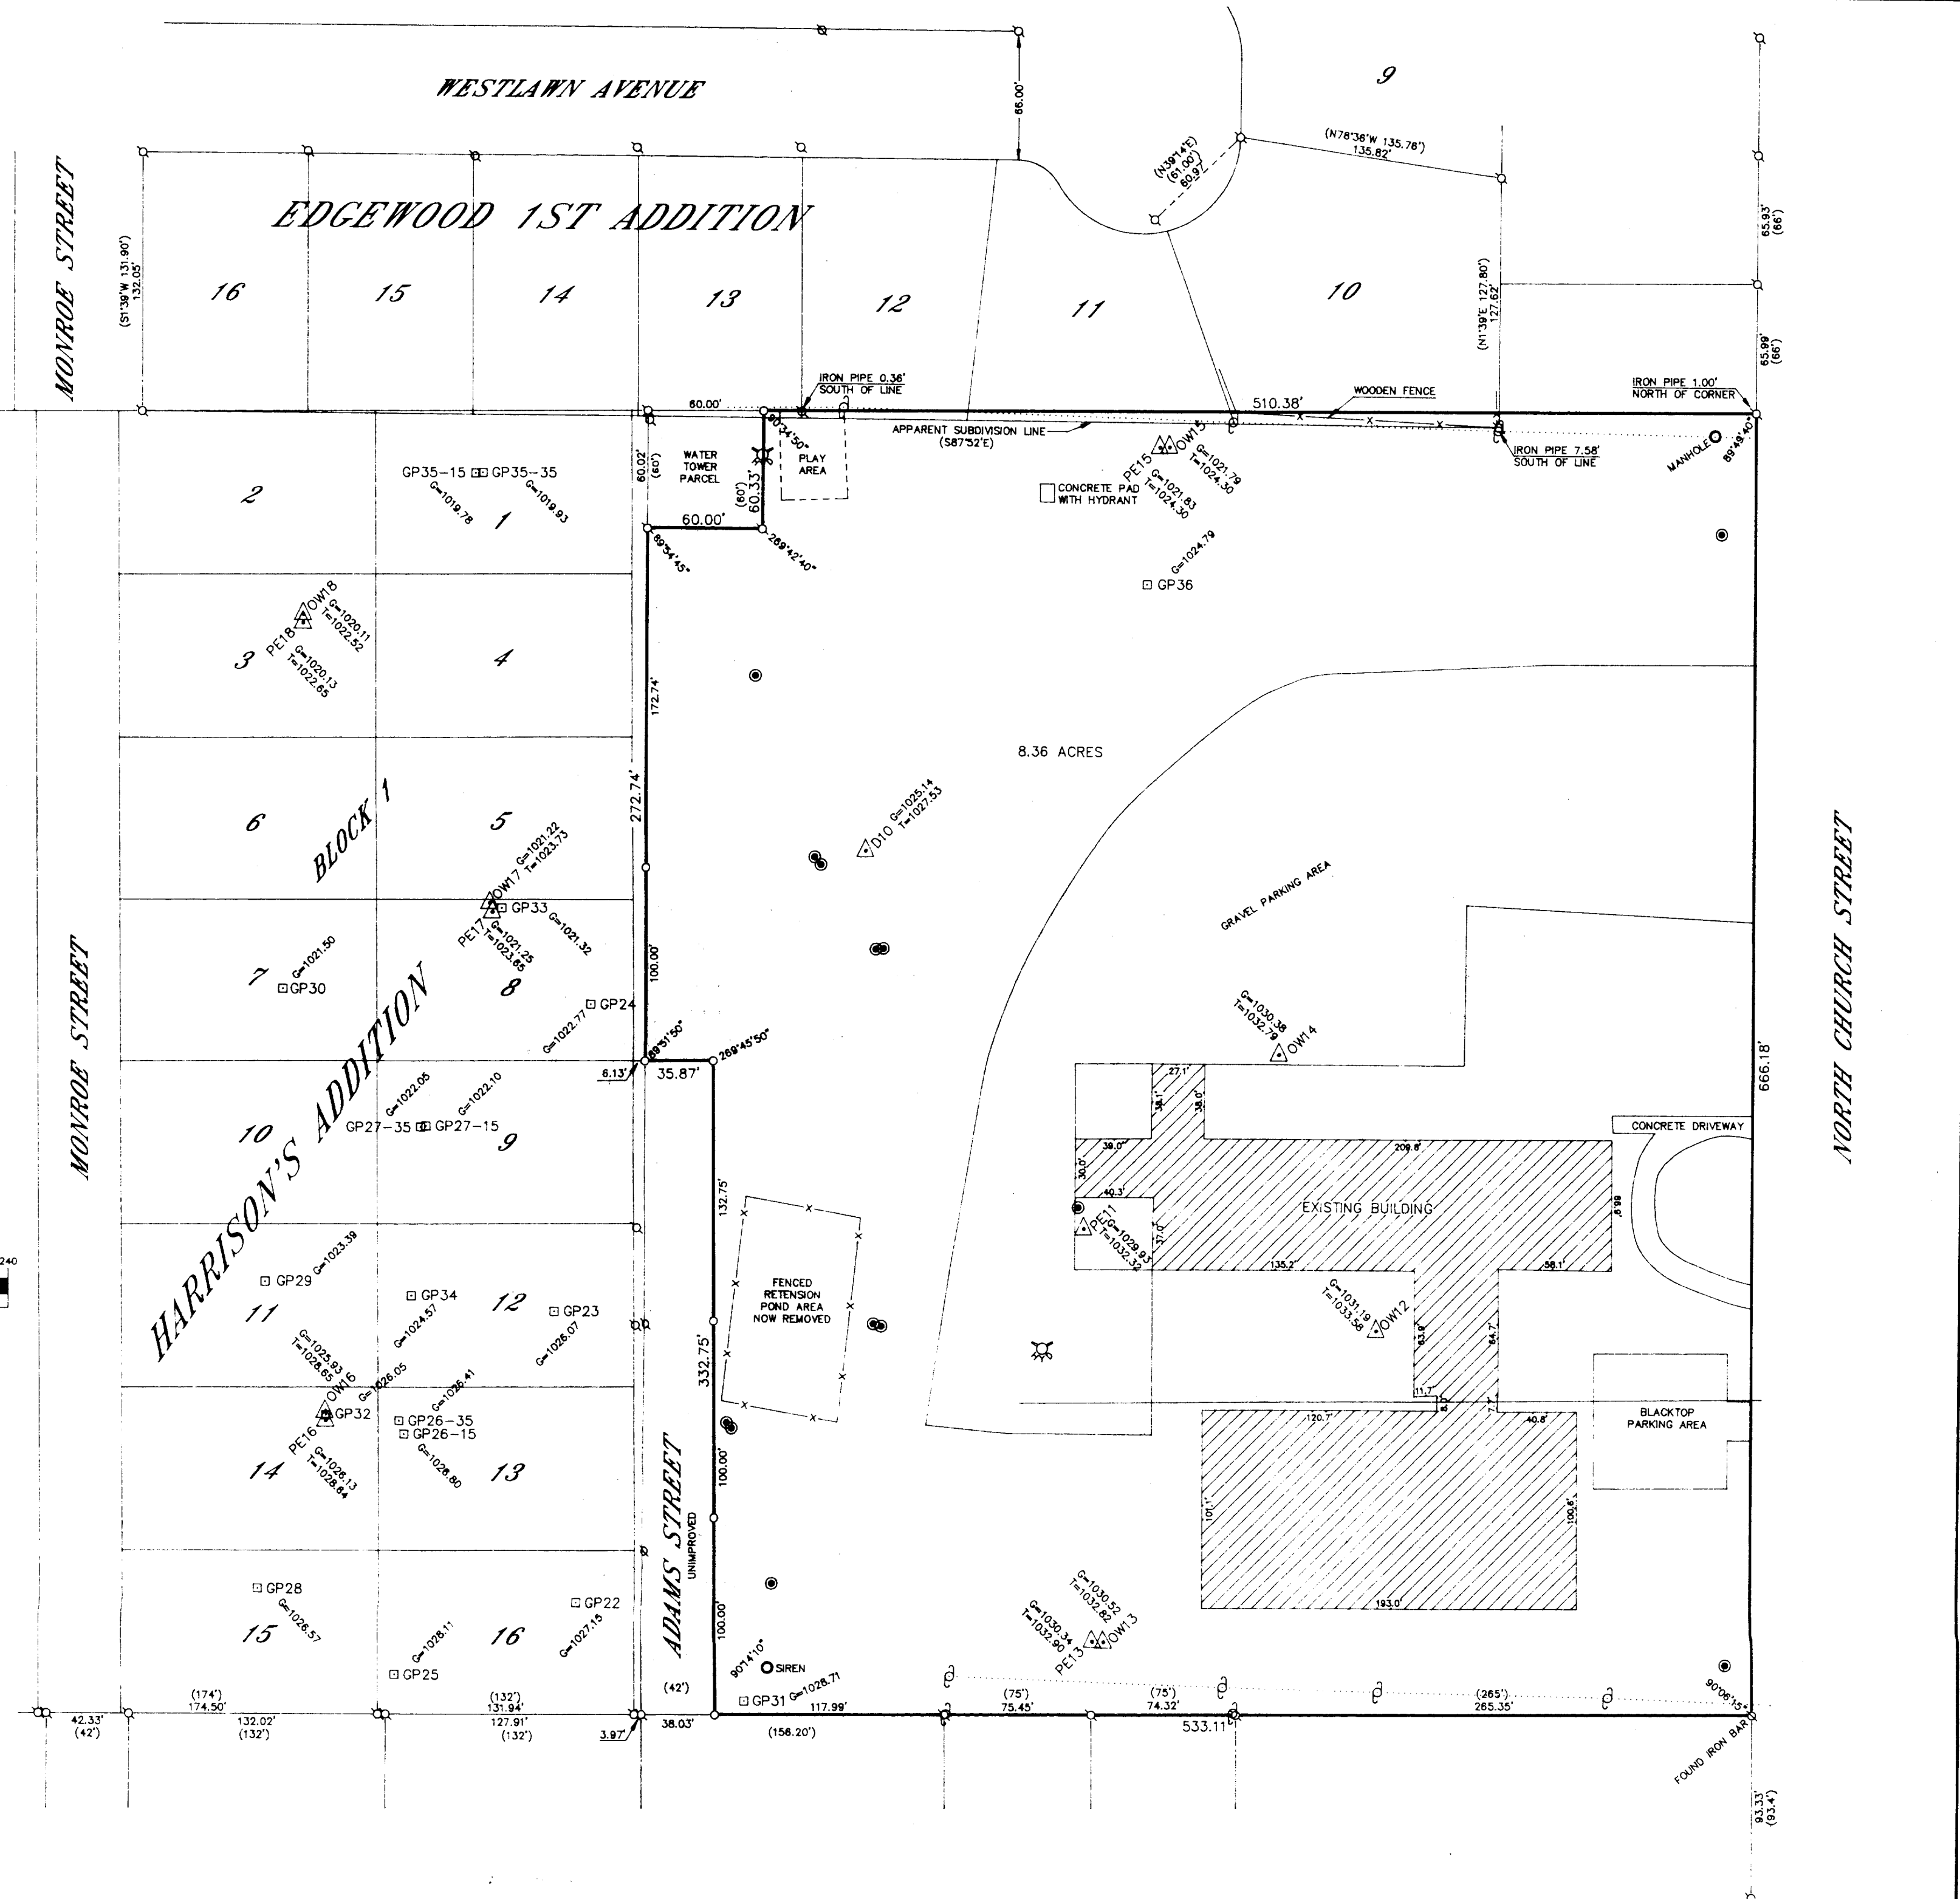

UNW-19
14-1035