


NORTH
IRON STAKE

NORTH WISCONSIN ST.

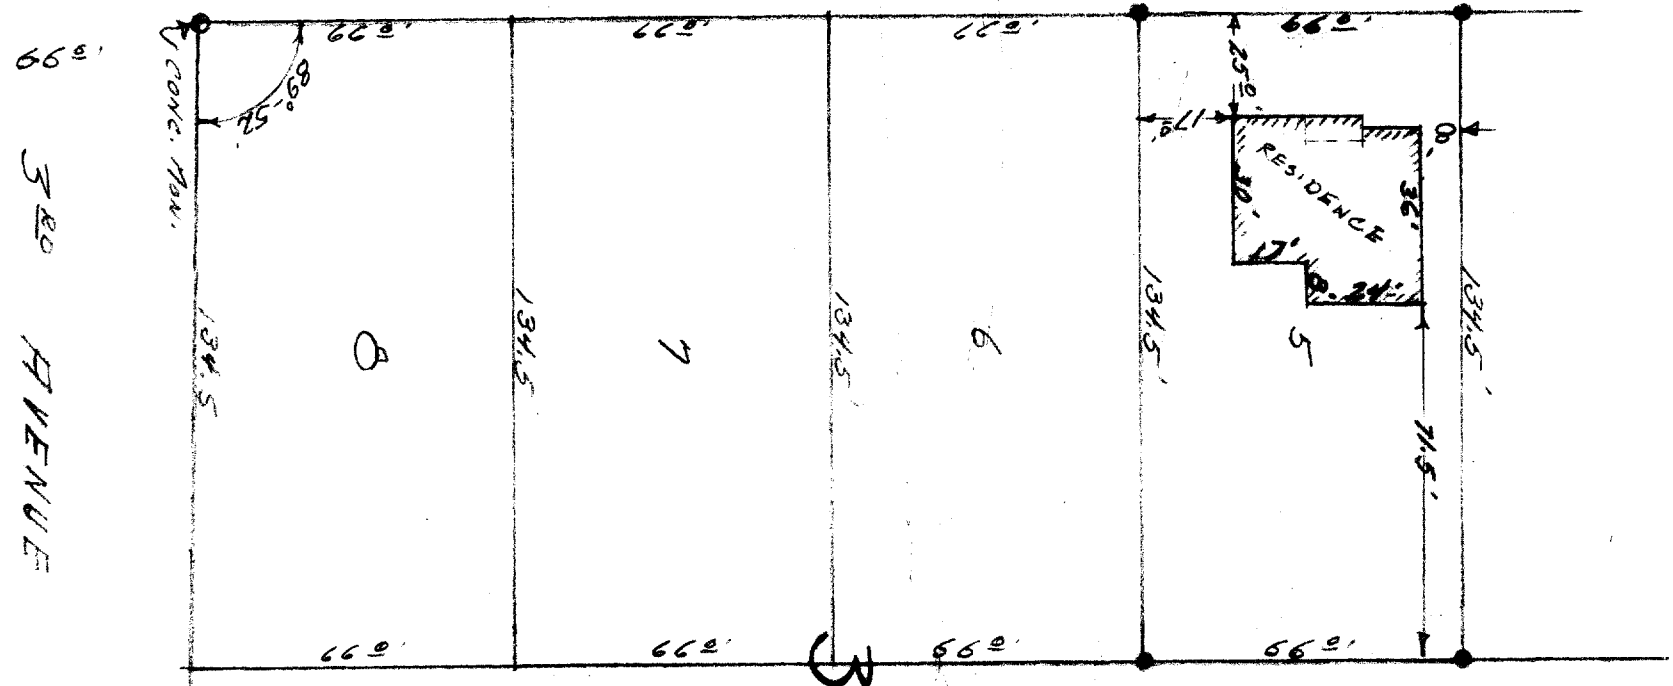


DESCRIPTION: Lot 5, Block 3, of Holton Heights Subdivision of a portion of the City of Elkhorn, Walworth County, Wisconsin. Otherwise known as 609 North Wisconsin Street, Elkhorn, Wisconsin.

CERTIFICATE: I, James F. Biagi, Surveyor, do hereby certify that I have surveyed the property hereon described, and that the location of the improvements on said property are as shown.

SIGNED AND SEALED ON THIS THE 9TH DAY OF JUNE 1960.

James F. Biagi, RLS (272)
Elkhorn Wisconsin.

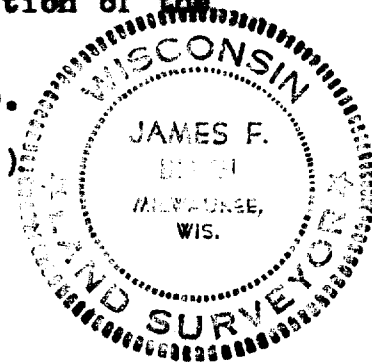

10-24

YHT-350

4-103B

4-103B