


PLAT OF SURVEY

LEGAL DESCRIPTION:

A parcel of land located in the Southwest 1/4 and the Southeast 1/4 of the Northeast 1/4 of Section 25, Town 3 North, Range 16 East, City of Elkhorn, Walworth County, Wisconsin; described as follows: Commence at the East 1/4 corner of said Section 25, thence S 88°26'57" W, along the south line of the Northeast 1/4 of said Section, 738.44 feet; thence N 1°31'19" W 40.00 feet to a found iron rod and the point of beginning; thence S 88°26'57" W, along the northerly line of Market Street, 568.44 feet to a set iron rod; thence N 1°33'03" W 99.84 feet to a found iron pipe; thence S 88°26'57" W 33.00 feet to a set iron rod; thence N 1°33'03" W 204.06 feet to set iron rod; thence along the arc of curve to the right 66.60 feet, having a radius of 475.00 feet and a central angle of 8°02'00" whose chord bears N 27°57' E 66.54 feet to a set iron rod; thence N 6°28'57" E 108.50 feet to a set iron rod; thence along the arc of a curve to the left, 65.50 feet, having a radius of 467.00 feet and a central angle of 8°02'10" whose chord bears N 2°27'52" E 85.45 feet to a set iron rod; thence N 1°33'13" W 122.24 feet to a set iron rod; thence N 89°01'16" E along the southerly line of Hidden Trail, 13.74 feet to a set iron rod; thence along the arc of a curve to the left, 18.11 feet, having a radius of 283.00 feet and a central angle of 3°40'01" whose chord bears N 87°11'15.5" E 18.11 feet to a found iron pipe; thence N 0°58'44" W 66.18 feet to a set iron rod; thence along the arc of a curve to the left, 50.67 feet, having a radius of 217.00 feet and a central angle of 13°22'47" whose chord bears N 77°32'47.5" E 50.56 feet to a set iron rod; thence N 19°33'04" W 118.70 feet to a found iron pipe; thence N 60°34'12" E 162.90 feet to a found iron pipe; thence N 64°44'07" E 46.56 feet to a found iron pipe; thence S 66°38'14" E 75.71 feet to a found iron pipe; thence N 18°21'44" W 110.66 feet to a found iron pipe; thence N 1°34'15" W 262.76 feet to a found iron pipe; thence N 88°25'45" E, along the north line of the South 1/2 of the Northeast 1/4 of said Section 25, 308.90 feet to a found iron pipe; thence S 1°31'46" E 1285.90 feet to the point of beginning. Said parcel contains 14.56 acres of land more or less.

OWNERS: KENNEDY PROPERTIES OF WISCONSIN
3721 VENTURA DRIVE SUITE 100
ARLINGTON HEIGHTS, IL. 60004

BUYER: DR. KHANG - CHENG HO
16235 WILDWOOD CT.
BROOKFIELD, WI. 53005

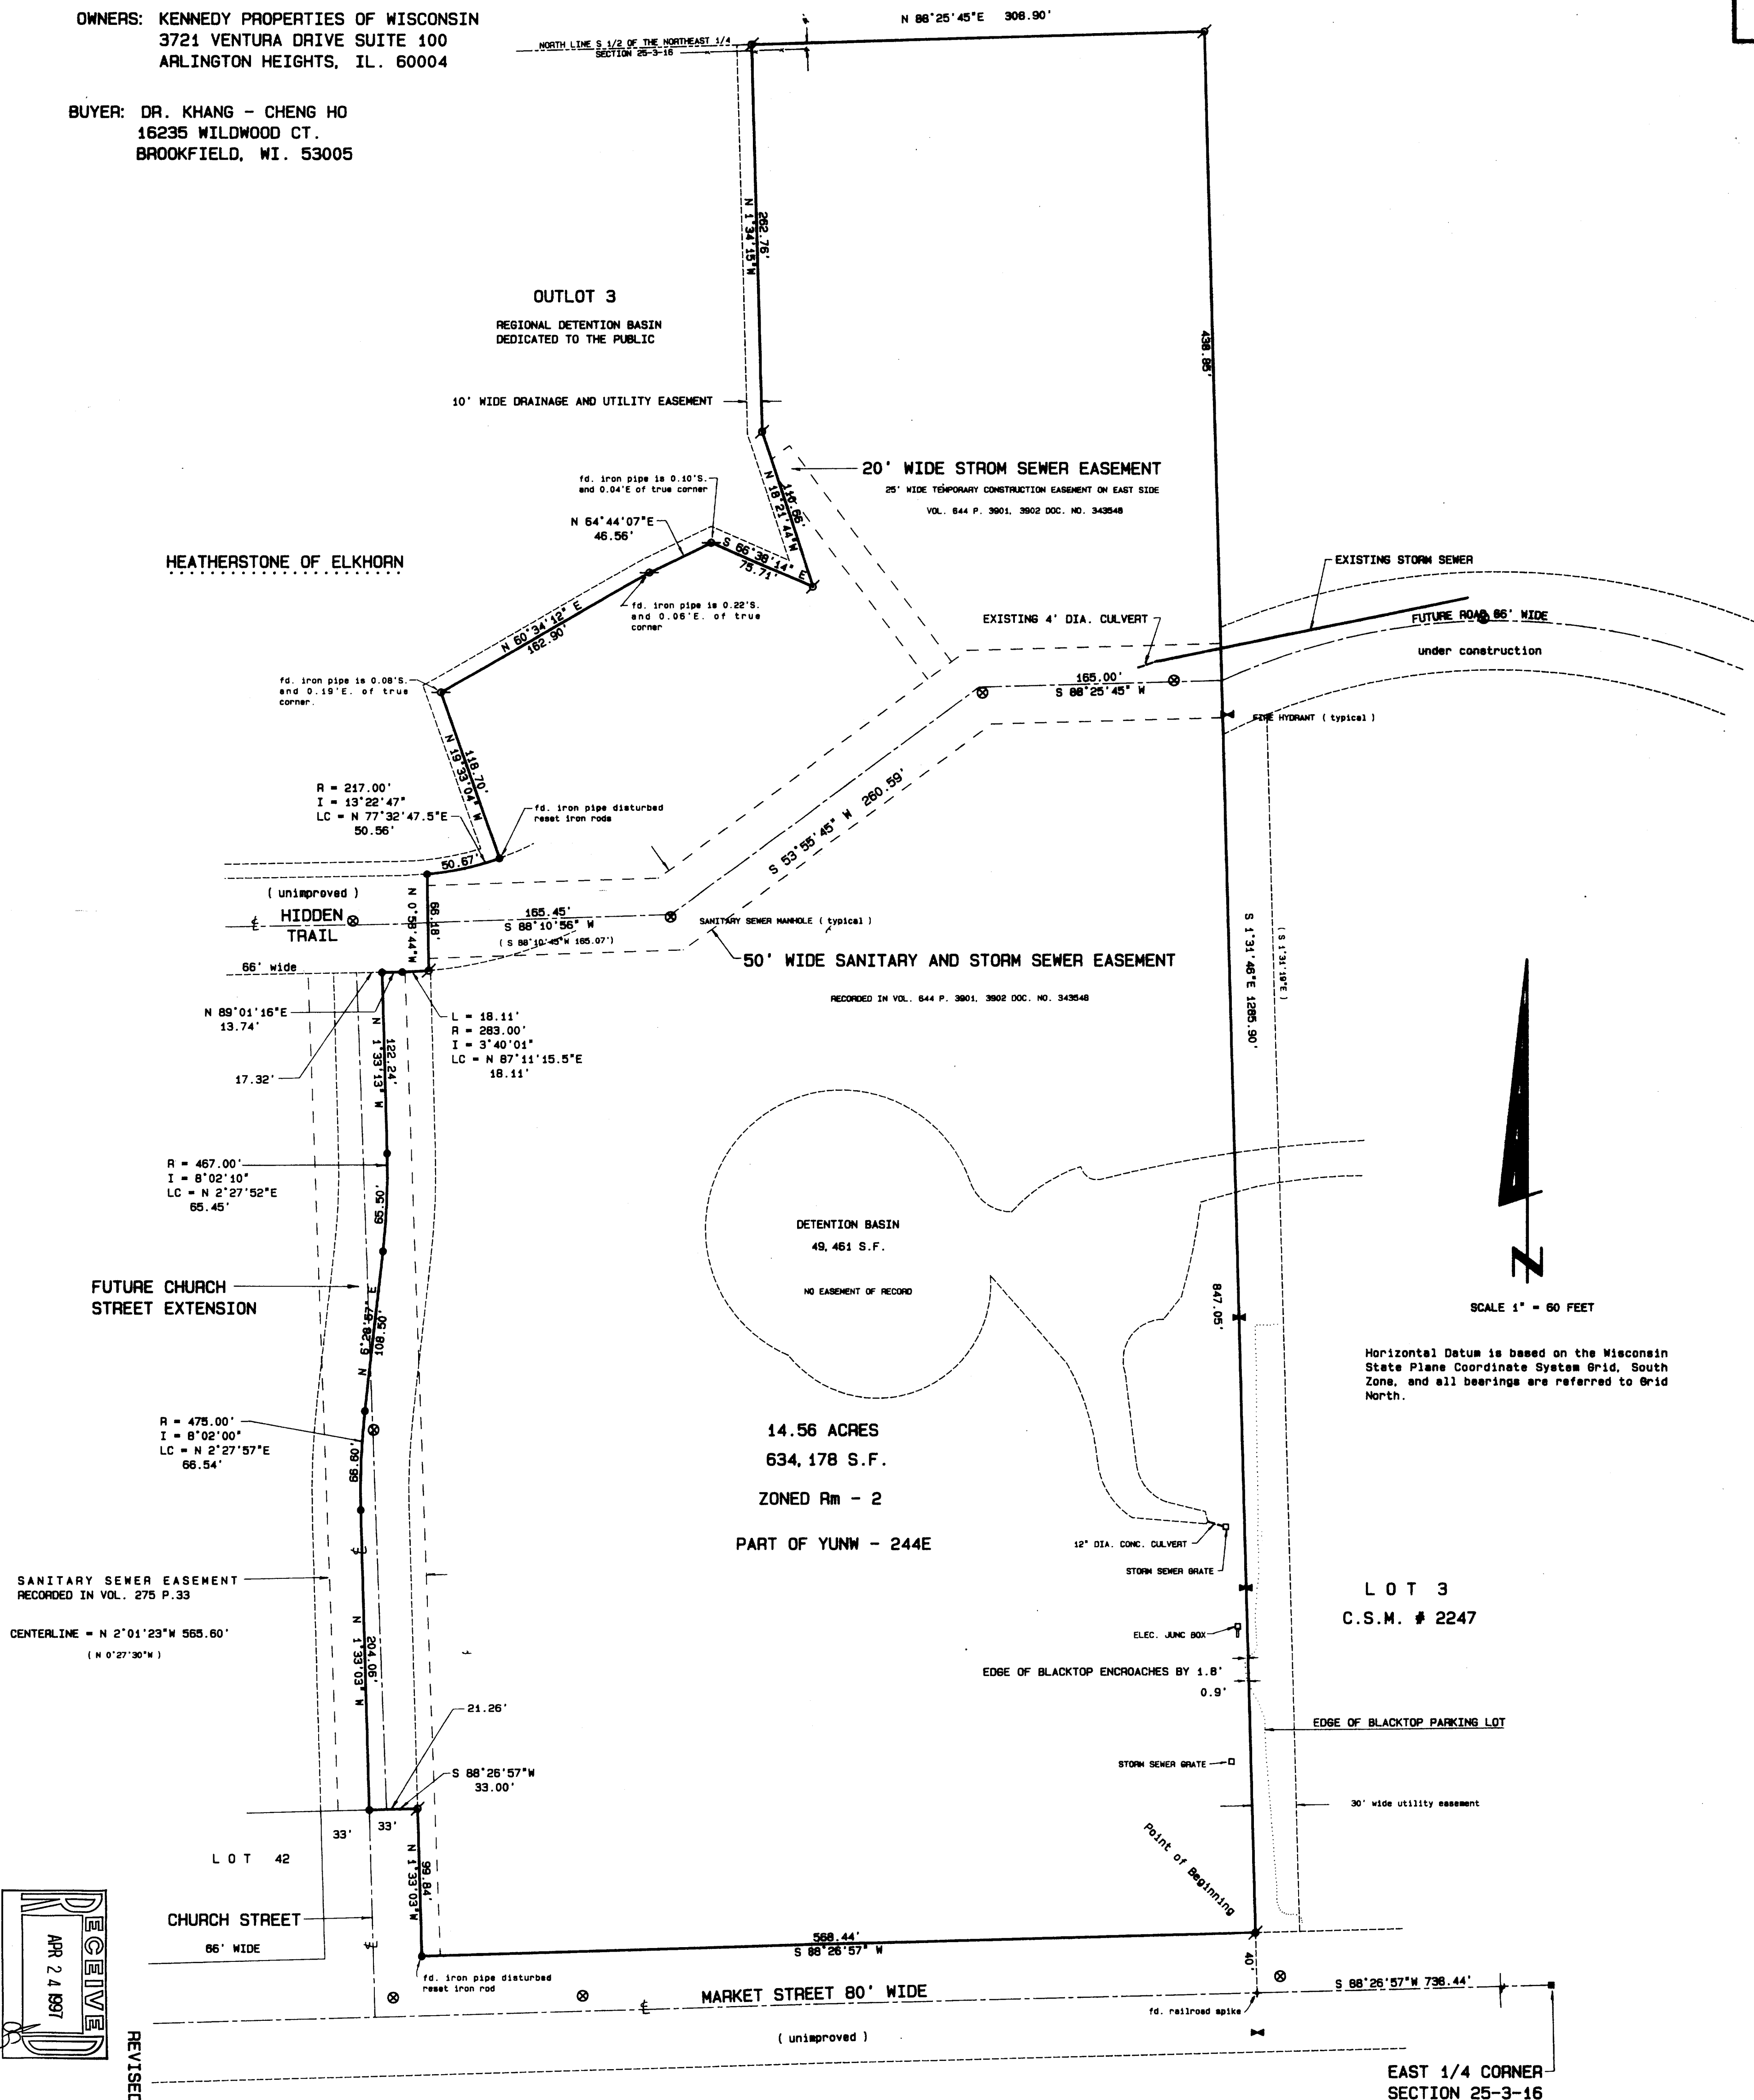

SCALE 1" = 60 FEET

Horizontal Datum is based on the Wisconsin State Plane Coordinate System Grid, South Zone, and all bearings are referred to Grid North.

RECEIVED
APR 24 1997

REVISÉ 2/25/97

SCALE: 1" = 60 FEET

Legend

-  FOUND IRON PIPE
-  FOUND IRON ROD
-  FOUND BRASS CAPPED MONUMENT
-  FOUND CONCRETE MONUMENT
-  CHISEL CUT IN CONCRETE
-  SET IRON ROD, 24" LONG, WEICHMINN 1.5 LBS. LINEAL FT., 3/8" DIA.
-  SET IRON ROD, 30" LONG, WEICHMINN 4.5 LBS. LINEAL FT., 1 11/16" DIA.
-  RECORDED AS DIMENSION
-  EXISTING FENCE

[illegible]

YUNW-244E
004-1041