
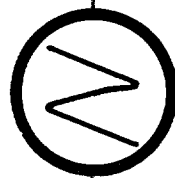


NORTH BROAD STREET

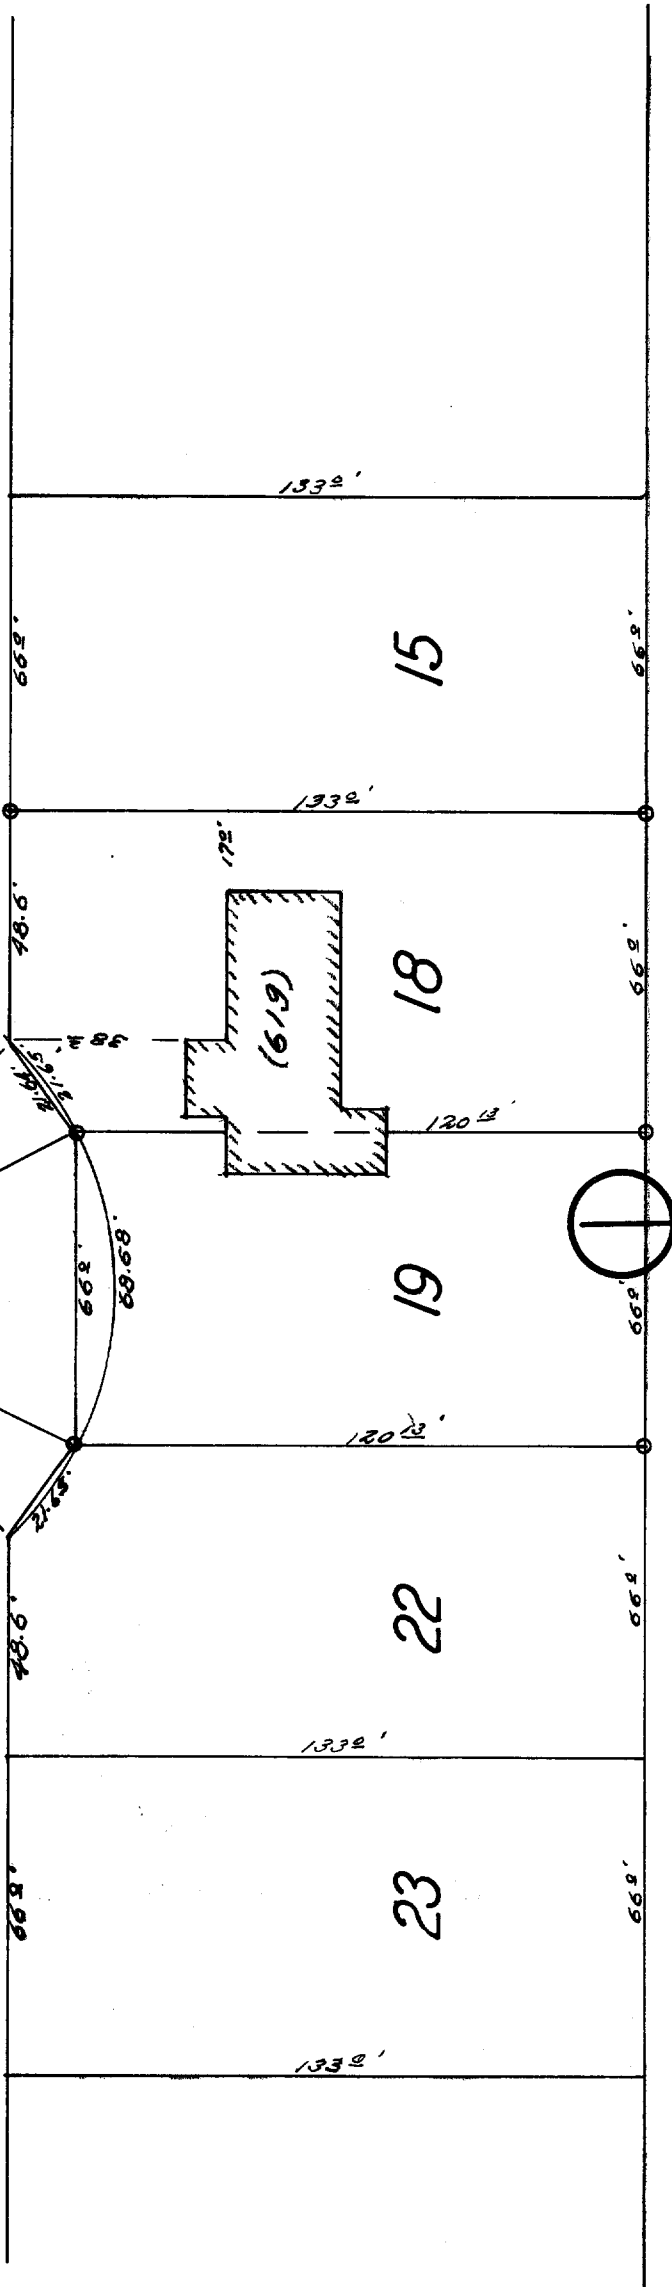

o IRON STAKES

DESCRIPTION:

Lots 18 and 19, Block 1, Holton Heights Addition to the City of Elkhorn, Walworth County, Wisconsin.

CERTIFICATE:

I, hereby certify that I, have on this the 13th day of November 1950, surveyed the above described property, according to the official records on file in the office of the Recorder of Deeds in and for Walworth County, Wisconsin, and find that the measurements and bearings of the boundary lines of said property as taken at the site on this day, substantially agree with those in said official record and that no encroachments exist, and that a further survey was made by me on the 13th day of January, 1951, locating all buildings on the above described property, and the above portrayed plat is a correct representation of the buildings as located upon the lots on this day.

SIGNED AND SEALED ON THIS THE 15TH DAY OF JANUARY 1951.

Joseph M. Biagi
Joseph M. Biagi, Professional Engineer.
Elkhorn Wisconsin.