


#207-70

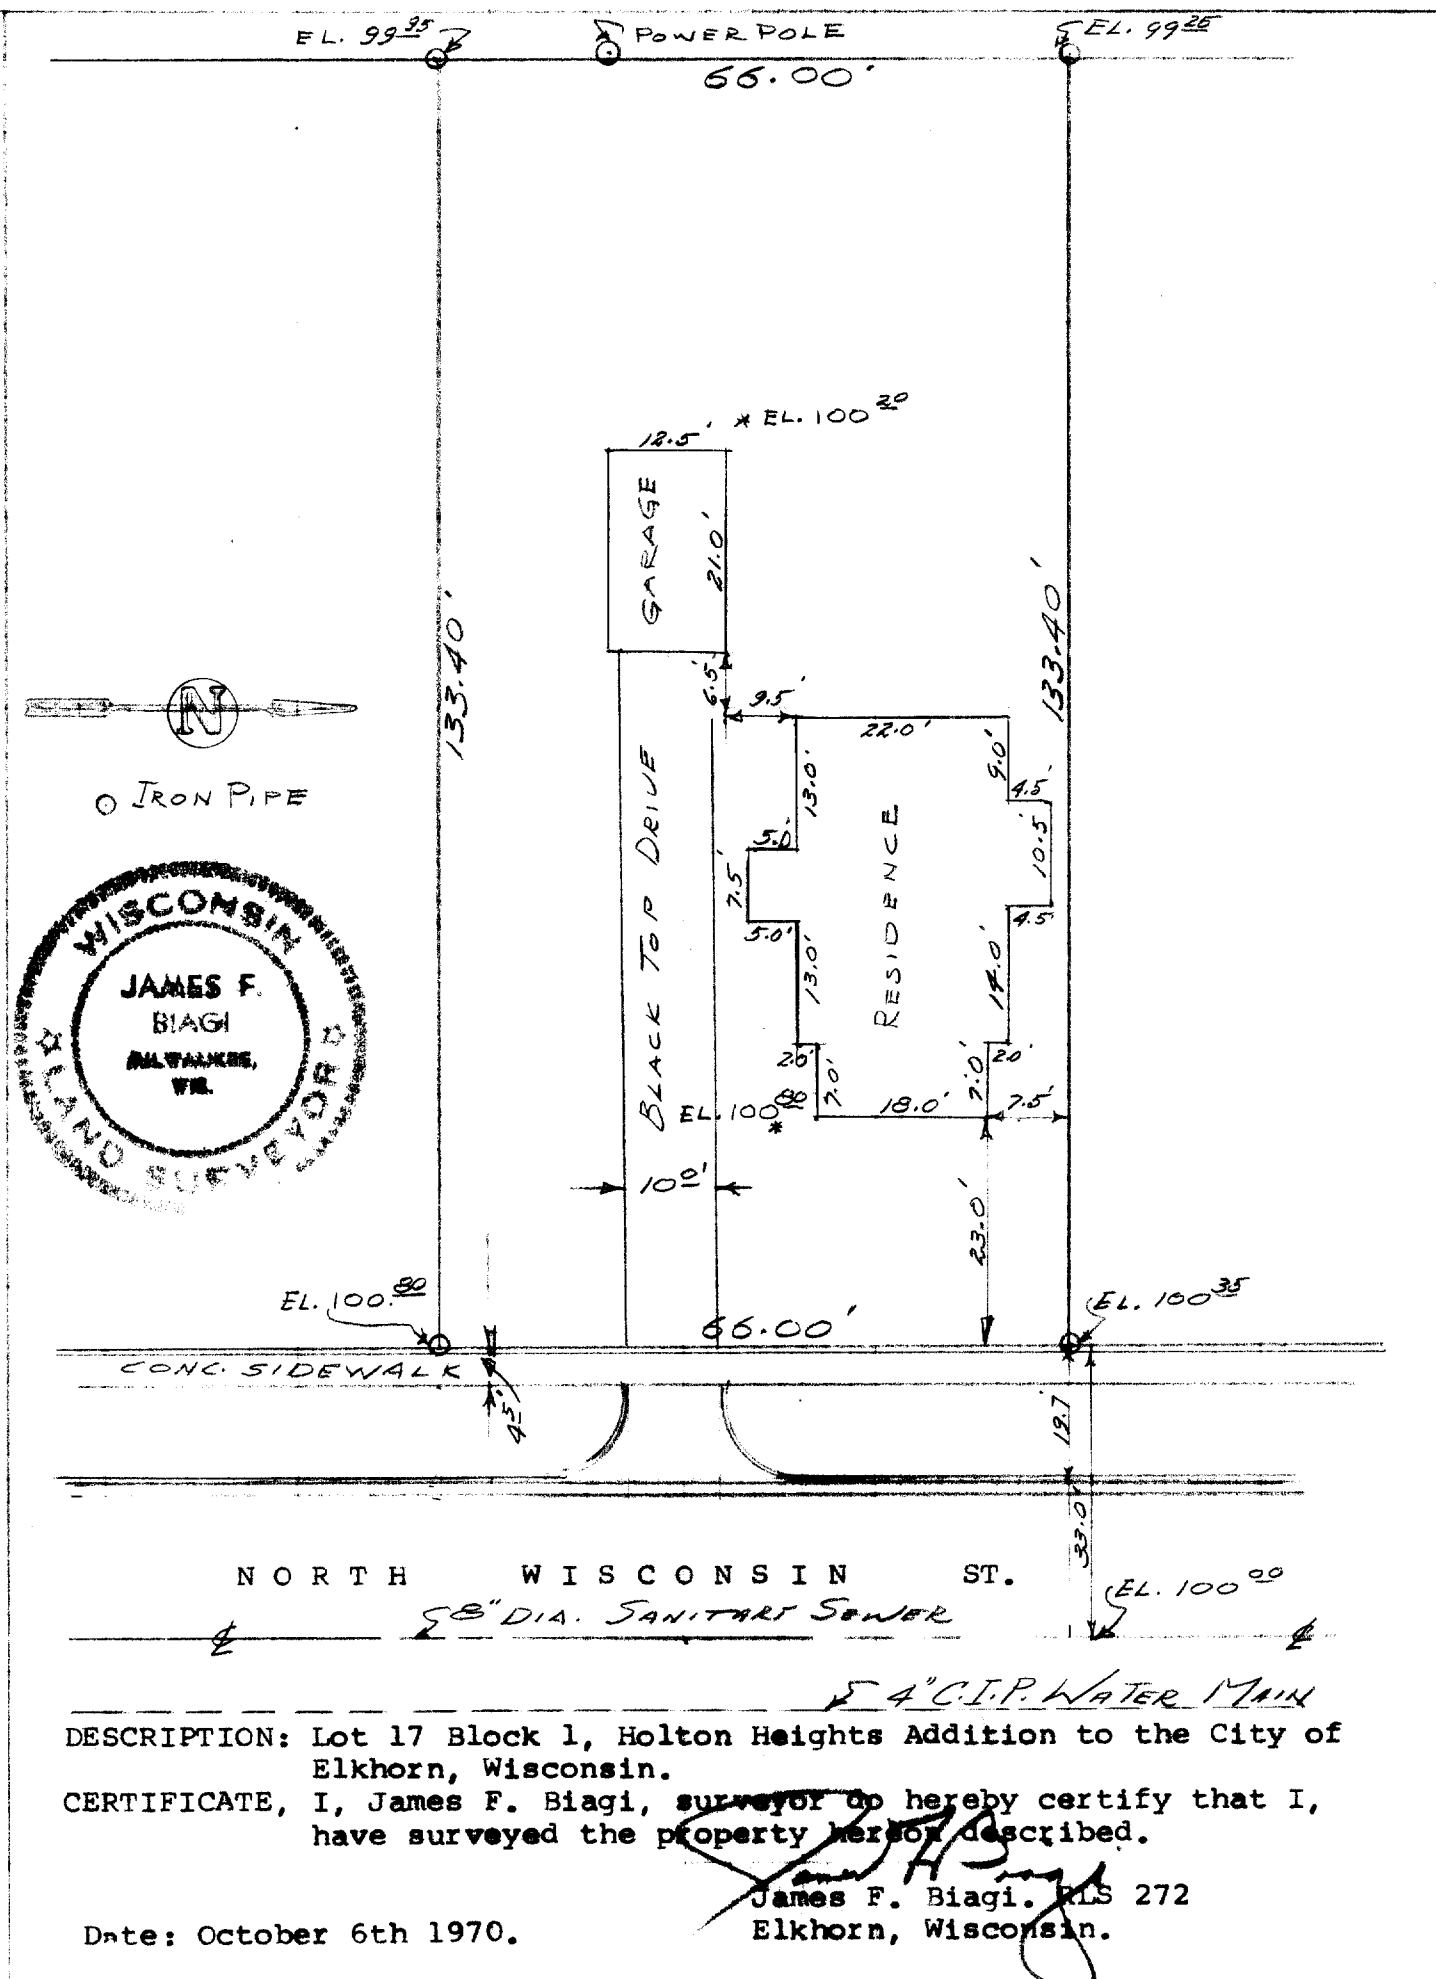

YHT-7

4-105B